NOTES BY SYMBOL

ROUTE CIRCUIT THROUGH CONTACTOR INDICATED ON DETAIL 2:E6.1.

CONNECT FIXTURE TO LIGHTING INVERTER IN MECH 105 FOR EMERGENCY

CABLING. COORDINATE ALL WORK WITH PLUMBING CONTRACTOR.

TIMECLOCK AND CONTACTORS FOR EXTERIOR LIGHTING AND OFFICE

8 PHOTOCELL FOR CONTROL OF EXTERIOR LIGHTS. SEE 2:E6.1 FOR MORE

CONNECTION TO BLOWER COIL/ELECTRIC HEAT.

CONNECTION TO BLOWER COIL/ELECTRIC HEAT.

RECEPTACLE CONTROL, RE: 2:E6.1.

INFORMATION.

PROVIDE 30A/2P, SINGLE THROW, MANUAL MOTOR CONTROLLER SNAP SWITCH IN NEMA 1 ENCLOSURE. HUBBELL #HBL7832D OR EQUAL. MAKE FINAL FLEXIBLE

#8 CU BONDING JUMPER FROM CIRCUIT EQUIPMENT GROUNDING CONDUCTOR TO METAL SPRINKLER SYSTEM PIPING AT AN ACCESSIBLE LOCATION PER NEC 250.104(B). COORDINATE WORK WITH FIRE SPRINKLER SYSTEM INSTALLER. PROVIDE 120V POWER CONNECTION TO ELEVATOR SUMP PUMP ALARM PANEL

PROVIDE 50A/2P, SINGLE THROW, MANUAL MOTOR CONTROLLER SNAP SWITCH IN NEMA 1 ENCLOSURE. HUBBELL #HBL7852D OR EQUAL. MAKE FINAL FLEXIBLE

WEST RESIDENCE AT HERATIGE **FACILI NEW SENIOR LIVING** 

REVISIONS:


뿚


1 Addendum #1 03-04-2025

01-10-2025 24-3379

SHEET NO .:

E1.1

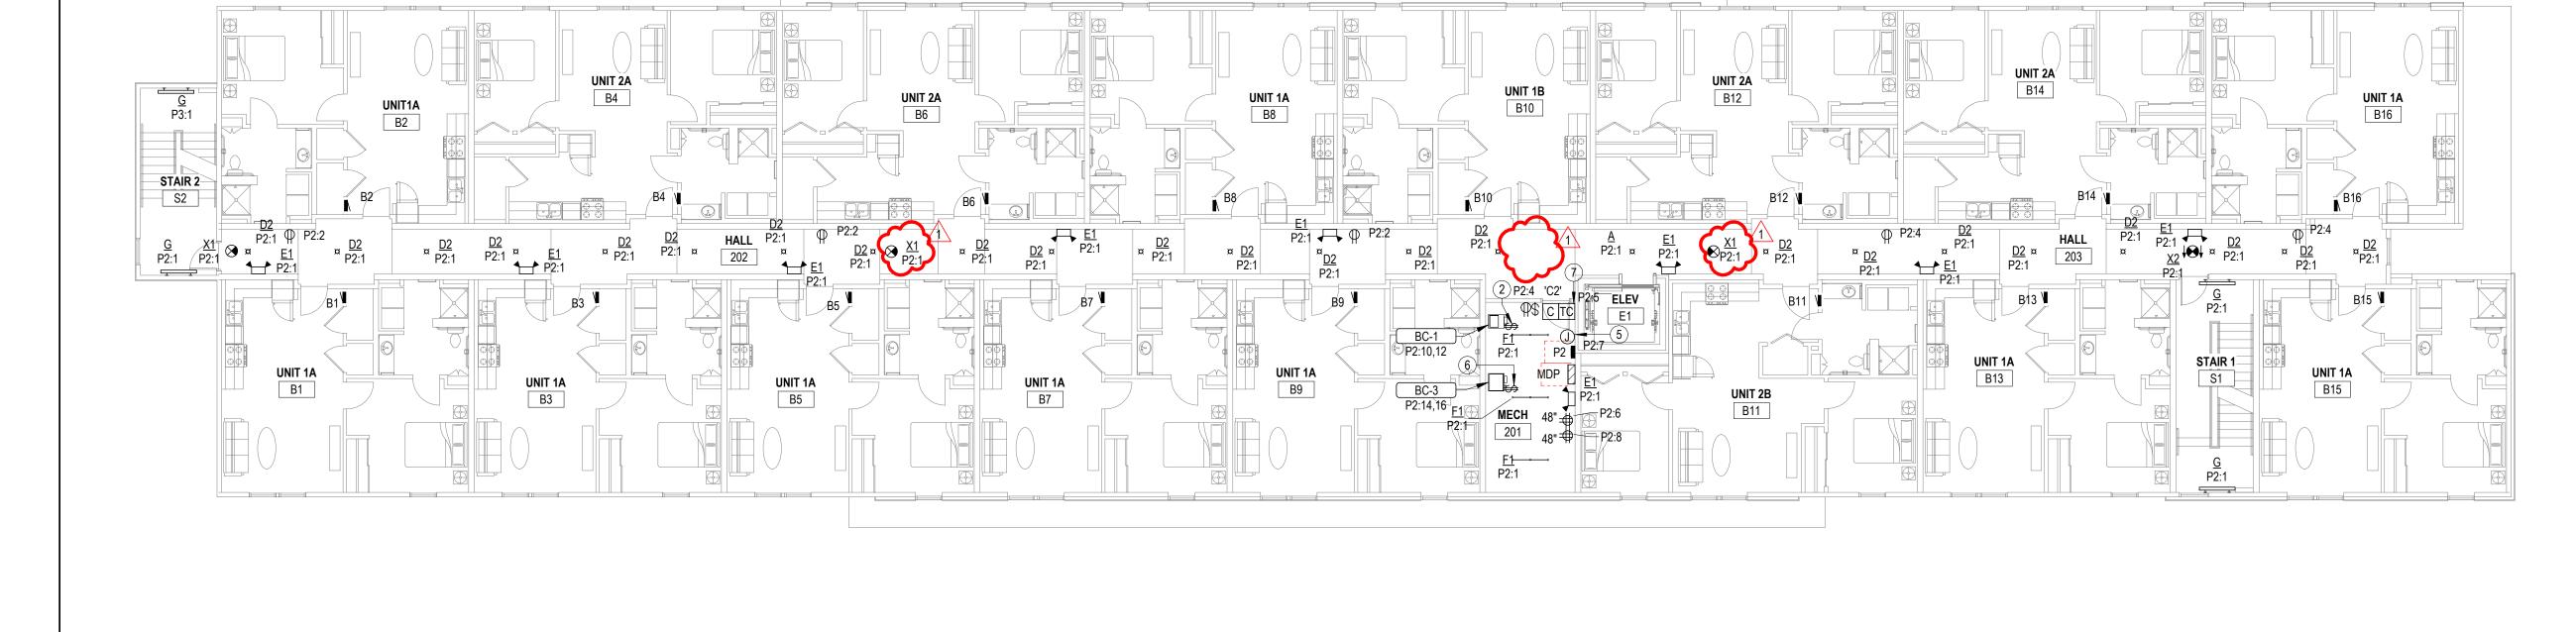


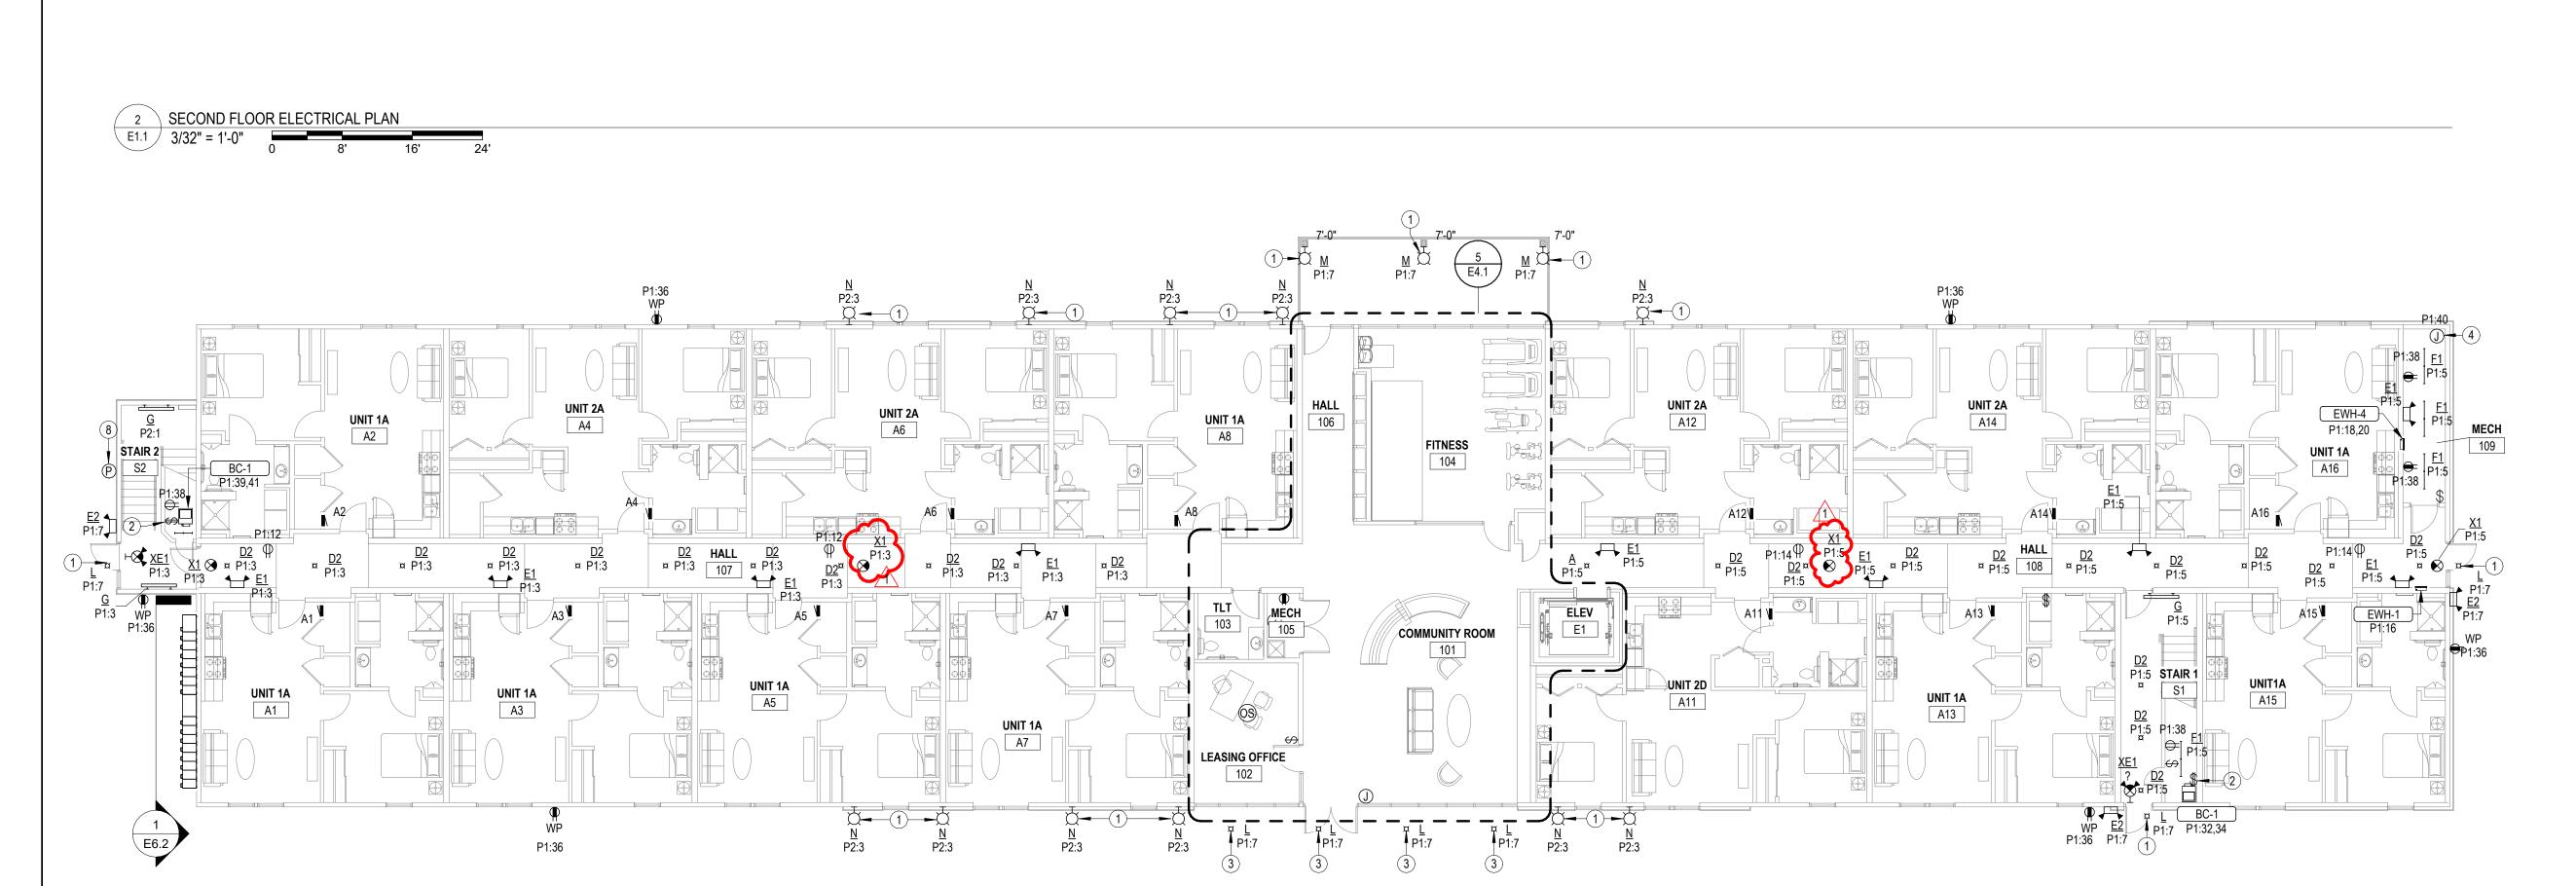

뿓

24-3379 SHEET NO .:

E1.2

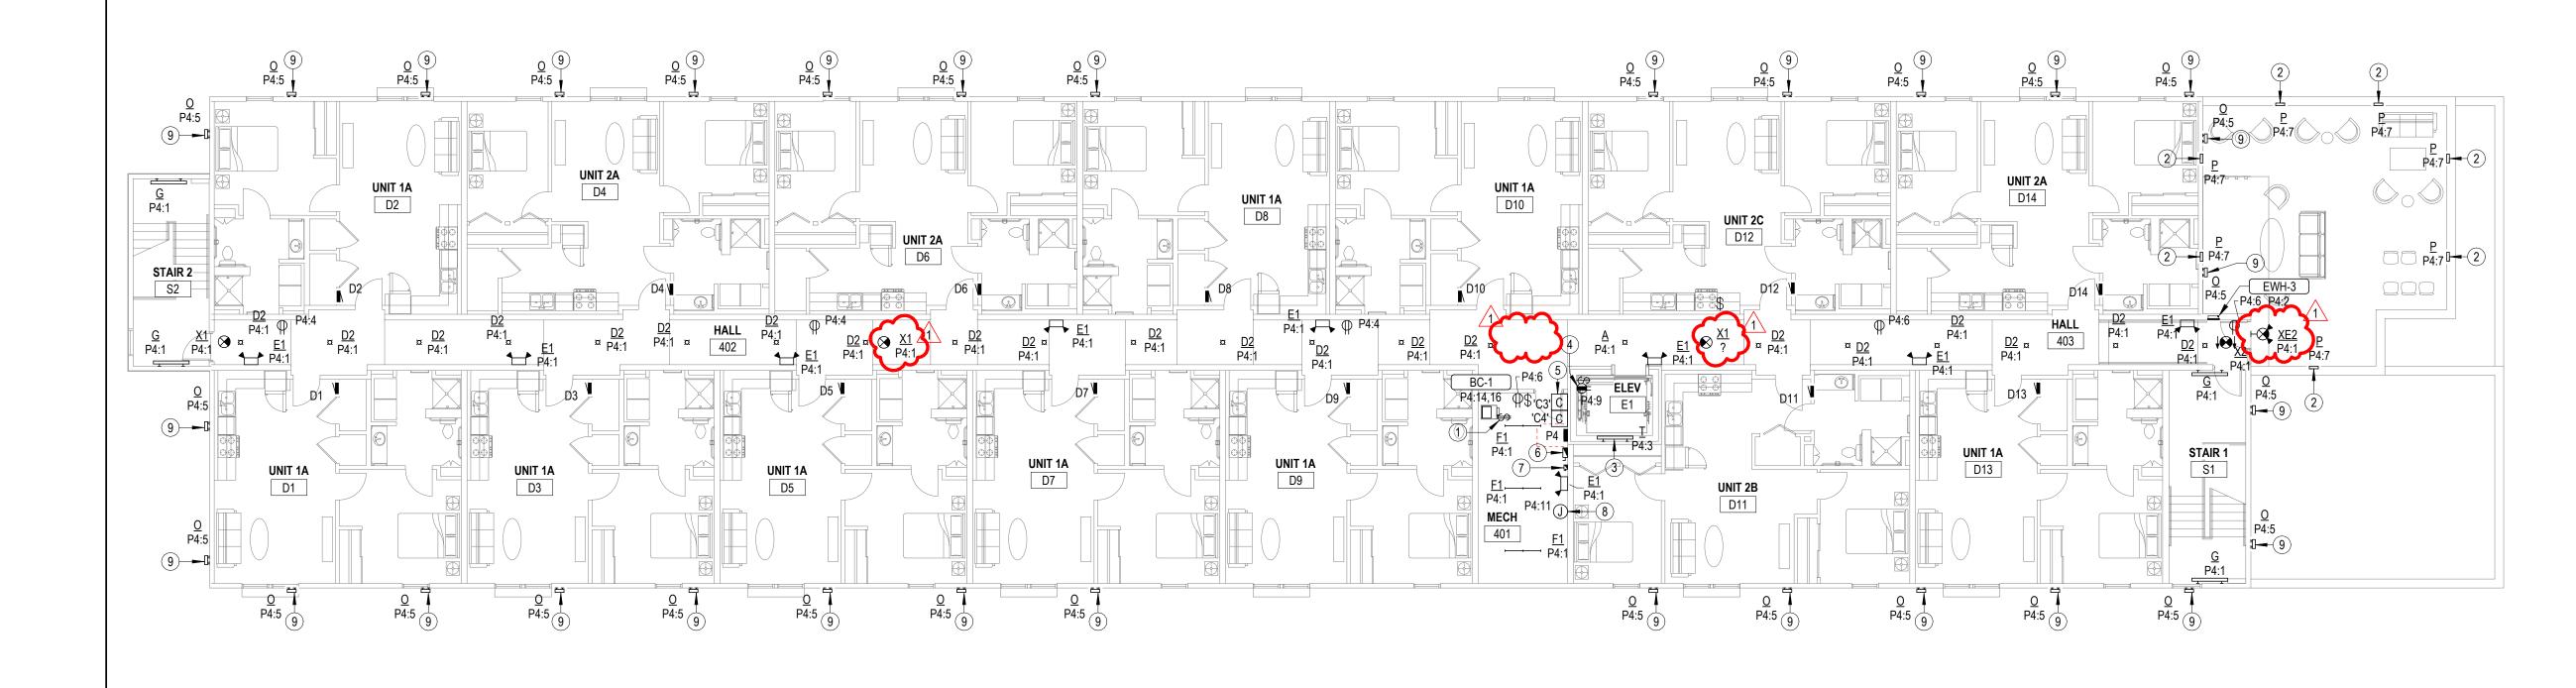

NOTES BY SYMBOL

PROVIDE 30A/2P, SINGLE THROW, MANUAL MOTOR CONTROLLER SNAP SWITCH IN NEMA 1 ENCLOSURE. HUBBELL #HBL7832D OR EQUAL. MAKE FINAL FLEXIBLE CONNECTION TO BLOWER COIL/ELECTRIC HEAT.

INSTALL FIXTURE APPROXIMATELY 24" ABOVE ROOFTOP DECKING SYSTEM. COORDINATE EXACT LOCATION WITH PARAPET FRAMING.

INSTALL LIGHT FIXTURE, SWITCH, AND RECEPTACLE AT TOP OF HOISTWAY. VERIFY EXACT MOUNTING LOCATION AND REQUIREMENTS WITH ELEVATOR INSTALLER. INSTALL RECEPTACLE ON WALL OF ELEVATOR HOISTWAY. VERIFY EXACT LOCATION WITH ELEVATOR EQUIPMENT INSTALLER.

TIMECLOCK AND CONTACTORS FOR EXTERIOR LIGHTING AND OFFICE RECEPTACLE CONTROL, RE: 2:E6.1.

ELEVATOR POWER MODULE SWITCH: 60A/208V/3P SWITCH COMPLETE WITH 60A DUAL ELEMENT, TIME DELAY CLASS 'J' FUSES, 120V CONTROL TRANSFORMER,


FIRE ALARM SAFETY INTERFACE RELAY, KEY TEST SWITCH, GREEN PILOT LIGHT, AUXILIARY CONTACTS FOR ELEVATOR RECALL, AND FIRE ALARM VOLTAGE MONITORING RELAY. EATON BUSSMAN #PS-6-T20-R1-K-G-B-F1 OR EQUAL. COORDINATE EXACT MOUNTING LOCATION AND REQUIREMENTS WITH ELEVATOR EQUIPMENT INSTALLER, AND PROVIDE FINAL ELECTRICAL CONNECTION TO ELEVATOR CONTROLLER. SEE DETAIL 1:E6.1.

30A DISCONNECT SWITCH, LOCKABLE IN "OFF" POSITION, WITH SOLID NEUTRAL AND (1) 20A DUAL-ELEMENT, TIME DELAY FUSE IN NEMA 1 ENCLOSURE FOR ELEVATOR CAB LIGHTS & EXHAUST. MOUNT AT 6'-0" AFF TO TOP AND LABEL WITH CORRESPONDING ELEVATOR CAR NUMBER AND CIRCUIT NUMBER. COORDINATE EXACT MOUNTING LOCATION AND REQUIREMENTS WITH ELEVATOR EQUIPMENT INSTALLER. PROVIDE FINAL ELECTRICAL CONNECTION TO ELEVATOR CONTROLLER.

PROVIDE POWER FOR ELEVATOR SHUNT TRIP CONTROL. SEE 1:E6.1 FOR MORE INFORMATION. 9 ROUTE CIRCUIT THROUGH CONTACTOR INDICATED ON DETAIL 2:E6.1.

E1.2 FOURTH FLOOR ELECTRICAL PLAN

0 8'

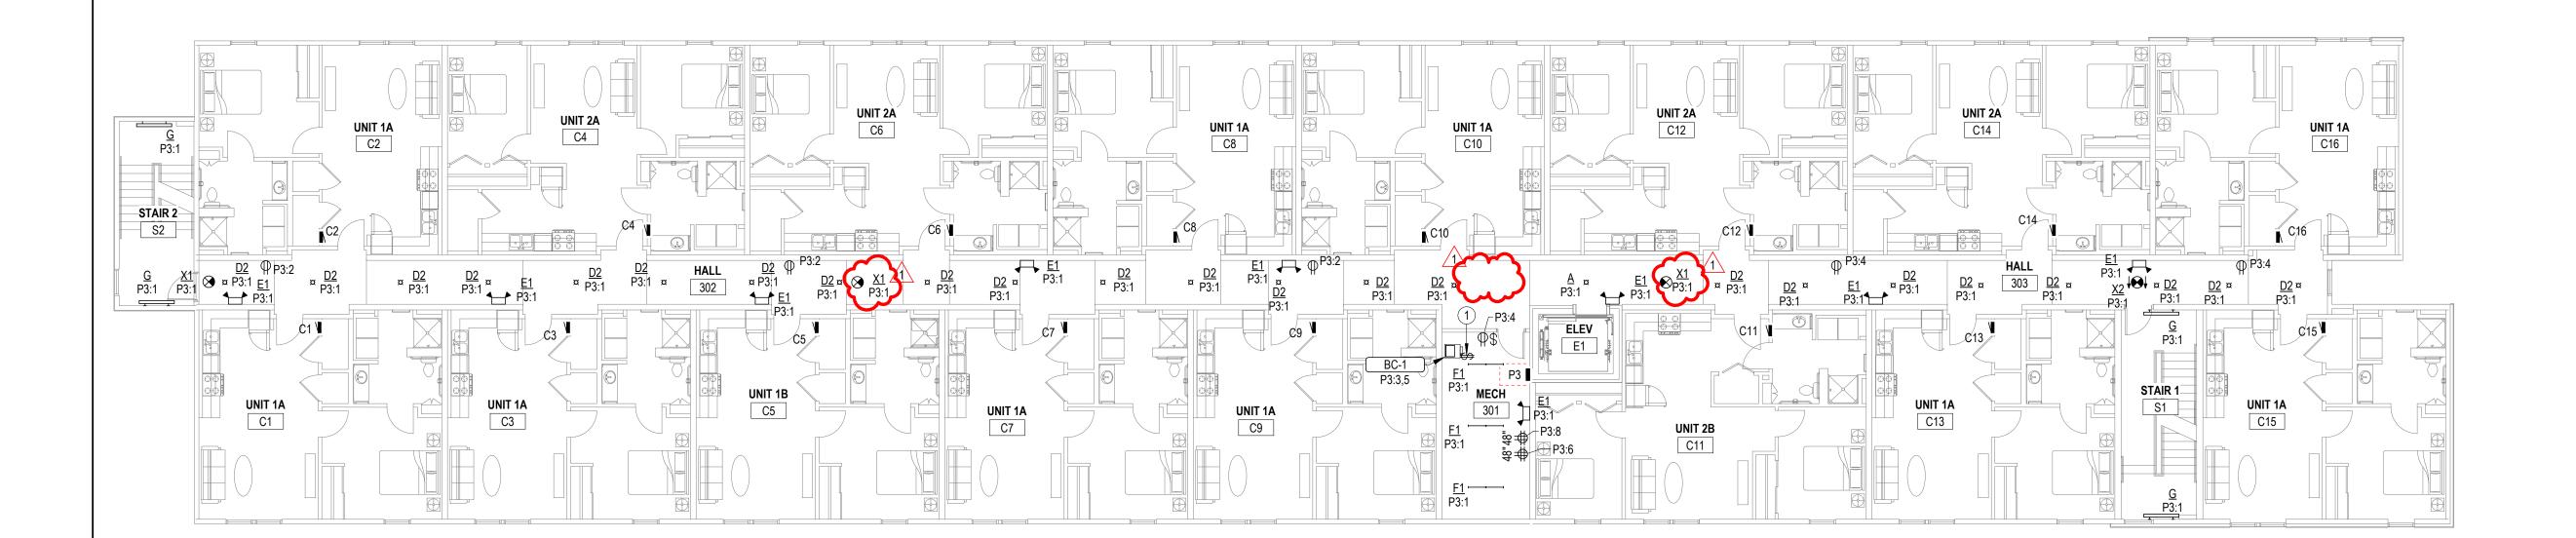

~

SIONS:		

1 Addendum #1 03-04-2025

24 - 3379SHEET NO .:

1 \ ELEVATOR RECALL AND SHUT-DOWN WIRING DIAGRAM

CONTROL WIRING

MAIN LINE POWER FEEDER TO ELEVATOR

CONTROLLER

CONTROL WIRING
TO ELEVATOR LOGIC
CONTROLLER

TO ELEVATOR LOGIC CONTROLLER

THREE ADDRESSABLE FIRE ALARM RELAY

MODULES FOR PRIMARY

AND FIREMAN'S HAT —

R

1. UPON SENSING SMOKE FROM ONE OR MORE ELEVATOR LOBBY OR HOISTWAY, THE SMOKE DETECTOR SHALL

SIGNAL THE FIRE ALARM CONTROL PANEL, WHICH WILL FORWARD THE SIGNAL TO THE ELEVATOR LOGIC

IF PRIMARY RECALL FLOOR'S LOBBY SMOKE DETECTOR SENSES SMOKE AT THAT FLOOR, THE ELEVATOR

WILL LOCK THE ELEVATOR CAB AT THAT FLOOR, DISABLING THE ELEVATOR CAB CONTROLS, UNLESS A

2. ALL SMOKE DETECTORS ASSOCIATED WITH ELEVATOR RECALL (LOBBY AND HOISTWAY) SHALL TRANSMIT A

3. UPON SENSING A HEAT ALARM CONDITION IN THE ELEVATOR HOISTWAY, THE HEAT DETECTOR SHALL SIGNAL

THE FIRE ALARM CONTROL PANEL, WHICH WILL FORWARD THE SIGNAL TO THE ADDRESSABLE RELAY MODULE

SO AS TO DISCONNECT POWER TO THAT CIRCUIT. THIS IS TO BE A NON-AUTO RESET SWITCH. WHEN THE

TO ACTIVATE (VIA A CONVENTIONAL FIRE ALARM RELAY) THE SHUNT-TRIP BREAKER POWERING THE ELEVATOR

SPRINKLER HEAD HAS REACHED ITS CRITICAL TEMPERATURE OF 165° F., THE HEAD WILL BEGIN DISCHARGE OF

SEPARATE AND DISTINCT VISIBLE ANNUNCIATION AT THE FIRE ALARM CONTROL PANEL.

CONTROLLER WILL SEND THE ELEVATOR CAB TO THE NEXT FLOOR CLEAR OF SMOKE. ONCE THE ELEVATOR

CAB HAS REACHED THE DESIGNATED FLOOR, THE ELEVATOR CAB DOORS WILL OPEN AND THE CONTROLLER

CONTROLLER VIA ADDRESSABLE RELAY MODULES TO RECALL ELEVATOR CAB TO THE PRIMARY RECALL FLOOR.

**∕∕**। ्⊣⊢<del>⊶</del>

CIRCUIT BREAKER IN 'MDP' FOR

SHUNT-TRIP COIL AND N.O. AUXILIARY

CONTACTS FOR ELEVATOR RECALL

ELEVATOR POWER WITH 120V

FIREMAN'S KEY IS USED TO OVERRIDE AUTOMATIC CONTROLS.

OVERRIDE SIGNAL —

ELEVATOR RECALL AND SHUT-DOWN SEQUENCE OF OPERATION:

TO ELEVATOR LOBBY

AND HOISTWAY SMOKE

AND HEAT DETECTORS

RECALL, ALTERNATE RECALL

ADDRESSABLE FIRE ALARM

CLASS 'B' INITIATING

MONITOR MODULE

DEVICE CIRCUIT WITH

N.O. CONTACT, NEMA 1

**ENCLOSURE** 

CONTROL RELAY FOR SHUNT-TRIP

VOLTAGE MONITORING, 120V COIL,

NOTE: HEAT DETECTORS IN

OR GREATER. LOCATE HEAT

DETECTORS WITHIN 24" OF

L FACP SIGNALING

─ 24V-dc AUXILIARY

POWER FROM FACP

LINE CIRCUIT

ADDRESSABLE FIRE

CONVENTIONAL FIRE

ALARM RELAY W/ 24

10 AMPS AT 120 V ---

\_\_\_ 120 V

'P4:11'

E6.1 NO SCALE

CONTACTS RATED FOR

V-dc COIL AND SPDT

SPRINKLER HEADS.

F FIXED TEMPERATURE, WITH A LISTED SPACING OF 40' ON CENTER

HOISTWAY SHALL BE SENSITIVE, 135°

A B C	ANUFACTURER T-BAR LED T-BAR LED HALO	MODEL NUMBER TBSL-MN-5-15-B2-B TBSL-MN-5-15-B2-B	29 W 40 W	LUMEN OUTPUT 2190 lm	<b>DRIVER</b> STANDARD STANDARD	MOUNTING CEILING SURFACE	FINISH	DESCRIPTION SURFACE MOUNTED DOWNLIGHT SELECTED BY INTERIOR DESIGNER	NOTES
C CE D1	T-BAR LED  T-BAR LED  HALO	TBSL-MN-5-15-B2-B	40 W	2190 lm	STANDARD			CUREAGE MOUNTED DOWNLIGHT CELECTED BY INTERIOR DECICNED	10
C CE D1	T-BAR LED  T-BAR LED  HALO	TBSL-MN-5-15-B2-B	40 W	2190 lm				SURFACE MOUNTED DOWNLIGHT SELECTED BY INTERIOR DESIGNER	13
CE D1	T-BAR LED HALO			2190 lm		SURFACE WALL		VANITY LIGHT SELECTED BY INTERIOR DESIGNER	13
D1	HALO	TBSL-MN-5-15-B2-B	40 W		0-10V DIMMING TO 10%	CEILING SURFACE	BLACK	5' T-BAR LED WITH BLOCK CLEAR DUFFUSING LENS INTEGRAL TO SUSPENDED CEILING	13
			TO VV	2190 lm	0-10V DIMMING TO 10%	CEILING SURFACE	BLACK	5' T-BAR LED WITH BLOCK CLEAR DUFFUSING LENS INTEGRAL TO SUSPENDED CEILING WITH EMERGENCY BATTERY BACKUP OPTION	13
D2		SMD6R6930WH	10 W	750 lm	0-10V DIMMING TO 10%	CEILING SURFACE	WHITE	6" DIA ROUND SURFACE MOUNT DOWNLIGHT	6
	HALO	SMD6R12930WH	15 W	1200 lm	0-10V DIMMING TO 10%	CEILING SURFACE	WHITE	6" DIA ROUND SURFACE MOUNT DOWNLIGHT	
E1	LITHONIA	ELM6L UVOLT LTP	3 W			SURFACE WALL	WHITE	LED DUAL-HEAD EMERGENCY LIGHT	1
E2	LITHONIA	AFB-OEL-DDBTXD-UVOLT-N-WT	3 W			SURFACE WALL	WHITE	DIE-CAST ALUMINUM EMERGENCY LIGHT WITH POLYCARBONATE LENS, INTEGRAL BATTERY	_ 1,2,3
F1 D	DAY-BRITE CFI	FSS440L840-UNV-DIM	30 W	4077 lm	0-10V DIMMING TO 10%	CEILING SURFACE	WHITE	4' STANDARD STRIP WITH CURVED FROSTED ACRYLIC LENS	
F2 D	DAY-BRITE CFI	FSS220L840-UNV-DIM	17 W	2049 lm	0-10V DIMMING TO 10%	CEILING SURFACE	WHITE	2' STANDARD STRIP WITH CURVED FROSTED ACRYLIC LENS	
G	LITHOINA	WL4-40L-EZ1-LP830-MSD7-DIM50-E10WLC P	40 W	3927 lm	STANDARD	SURFACE WALL	WHITE	4 FT. WALL MOUNTED STAIRWELL LIGHT WITH EMERGENCY BATTERY BACKUP	8
Н	LITHONIA	FMFL4W-48-ALO6-SEF-840-MVOLT	50 W	4000 lm	STANDARD	SURFACE	WHITE	LED WRAPAROUND	
J					STANDARD	SURFACE WALL	WHITE	VERTICAL VANITY LIGHT SELECTED BY INTERIOR DESIGNER	13
L	LIGHTOLIER	P6RDL15940MCL-Z10UI	12 W	1500 lm	STANDARD	SURFACE	WHITE	6" ROUND SURFACE MOUNTED DOWNLIGHT	1,4
М	GARDCO	GCS-A01-840-T3M-UNV	10 W	1500 lm	STANDARD	SURFACE WALL	WHITE	AREA WALL SCONCE WITH TYPE 3 IES DISTRIBUTION	17
N	GARDCO	GCM-B04-840-SPT-U-SPT-UNV-FAWS	16 W	1611 lm	STANDARD	SURFACE WALL	WHITE	UP/DOWN WALL SCONCE WITH SPOT DISTRIBUTION	14,16
0	BOCA	NANO-X-3W-4000K-120V-120-A-H-E-LD-SQ	3 W	573 lm	STANDARD	SURFACE WALL	WHITE	1' LED 120° WALL WASH UP LIGHT	3,15
Р	GARDCO	941L-21L-NW-LV-UNV	32 W	466 lm	STANDARD	SURFACE WALL	WHITE	LED STEP LIGHTS	3
R1 CO	OPER LIGHTING	GALN-SA1C-840-U-T2-HSS	57 W	7154 lm	LED DRIVER	ROUND POLE	BLACK	LED AREA LIGHT, SINGLE HEAD FULL CUT-OFF WITH IES TYPE II DISTRIBUTION AND HOUSE SIDE SHEILD	3,7,10
R2 CO	OPER LIGHTING	GALN-SA3C-840-U-T3-HSS	160 W	20812 lm	LED DRIVER	ROUND POLE	BLACK	LED AREA LIGHT, SINGLE HEAD FULL CUT-OFF WITH IES TYPE III DISTRIBUTION AND HOUSE SIDE SHEILD	D 3,7,11
R3 CO	OPER LIGHTING	GALN-SA3C-840-U-5WQ	160 W	21966 lm	LED DRIVER	ROUND POLE	BLACK	LED AREA LIGHT, SINGLE HEAD FULL CUT-OFF WITH IES TYPE V DISTRIBUTION	3,7,12
S	ACCLAIM	DFB-111-AKEU	50 W	2455 lm	STANDARD	GRADE	BLACK	IP-66 RATED, GRADE MOUNTED LED FLOOR LIGHT	
Ţ	LITHOINA	FEM-L48-4000LM-IMAFL-WD-MVOLT-GZ10	24 W	3615 lm	STANDARD	SURFACE WALL	WHITE	4 FT. FULLY ENCLOSED AND GASKETED INDUSTRIAL FIXTURE WITH FROSTED,	
$ \frown \!$	$\boldsymbol{\searrow}$	-35K 200RI			$\sim$		~~	RIBBED, MITACT RESISTANT ACRYLIO LENS	~~
X1	LITHONIA	EDGR 1 R EL			<b></b>	CEILING	WHITE	RECESSED SINGLE FACE LED EXIT SIGN	1,2
X2	LITHONIA	EDGR 2 R EL				CEILING	WHITE	RECESSED DOUBLE FACE POLYCARBONATE EXIT SIGN	1.2
XE1	LITHONIA	LHQM LED R HO				WALL	WHITE	COMBO EXIT/EMERGENCY LIGHTING UNIT	1,2
XE2	LITHONIA	WLTC1RSDCW				WALL	WHITE	EXTERIOR RATED COMBINATION EXIT/EMERGENCY LIGHT	1,2

 ALL LED FIXTURES SHALL ADHERE TO LM79 AND LM80 STANDARDS PROVIDE MANUFACTURER'S FLANGE KIT WHERE LAY-IN FIXTURES ARE TO BE INSTALLED IN GYP. ALL APARTMENT LIGHT FIXTURES SHALL BE ENERGY STAR CERTIFIED

1. PROVIDE FIXTURE WITH EMERGENCY BATTERY INTEGRAL CHARGER WITH SELF-DIAGNOSTIC/SELF-TESTING ELECTRONICS. 2. FIXTURE SHALL BE CAPABLE OF WALL OR CEILING MOUNT APPLICATIONS AND SHALL HAVE BREAK-OUT DIRECTIONAL CHEVRONS. U.L. LISTED FOR 'WET LOCATION'.

4. U.L LISTED FOR 'DAMP LOCATION'.

5. FIXTURE TO COMPLY WITH NEC 410.16(C)(5).

6. WHERE INSTALLED IN BATHROOMS TO BE 'DAMP LOCATION' U.L. LISTED, WHERE ABOVE SHOWERS TO BE 'WET LOCATION' U.L. LISTED. 7. FIXTURE/POLE ASSEMBLY SHALL BE RATED FOR 100 MPH WIND LOADS. PROVIDE WITH VIBRATION DAMPER PER MANUFACTURER'S RECOMMENDATIONS.

8. PROVIDE FIXTURE WITH INTEGRAL OCCUPANCY SENSOR AND CONTROLS TO DIM FIXTURE TO 50% LIGHT OUTPUT WITH UNOCCUPIED.

9. WHERE INSTALLED IN FIRE RATED ASSEMBLY, PROVIDE FIRE RATED RECSSED LIGHT COVER EQUAL TO TENMAT FF109. VERIFY RATING REQUIREMENTS WITH ARCHITECT. 10. PROVIDE FIXTURE/POLE ASSEMBLY WITH 11' ROUND STRAIGHT STEEL POLE, BLACK TO MATCH FIXTURE.


11. PROVIDE FIXTURE/POLE ASSEMBLY WITH 14' ROUND STRAIGHT STEEL POLE, BLACK TO MATCH FIXTURE. 12. PROVIDE FIXTURE/POLE ASSEMBLY WITH 22' ROUND STRAIGHT STEEL POLE, BLACK TO MATCH FIXTURE.


13. FIXTURE TO BE SELECTED BY INTERIOR DESIGNER, COORDINATE ALL REQUIREMENTS WITH INTERIOR DESIGNER.


14. CONTRACTOR SHALL ADJUST LUMEN OUTPUT AS DIRECTED BY OWNER. COORDINATION SHALL OCCUR AFTER DARK TO ENSURE DESIRED ILLUMINATION. 15. INSTALL FIXTURE 41' ABOVE FIRST FLOOR FINISHED FLOOR.

16. INSTALL FIXTURE 10' ABOVE FINISHED FLOOR.

17. INSTALL FIXTURE 7' ABOVE FINISHED FLOOR.

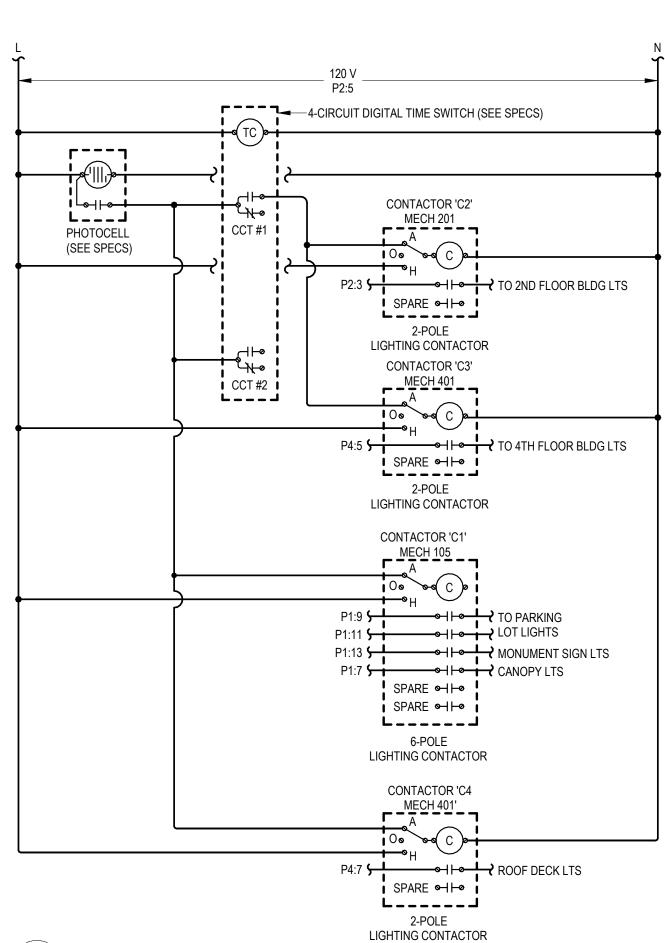

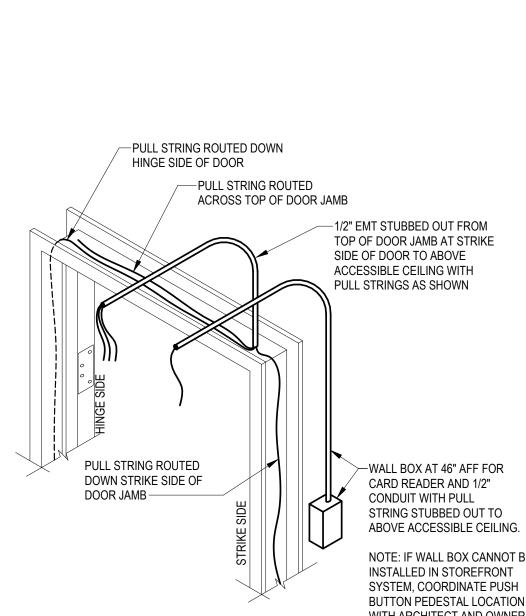

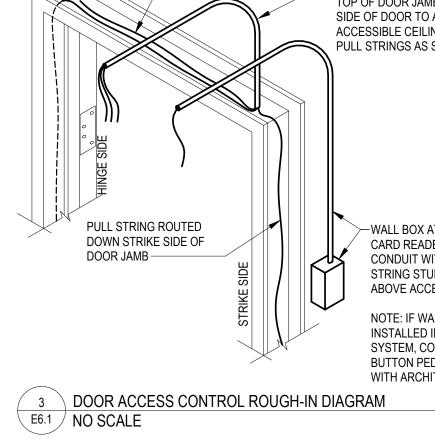

4 ACCESSIBLE APARTMENT DOORBELL WIRING SCHEMATIC E6.1 / NO SCALE

POWER SUPPLY SHALL BE A LOW VOLTAGE CLASS 2 TRANSFORMER COMPATIBLE

WITH DOORBELL SELECTED BY INTERIOR DESIGNER. FLUSH MOUNT IN 2-GANG

-POWER SUPPLY

HORN/STROBE(S), POWER SUPPLIES AND ALL WIRING REQUIRED.

PROVIDE DOOR ANNUNCIATOR SYSTEM COMPLETE WITH PUSH BUTTON,

HORN/STROBE SHALL ACTIVATE WHEN PUSH BUTTON IS DEPRESSED.

HORN/STROBE SHALL OPERATE AT 24VAC, HAVE A CLEAR LENS WITH 50cd

STROBE AND HORN WITH 82dB AT 10', UL 1638 LISTED, EDWARDS #6536-G5.

3. PUSH BUTTON SHALL BE SELECTED BY INTERIOR DESIGNER, MOUNT AT 48"

WALL BOX WITH BLANK COVER PLATE, DIRECTLY ABOVE HORN/STROBE.

5. LOW VOLTAGE CLASS 2 CABLING SHALL BE MINIMUM 18 AWG UNSHIELDED.

AFF. ENSURE COMPATIBILITY WITH ACCESSIBLE UNIT HORN STROBE.


DOOR ALARM BUZZER SYSTEM NOTES

FLUSH MOUNT IN WALL AT 6'-8" AFF.

\_\_\_<del>\_\_</del>\_\_\_

**L----**

HORN/STROBE

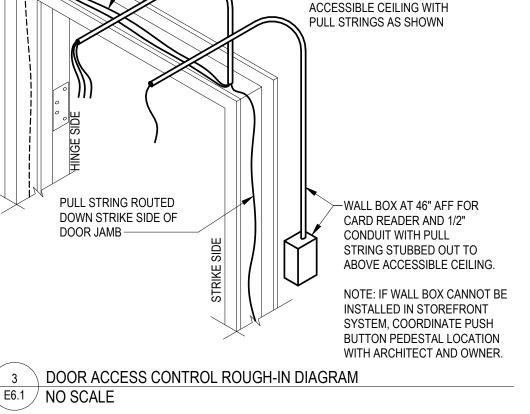

2 LIGHTING CONTROL DIAGRAM E6.1 NO SCALE