



Jones Gillam Renz Architects

Address

730 N 9th St. 1881 Main St., Suite 301
Salina, KS 67401 Kansas City, MO 64108

Contact

jgr@jgrarchitects.com
(785) 827-0386

Web

jgrarchitects.com

ARCHITECT'S SUPPLEMENTAL INSTRUCTIONS

JONES GILLAM RENZ DOCUMENT JGR 710

PROJECT:	The Reserves at Cobalt Circle New Development Brownsville, TN	Report No.	Eight (8)
OWNER:	OPG Cobalt Circle Partners, LLC Dan Maximuk 250 N. Santa Fe Ave, Suite A Salina, KS 67401	Date	Jan. 20, 2026
CONTRACTOR:	MCP Group 3501 SW Fairlawn Rd. Topeka, KS 66614	Architect's Proj No.	24-3446
		Contract For:	General Construction Mechanical, Electrical

The work shall be carried out in accordance with the following supplemental instructions issued in accordance with the Contract Documents without change in Contract Sum or Contract Time. Prior to proceeding in accordance with these instructions, indicate your acceptance of these instructions for minor change to the Work as consistent with the Contract Documents and return a copy to the Architect.

DESCRIPTION:

Contractor to make adjustments as needed and required per the modifications as indicated on attached drawings and in the below descriptions:

- a. Approval letter from the Tennessee State Fire Marshal's Office has been included in this ASI.
- b. Cover Sheet – JGR Seal and Date added; Sheets A4.10, A4.11 and P9.2 added to the index list; Date of set changed to 1-20-2026
- c. CFP1 – Climate zone information added; Local Fire Department and Fire Chief information added.
- d. Shower/tub wall locations have been adjusted for Units A102 & A108 in Bath 106 – Reference revised Sheets A2.1, A2.4, A2.5 and A2.7
- e. Note has been added stating that "db rating for all fire alarm horns shall be set 15 db above ambient per code requirements." – Reference Revised Sheets E1.1-E1.6
- f. Note stating "All required documentation regarding the design of the fire detection, alarm, and communication systems and the procedures for maintenance, inspection, and testing of fire detection, alarm, and communications systems shall be maintained at an approved, secured location for the life of the system" has been added to FACP Location – Reference revised sheets E1.1, E1.3
- g. Note has been added to Special Systems plans and Electrical panel Schedule – Reference Sheets E1.1-E1.6 and E6.3
- h. Sheet M6.1 – standard ceiling radiation damper detail has been added.
- i. Refrigerant type (R-32) has been added to VTAC schedule – Reference revised sheet M6.1
- j. General notes regarding A2L refrigerants have been added to M1.1.

Attachments:

- 1. Approval Letter from the Tennessee State Fire Marshal's Office
- 2. Revised Architectural Sheets: Cover Sheet, CFP1, A2.1, A2.4, A2.5, A2.7
- 3. Revised MEP Sheets: E1.1, E1.2, E1.3, E1.4, E1.5, E1.6, E6.3, M1.1, M6.1

Issued by:

Jones Gillam Renz Architects PO Box 2928, Salina, KS 67402
Maggie Gillam, Project Manager 785-827-0386 mgillam@jgrarchitects.com

Copies to:

MCP Group – Mike Maas, Cliff Holland, Tim Johnson, Kelli Meiers
OPG - Dan Maximuk, Amanda Klaus, Austin Kack
JGR Team - Maggie Gillam (JGR), Ryan Lies (LST), Cindy Senecal (McClure), Wesley Wooldridge (Renaissance), Michael Boerst (Heartland Energy)



Date: 01/22/2026

To: Margaret Gillam
Jones Gillam Renz Architects
730 N. Ninth Street
Salina, KS 67401

RE: Released for Phased Construction (See note below)

The Reserves at Cobalt Circle
1616 E. Jefferson
Brownsville, TN 38012

TFM # 21689-A

21689-B

21689-C

Project # 2025-11-03-04

County: Haywood

Dear Margaret Gillam,

The construction documents submitted to our office for the above referenced project have been reviewed for compliance with the minimum standards for fire prevention, fire protection, and building construction safety of the Rules of Tennessee Department of Commerce and Insurance, Division of Fire Prevention, Chapter 0780-02-02, Codes and Standards.


This is not a public building. Therefore, it is not subject to Tenn. Code Ann. § 68-102-201, et seq., the Tennessee Public Building Accessibility Act. It has not been reviewed for compliance with the 2010 ADA Standards for Accessible Design. It has not been reviewed for compliance with the Americans with Disabilities Act.

Phased construction drawings are released for local permitting and phased construction through the stage identified above. The architect and owner shall proceed at their own risk with the building operation and without assurance that final approval for the entire structure will be granted in accordance with the International Building Code (IBC) 107.3.3.

***Review Note:** The plans are approved except for the above ground sprinkler design intent with the following stipulation:

Stipulation:

Complete the sprinkler design intent and sprinkler shop drawings for the above ground portion of the system with calculations and manufacturer cut sheets showing listing of fire protection systems must be submitted by a Tennessee registered sprinkler system contractor for review and approval

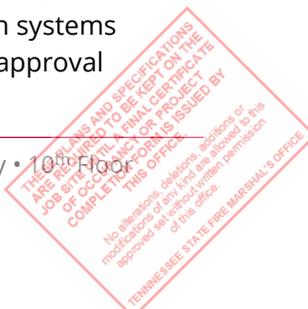

FIELD SET TFM# 21689-A, 21689-B, 21689-C PROJECT# 2025-11-03-04

prior to installation in accordance with Rule 0780-2-7-.09. The sprinkler shop drawings, calculations, & manufacture's cut sheet package must be reviewed and approved by the fire protection engineer of record (processed with the engineers shop drawing review stamp) prior to the submittal to the State Fire Marshal's Office. All piping from the *point of service* including underground used for sprinkler or standpipe must be installed by a Tennessee registered sprinkler contractor. Rule 0780-2-.08

Note that stipulations must be satisfied by sealed construction documents before such work is performed. A Certificate of Occupancy (CO) will not be issued if stipulations are not satisfied. Rule 0780-02-03-.10.

Note:

Construction may not proceed past the approved stage. Rule 0780-02-03-.02. No approval of plans, or failure to review, plans, and specifications by the Division shall relieve the owner, developer, contractor, or designing architect or engineer of their respective responsibilities for compliance with applicable codes respecting fire prevention, fire protection, and building construction. Rule 0780-02-03-.05.

Approved plans are available electronically at <https://apps.tn.gov/tnsfmo/>. They must be printed with all markups and stamps and placed at the project site prior to construction. They shall be available to the State Fire Marshal's Office inspector and retained until a CO has been issued by the Division. Failure to have the plans at the site and available to the inspector may be grounds for a Stop Work Order to be issued. Rule 0780-02-03-.05.

All subsequent construction document revisions that impact the approved plan's fire prevention, fire protection, or building construction safety must be submitted to this office for review and approval. Rule 0780-02-03-.02.

The project's contractor must contact the Tennessee State Fire Marshal's Office inspector prior to construction to ensure that the proper inspections are performed in accordance with the Rules of the Tennessee Department of Commerce and Insurance and IBC Sect. 110. A Certificate of Occupancy will be issued after work is completed and all inspections are performed and satisfied. The building must have a Certificate of Occupancy before it may be occupied. Rule 0780-02-03-.10.

Sincerely,



Jeremy Hubanks, Plans Examiner II
Codes Enforcement Section

cc: Kevin Krummy, SFMO Fire & Building Codes Inspector
Daniel Garrett, SFMO Fire & Building Codes Supervisor

Attachment: Requirements for Inspections of Construction (3 Sheets)
Approved Drawings Except for Above Ground Sprinkler Design Intent (107 Sheets)

Approval: Occupancy Type: R-2, B, 3-Stories, Construction Type: V-B, Sprinklered



Inspection Information for Construction

This document provides information to assist contractors with State Fire Marshal's Office inspections. Many building projects have multiple Authorities Having Jurisdiction and consultation with those authorities is needed to meet their requirements. This is not a code checklist. It contains information pertinent to most new building projects; however, additional requirements may apply depending on the specific circumstances of each individual project.

SITE CONSTRUCTION DOCUMENTS

1. State Fire Marshal's Office (SFMO) approved architectural plans must be at the site before construction begins and must remain there until a Certificate of Occupancy is issued;
2. Grading and site preparation may begin prior to plan approval;
3. If a fire sprinkler system is installed, approved sprinkler plans must be on site prior to installation of underground or aboveground piping;
4. If a commercial kitchen hood and duct system is installed, the design intent must be on the approved plans. Shop drawings do not require approval;
5. A copy of the Tennessee contractor's license must be available for all bids over \$25,000;
6. A copy of the Tennessee electrician's license must be available;
7. A copy of the Tennessee fire alarm contractor's license must be available where fire alarm work is performed or a written exemption certificate from the contractor's board. All fire alarm work including wiring, installation of components, etc. must be done by a fire alarm contractor or exempted electrical contractor;
8. A copy of the Tennessee licensed portable or fixed fire suppression contractor's license must be available for applicable work;
9. A copy of the Tennessee licensed fire sprinkler contractor's license must be available for all work beginning at the Point of Service (where water is used solely for fire protection). This includes underground water lines used solely for fire protection.

FIRE SAFETY DURING CONSTRUCTION AND DEMOLITION

1. Fire department access roads and lanes must be provided. Fire hydrants must be provided before combustible materials are on site;
2. Buildings four (4) or more stories in height shall be provided with at least one (1) standpipe. Standpipes shall be operational when the building is 40 feet above the lowest level of fire department access. Fire department hose connections must be at accessible locations adjacent to usable stairs. Standpipes shall be extended as construction progresses to within one (1) floor of the highest point of construction having secured decking or flooring;
3. Stairways are required where the building is constructed to 50 feet or four (4) stories;
4. Required means of egress for existing buildings must be maintained during construction.



Inspection Information for Construction

REVISIONS TO APPROVED PLANS

The building must be built according to the State Fire Marshal approved plans. Change orders, revisions, etc. that impact building, fire or life safety of the project cannot be made until the revisions are approved in writing and the plans are at the site.

INSPECTIONS

Contact your local SFMO inspector at least five (5) days prior to an inspection. Failure to schedule an inspection may result in costly repairs from exposing covered construction, or a Certificate of Occupancy not being issued. Inspections are required for:

1. **Foundation:** Inspections are required after poles or piers are set or trenches or basement areas are excavated and any required forms erected and any required reinforcing steel is in place and supported prior to the placing of concrete. The foundation inspection shall include excavations for thickened slabs intended for the support of bearing walls, partitions, structural supports, equipment and special requirements for wood foundations. Proper dimensions, installation and size of re-bar must be determined to be compliant by SFMO inspector or a 3rd party inspection service before pouring;
2. **Fire Sprinkler Underground:** Inspections are required after bedding, piping and thrust blocks prior to backfill. Hydro-static tests must be performed and documented. The SFMO inspector must witness the test unless other arrangements are made with the inspector;
3. **Framing:** Inspections are required after roof, framing, fire stopping, draft stopping, bracing, rough-in plumbing, rough-in mechanical and rough-in electrical are in place, and prior to covering walls or ceilings;
4. **Fire Rated Wall/Roof/Ceiling Assemblies:** Inspections are required after drywall, spray applied foam or other system are applied;
5. **Above-Ceiling:** Inspections are required before ceiling installation and after fire sprinkler, final mechanical, final plumbing, fire stopping systems, fire dampers, electrical fire rated wall/floor/ceiling assemblies are in place;
6. **Final:** Inspections are required after all work is complete. The contractor must provide a worker for operation of fire or smoke damper testing, duct mounted smoke detectors, fire alarm devices, test and balance of commercial kitchen hood and duct units, operation of smoke evacuation/management systems. All systems must be operational and the subcontractors must test all systems prior to the final inspection;
7. **Functional tests and documents needed to pass the final inspection** are:
 - a. When required, foundation inspection reports performed by 3rd party inspection services;
 - b. Final electrical inspection approval;
 - c. Functional testing of generator used for life safety systems;
 - d. Functional test of exit signs and emergency lighting to include all means of egress areas and exit discharge to public way. Functional testing to be observed by SFMO inspector;
 - e. Boiler inspections and tagging;
 - f. Functional test of commercial kitchen hood and duct and suppression systems to include: light test,

Inspection Information for Construction

- “puff” test, energy shut-down test, capture and containment test and air balance report. Functional testing to be observed by SFMO inspector;
- g. Functional test of fire alarm and Fire Alarm and Emergency Communication System Inspection and Testing Form per 2010 NFPA 72. Functional testing to be observed by SFMO inspector;
 - h. Functional test of fire sprinkler system and test reports and documentation for underground and aboveground systems. Functional testing to be observed by SFMO inspector;
 - i. Functional test of fire pumps and standpipes and acceptance test reports and documentation. Functional testing to be observed by SFMO inspector;
 - j. Functional test of smoke control systems acceptance test reports and documentation. Functional testing to be observed by SFMO inspector;
 - k. Test and balance reports for commercial HVAC systems;
 - l. Functional testing of shut-down test for HVAC units where applicable. Functional testing to be observed by SFMO inspector;
 - m. Functional testing of access controlled or delayed egress door hardware. Functional testing to be observed by SFMO inspector;
 - n. Elevator approval and acceptance test reports from the state elevator inspector;
 - o. For premanufactured metal buildings or metal framed buildings, inspection reports of structural welds and fastening devices by 3rd party inspection services;
 - p. Emergency responder radio coverage: New buildings shall have approved radio coverage for emergency responders within the building based upon the existing coverage levels of the public safety communication systems of the jurisdiction at the exterior of the building. This shall not require improvement of the existing public safety communication systems. The test should be performed by the local fire department after interior and exterior walls and the roof are constructed;
 - q. Inspection test reports and documentation for applications of fire retardant coatings;
 - r. For gated communities, functional test of security gate or barrier showing they are capable of receiving signals from emergency responders and allowing access.

Disclaimer: This document was developed by the Code Enforcement Section of the Tennessee Department of Commerce and Insurance. To the best of our knowledge, information contained in this document is accurate and reliable as of the date of release; however, we do not assume any liability for the accuracy or completeness.



Department of Commerce and Insurance
Authorization No. 335485 • 0 copies • September, 2018
This public document was promulgated at a cost of \$35.00



THE RESERVES AT COBALT CIRCLE

NEW APARTMENTS

BROWNSVILLE,

24-3446

TENNESSEE



730 N. Ninth St.
Salina, KS 67401
785.827.0386

1881 Main St, Ste 301
Kansas City, MO 64108
jgr@jgrarchitects.com



CONSULTANTS

Civil Engineer



Renaissance Group
9700 Village Circle, Suite 100
Lakeland, TN 38002
(901) 332-5533
wooldridge@rgroup.biz

Mechanical & Electrical Engineer



LST Consulting Engineers, PA
4809 Vue Du Lac Place, Suite 301
Manhattan, KS 66503
(785) 587-8042
mail@LSTengineers.com

Structural Engineer



McClure Engineering Co.
2001 W. Broadway
Columbia, MO 65203
(573) 814-1568

TENNESSEE STATE FIRE MARSHAL ADOPTED CODES


2021 INTERNATIONAL BUILDING CODE
2021 FUEL GAS CODE
2021 INTERNATIONAL MECHANICAL CODE
2021 INTERNATIONAL PLUMBING CODE
2021 INTERNATIONAL FIRE CODE
2021 INTERNATIONAL ENERGY CONSERVATION CODE
2021 NFPA LIFE SAFETY CODE
2017 NATIONAL ELECTRIC CODE
FAIR HOUSING ACT DESIGN MANUAL
2010 ADA STANDARDS FOR ACCESSIBLE DESIGN
2017 ICC A117.1 ACCESSIBLE & USABLE BUILDINGS and FACILITIES

CITY OF BROWNSVILLE, TN ADOPTED CODES

2018 INTERNATIONAL BUILDING CODE
2018 INTERNATIONAL MECHANICAL CODE
2018 INTERNATIONAL PLUMBING CODE
2017 NATIONAL ELECTRIC CODE
2018 INTERNATIONAL FIRE CODE
2021 INTERNATIONAL ENERGY CONSERVATION CODE
FAIR HOUSING ACT DESIGN MANUAL
2010 ADA STANDARDS FOR ACCESSIBLE DESIGN
2009 ICC A117.1 ACCESSIBLE & USABLE BUILDINGS and FACILITIES

NOTE: CODE FOOT PRINT AND LIFE SAFETY PLANS ARE FOLLOWING ON SHEETS CFP1 AND CFP2. UNLESS NOTED OTHERWISE (WITH AN *), THE PLANS AND DESIGNS FOLLOW THE MORE STRINGENT OF THE CODES AS LISTED ABOVE. THUS, THE DESIGNS FOLLOW THE 2021 CODES AS LISTED UNDER THE STATE FIRE MARSHAL. ON RARE OCCASION, THE DESIGNS MAY FOLLOW THE 2018 CODES AS LISTED UNDER BROWNSVILLE. THESE INSTANCES WILL BE NOTED AS SUCH.

REFERENCE LEGEND

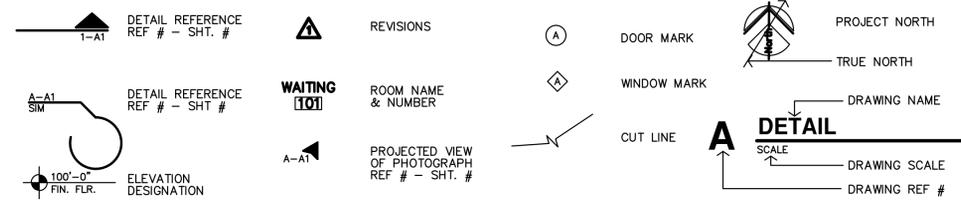

SFMO APPROVAL STAMPS

SHEET INDEX

GENERAL

- COVER & SHEET INDEX
- CFP1 CODE FOOTPRINT
- CFP2 CODE FOOTPRINT
- CFP3 CODE FOOTPRINT
- ADA ADA DIAGRAMS
- FH FAIR HOUSING
- ANSI1 ANSI ACCESSIBILITY STANDARDS
- ANSI2 ANSI ACCESSIBILITY STANDARDS
- ANSI3 ANSI ACCESSIBILITY STANDARDS

ARCHITECTURAL

- A1.1 SITE PLAN
- A1.2 ENLARGED PLANS & DETAILS
- A1.3 ENLARGED PLANS & DETAILS
- A1.4 ENLARGED PLANS & DETAILS
- A1.5 ENLARGED PLANS & DETAILS
- A2.1 BUILDING A - CLUBHOUSE FLOOR PLANS
- A2.2 BUILDING B FLOOR PLANS
- A2.2C BUILDING C FLOOR PLANS
- A2.3 1-BEDROOM UNIT PLANS
- A2.4 2-BEDROOM UNIT PLANS
- A2.5 3-BEDROOM UNIT PLANS
- A2.6 ACCESSIBLE 1-BEDROOM ENLARGED BATH PLANS & INTERIOR ELEVATIONS
- A2.7 ACCESSIBLE 2/3-BEDROOM ENLARGED BATH PLANS & INTERIOR ELEVATIONS
- A2.8 ADAPTABLE/STANDARD 1-BEDROOM ENLARGED BATH PLANS, INTERIOR ELEVATIONS & SECTIONS
- A2.9 ADAPTABLE 2/3-BEDROOM ENLARGED BATH PLANS, INTERIOR ELEVATIONS
- A2.10 STANDARD 2/3-BEDROOM ENLARGED BATH PLANS & INTERIOR ELEVATIONS
- A2.11 CLUBHOUSE PLAN & SCHEDULES
- A2.12 CLUBHOUSE ENLARGED PLANS & DETAILS
- A3.1 BUILDING A - EXTERIOR ELEVATIONS
- A3.2 BUILDING B - EXTERIOR ELEVATIONS
- A3.3 BUILDING C - EXTERIOR ELEVATIONS
- A3.4 BUILDING C - EXTERIOR ELEVATIONS
- A4.1 TYPICAL WALL SECTIONS
- A4.2 TYPICAL WALL SECTIONS
- A4.3 TYPICAL WALL SECTIONS
- A4.4 DETAILS
- A4.5 DETAILS
- A4.6 ENTRY SECTIONS & DETAILS
- A4.7 CLUBHOUSE SECTIONS & DETAILS
- A4.8 CLUBHOUSE SECTIONS & DETAILS
- A4.9 FIRE PENETRATION DETAILS
- A4.10 MANUFACTURED STONE DETAILS
- A4.11 HARDI PANEL SIDING DETAILS
- A5.1 ROOF PLANS
- A5.1C ROOF PLANS
- A5.2 ROOF DETAILS & STAIR SECTIONS
- A6.1 STAIR SECTION & ENLARGED PLANS
- A7.1 APARTMENT REFLECTED CEILING PLANS

STRUCTURAL

- S001 GENERAL NOTES
- S002 GENERAL NOTES
- S003 SCHEDULES
- S101 BLDG A - FOUNDATION PLAN
- S102 BLDG A - LEVEL 2 PLAN
- S103 BLDG A - LEVEL 3 PLAN
- S104 BLDG A - ROOF PLAN
- S105 BLDG B - FOUNDATION PLAN
- S106 BLDG B - LEVEL 2 PLAN
- S107 BLDG B - LEVEL 3 PLAN
- S108 BLDG B - ROOF PLAN
- S109 BLDG C - FOUNDATION PLAN
- S110 BLDG C - LEVEL 2 PLAN
- S111 BLDG C - LEVEL 3 PLAN
- S112 BLDG C - ROOF PLAN
- S500 FOUNDATION DETAILS
- S501 FOUNDATION DETAILS
- S505 TYPICAL WOOD DETAILS
- S510 FRAMING DETAILS
- S511 FRAMING DETAILS
- S520 ROOF DETAILS
- S521 ROOF DETAILS
- S530 SHEAR WALL DETAILS

ELECTRICAL

- ME1.0 M/E SITE PLAN
- E0.1 ELECTRICAL ABBREVIATIONS, LEGENDS, NOTES
- E1.1 BUILDING A - 1ST & 2ND FLOOR POWER PLANS
- E1.2 BUILDING B - 3RD FLOOR POWER PLAN
- E1.3 BUILDING B - 1ST & 2ND FLOOR POWER PLANS
- E1.4 BUILDING B - 3RD FLOOR POWER PLAN
- E1.5 BUILDING C - 1ST & 2ND FLOOR POWER PLANS
- E1.6 BUILDING C - 3RD FLOOR POWER PLAN
- E4.1 APARTMENT & CLUBHOUSE POWER PLANS
- E6.1 LIGHTING DIAGRAMS & LIGHTING SCHEDULE
- E6.2 PANEL SCHEDULES & RISER DIAGRAMS
- E6.3 PANEL SCHEDULES

MECHANICAL/PLUMBING

- M0.1 HVAC ABBREVIATIONS, LEGENDS, NOTES
- M1.1 BUILDING A - 1ST & 2ND FLOOR HVAC PLANS
- M1.2 BUILDING B - 3RD FLOOR HVAC PLAN
- M1.3 BUILDING B - 1ST & 2ND FLOOR HVAC PLANS
- M1.4 BUILDING B - 3RD FLOOR HVAC PLAN
- M1.5 BUILDING C - 1ST & 2ND FLOOR HVAC PLAN
- M1.6 BUILDING C - 3RD FLOOR HVAC PLAN
- M4.1 ENLARGED 1ST/2ND FLOOR APARTMENT HVAC PLANS
- M4.2 ENLARGED 3RD FLOOR APARTMENT HVAC PLANS
- M6.1 SCHEDULES AND DETAILS
- P0.1 PLUMBING ABBREVIATIONS, LEGENDS, NOTES
- P1.1 BUILDING A - UNDERFLOOR & 1ST FLOOR WASTE & VENT PLANS
- P1.2 BUILDING A - 2ND & 3RD FLOOR WASTE & VENT PLANS
- P1.3 BUILDING B - UNDERFLOOR & 1ST FLOOR WASTE & VENT PLANS
- P1.4 BUILDING B - 2ND & 3RD FLOOR WASTE & VENT PLANS
- P1.5 BUILDING C - UNDERFLOOR & 1ST FLOOR WASTE & VENT PLANS
- P1.6 BUILDING C - 2ND & 3RD FLOOR WASTE & VENT PLANS
- P1.7 BUILDING A & B - FIRST FLOOR DOMESTIC WATER PLANS
- P1.8 BUILDING C - FIRST FLOOR DOMESTIC WATER PLANS
- P4.1 ENLARGED APARTMENT DOMESTIC WATER PLANS
- P4.2 ENLARGED APARTMENT & CLUBHOUSE DOMESTIC WATER PLANS
- P6.1 SCHEDULES AND DETAILS
- P9.1 WASTE & VENT RISER DIAGRAMS
- P9.2 WASTE & VENT RISER DIAGRAMS
- P9.3 APARTMENT WATER SERVICE RISER DIAGRAMS

CONSTRUCTION SET (thru ASI 8) 1-20-2026

GENERAL PROJECT INFORMATION

FIRE RESISTANCE RATING FOR BUILDING ELEMENTS: V-B

EXTERIOR BEARING WALLS:	0 HOUR
STRUCTURAL FRAME:	0 HOUR
INTERIOR BEARING WALLS:	0 HOUR
INTERIOR NON-BEARING WALLS:	0 HOUR
STAIRS:	0 HOUR
FLOOR/CEILING ASSEMBLY:	0 HOUR
BETWEEN DWELLINGS:	1 HOUR
CEILING/ROOF ASSEMBLY:	0 HOUR
CORRIDOR/DWELLING UNITS:	1/2 HOUR
DWELLING UNITS - 1 HR FIRE PARTITIONS:	

ROOF COVERINGS
CLASS C OR BETTER

REQUIRED SEPARATION OF OCCUPANCIES (PER IBC 508.2.4 & TABLE 508.4)

USES ARE NOT SEPARATED BY FIRE BARRIERS. CONSTRUCTION IS BASED ON THE MOST RESTRICTIVE USE.
DWELLING UNITS - 1 HR FIRE PARTITIONS

AUTOMATIC FIRE SUPPRESSION SYSTEM:

REQUIRED, PROVIDED PER NFPA 13R - ENTIRE BUILDING

DRAFTSTOPPING (PER IBC 718.4)

DRAFTSTOPPING SHALL BE INSTALLED IN LINE WITH UNIT SEPARATION WALLS THAT DO NOT EXTEND TO THE ROOF SHEATHING OR ATTIC SPACE MAY BE SUBDIVIDED INTO AREAS NOT EXCEEDING 3,000 SF OF ABOVE EVERY TWO DWELLING UNITS, WHICHEVER IS SMALLER.
OPENING IN THE PARTITIONS SHALL BE PROTECTED BY SELF-CLOSING DOORS WITH AUTOMATIC LATCHES CONSTRUCTED AS REQUIRED FOR THE PARTITIONS.

PORTABLE FIRE EXTINGUISHERS

REQUIRED - PROVIDED.
EACH DWELLING UNIT SHALL BE PROVIDED WITH A PORTABLE FIRE EXTINGUISHER HAVING A MINIMUM RATING OF 1-A:10-B:C

SMOKE CONTROL: SMOKE PARTITIONS: STANDPIPES:

NOT REQUIRED NOT REQUIRED NOT REQUIRED (TOP FLR <30')

FIRE ALARM REQUIREMENTS:

REQUIRED, PROVIDED - MANUAL & AUTOMATIC FIRE ALARM SYSTEM PER NFPA 72
SIGNALING SYSTEM IS AUDIBLE/VISUAL PER NFPA 72 & ADA INSTALLED THROUGHOUT
INITIATING DEVICES: PULL STATIONS; SMOKE DETECTION @ SLEEPING & COMMON AREAS, SPRINKLER SYSTEM FLOW AND TAMPER SWITCHES MONITORED.

SMOKE ALARM REQUIREMENTS:

REQUIRED, PROVIDED - SLEEPING ROOMS, OUTSIDE SLEEPING ROOMS & AT EACH FLOOR

EMERGENCY POWER SOURCE:

EXIT SIGNS, EXIT ILLUMINATION & EMERGENCY LIGHTING IS BY BATTERY BACK-UP

BUILDING A INFORMATION

OCCUPANCY OVERALL: RESIDENTIAL

CONSTRUCTION TYPE: V-B

OCCUPANCY BASIC: R-2 APARTMENTS
B BUSINESS

ALLOWABLE AREA INCREASE: **ACTUAL BUILDING AREA:**

	R-2		
BASE ALLOWABLE	7,000 SF	FIRST FLOOR	9,537 SF
FRONTAGE INCREASE (74%)	4,130 SF	SECOND FLOOR	8,126 SF
TOTAL FLOOR ALLOWABLE	11,130 SF	THIRD FLOOR	8,126 SF
		TOTAL BLDG AREA	25,789 SF

*BUILDING HAS AN NFPA 13R SPRINKLER SYSTEM. SECTION 903.3.1.2

*ALLOWABLE AREA AND HEIGHT BASED ON DIFFERENT USES NOT BEING SEPARATED BY FIRE BARRIERS. MOST RESTRICTIVE ALLOWANCE.

BASIC ALLOWABLE STORIES: 3 **ACTUAL STORIES:** 3

BASIC ALLOWABLE HEIGHT: 60' **ACTUAL HEIGHT:** 42'-2"

(PER IBC TABLE 504.4) (PER IBC TABLE 504.3)

TOTAL OCCUPANT LOAD: 126

EXITING - REFERENCE PLAN

OCCUPANT LOAD FACTORS: (TABLES 1004.5 & 1006.2.1)

OCCUPANCY	USE	LOAD FACTOR	MAX.OCC./STRY 1 EXIT
R-2	APARTMENT	200 sf/OCCUPANT	10
A-3	CLUB ROOM	15 sf/OCCUPANT	49
B	OFFICE	100 sf/OCCUPANT*	49
S-1	STORAGE	300 sf/OCCUPANT	29
M	MECHANICAL	300 sf/OCCUPANT	49

BUILDING B INFORMATION

OCCUPANCY OVERALL: RESIDENTIAL

CONSTRUCTION TYPE: V-B

OCCUPANCY BASIC: R-2 APARTMENTS

ALLOWABLE AREA INCREASE: **ACTUAL BUILDING AREA:**

	R-2		
BASE ALLOWABLE	7,000 SF	FIRST FLOOR	8,194 SF
FRONTAGE INCREASE (67.0%)	4,690 SF	SECOND FLOOR	8,126 SF
TOTAL FLOOR ALLOWABLE	11,690 SF	THIRD FLOOR	8,126 SF
		TOTAL BLDG AREA	24,446 SF

*BUILDING HAS AN NFPA 13R SPRINKLER SYSTEM. SECTION 903.3.1.2

BASIC ALLOWABLE STORIES: 3 **ACTUAL STORIES:** 3

BASIC ALLOWABLE HEIGHT: 60' **ACTUAL HEIGHT:** 42'-2"

(PER IBC TABLE 504.4) (PER IBC TABLE 504.3)

TOTAL OCCUPANT LOAD: 132

EXITING - REFERENCE PLAN

OCCUPANT LOAD FACTORS: (TABLES 1004.5 & 1006.2.1)

OCCUPANCY	USE	LOAD FACTOR	MAX.OCC./STRY 1 EXIT
R-2	APARTMENT	200 sf/OCCUPANT	10

BUILDING C INFORMATION

OCCUPANCY OVERALL: RESIDENTIAL

CONSTRUCTION TYPE: V-B

OCCUPANCY BASIC: R-2 APARTMENTS

ALLOWABLE AREA INCREASE: **ACTUAL BUILDING AREA:**

	R-2		
BASE ALLOWABLE	7,000 SF	FIRST FLOOR	8,891 SF
FRONTAGE INCREASE (67.0%)	4,690 SF	SECOND FLOOR	8,823 SF
TOTAL FLOOR ALLOWABLE	11,690 SF	THIRD FLOOR	8,823 SF
		TOTAL BLDG AREA	26,537 SF

*BUILDING HAS AN NFPA 13R SPRINKLER SYSTEM. SECTION 903.3.1.2

BASIC ALLOWABLE STORIES: 3 **ACTUAL STORIES:** 3

BASIC ALLOWABLE HEIGHT: 60' **ACTUAL HEIGHT:** 42'-2"

(PER IBC TABLE 504.4) (PER IBC TABLE 504.3)

TOTAL OCCUPANT LOAD: 102

EXITING - REFERENCE PLAN

OCCUPANT LOAD FACTORS: (TABLES 1004.5 & 1006.2.1)

OCCUPANCY	USE	LOAD FACTOR	MAX.OCC./STRY 1 EXIT
R-2	APARTMENT	200 sf/OCCUPANT	10

PROJECT INFORMATION

TYPE OF CONSTRUCTION: NEW CONSTRUCTION

FACILITY NAME: THE RESERVES AT COBALT CIRCLE

FACILITY ADDRESS: 1616 E. JEFFERSON STREET

COUNTY: HAYWOOD COUNTY

WATER SUPPLY: CITY OF BROWNSVILLE, TN

LOCAL BUILDING: CITY OF BROWNSVILLE, TN

INSPECTION DEPARTMENT: TENNESSEE STATE FIRE MARSHAL'S OFFICE

INSPECTION JURISDICTION: TENNESSEE STATE FIRE MARSHAL'S OFFICE

LOCAL FIRE DEPARTMENT: CITY OF BROWNSVILLE, TN

FIRE CHIEF: LYN SANDERS

PHONE: 731-772-1396

EMAIL: LSANDERS@BROWNSVILLETN.GOV

ADDRESS: 19 WEST FRANKLIN, BROWNSVILLE, TN 38012

ARCHITECT: JONES GILLAM RENZ ARCHITECTS

730 N. NINTH ST.; SALINA, KS 67401


TENNESSEE STATE FIRE MARSHAL'S ADOPTED CODES

- 2021 INTERNATIONAL BUILDING CODE
- 2021 FUEL GAS CODE
- 2021 INTERNATIONAL MECHANICAL CODE
- 2021 INTERNATIONAL PLUMBING CODE
- 2021 INTERNATIONAL FIRE CODE
- 2021 INTERNATIONAL ENERGY CONSERVATION CODE
- 2021 NFPA LIFE SAFETY CODE
- 2017 NATIONAL ELECTRIC CODE
- FAIR HOUSING ACT DESIGN MANUAL
- 2010 ADA STANDARDS FOR ACCESSIBLE DESIGN
- 2017 ICC A117.1 ACCESSIBLE & USABLE BUILDINGS AND FACILITIES

CITY OF BROWNSVILLE, TN ADOPTED CODES

- 2018 INTERNATIONAL BUILDING CODE
- 2018 INTERNATIONAL MECHANICAL CODE
- 2018 INTERNATIONAL PLUMBING CODE
- 2017 NATIONAL ELECTRIC CODE
- 2018 INTERNATIONAL FIRE CODE
- 2021 INTERNATIONAL ENERGY CONSERVATION CODE
- FAIR HOUSING ACT DESIGN MANUAL
- 2010 ADA STANDARDS FOR ACCESSIBLE DESIGN
- 2009 ICC A117.1 ACCESSIBLE & USABLE BUILDINGS AND FACILITIES

NOTE: UNLESS NOTED OTHERWISE (WITH AN *), THE PLANS AND DESIGNS FOLLOW THE MORE STRINGENT OF THE CODES AS LISTED ABOVE. THUS, THE DESIGNS FOLLOW THE 2021 CODES AS LISTED UNDER THE STATE FIRE MARSHAL. ON RARE OCCASION, THE DESIGNS MAY FOLLOW THE 2018 CODES AS LISTED UNDER BROWNSVILLE. THESE INSTANCES WILL BE NOTED AS SUCH.

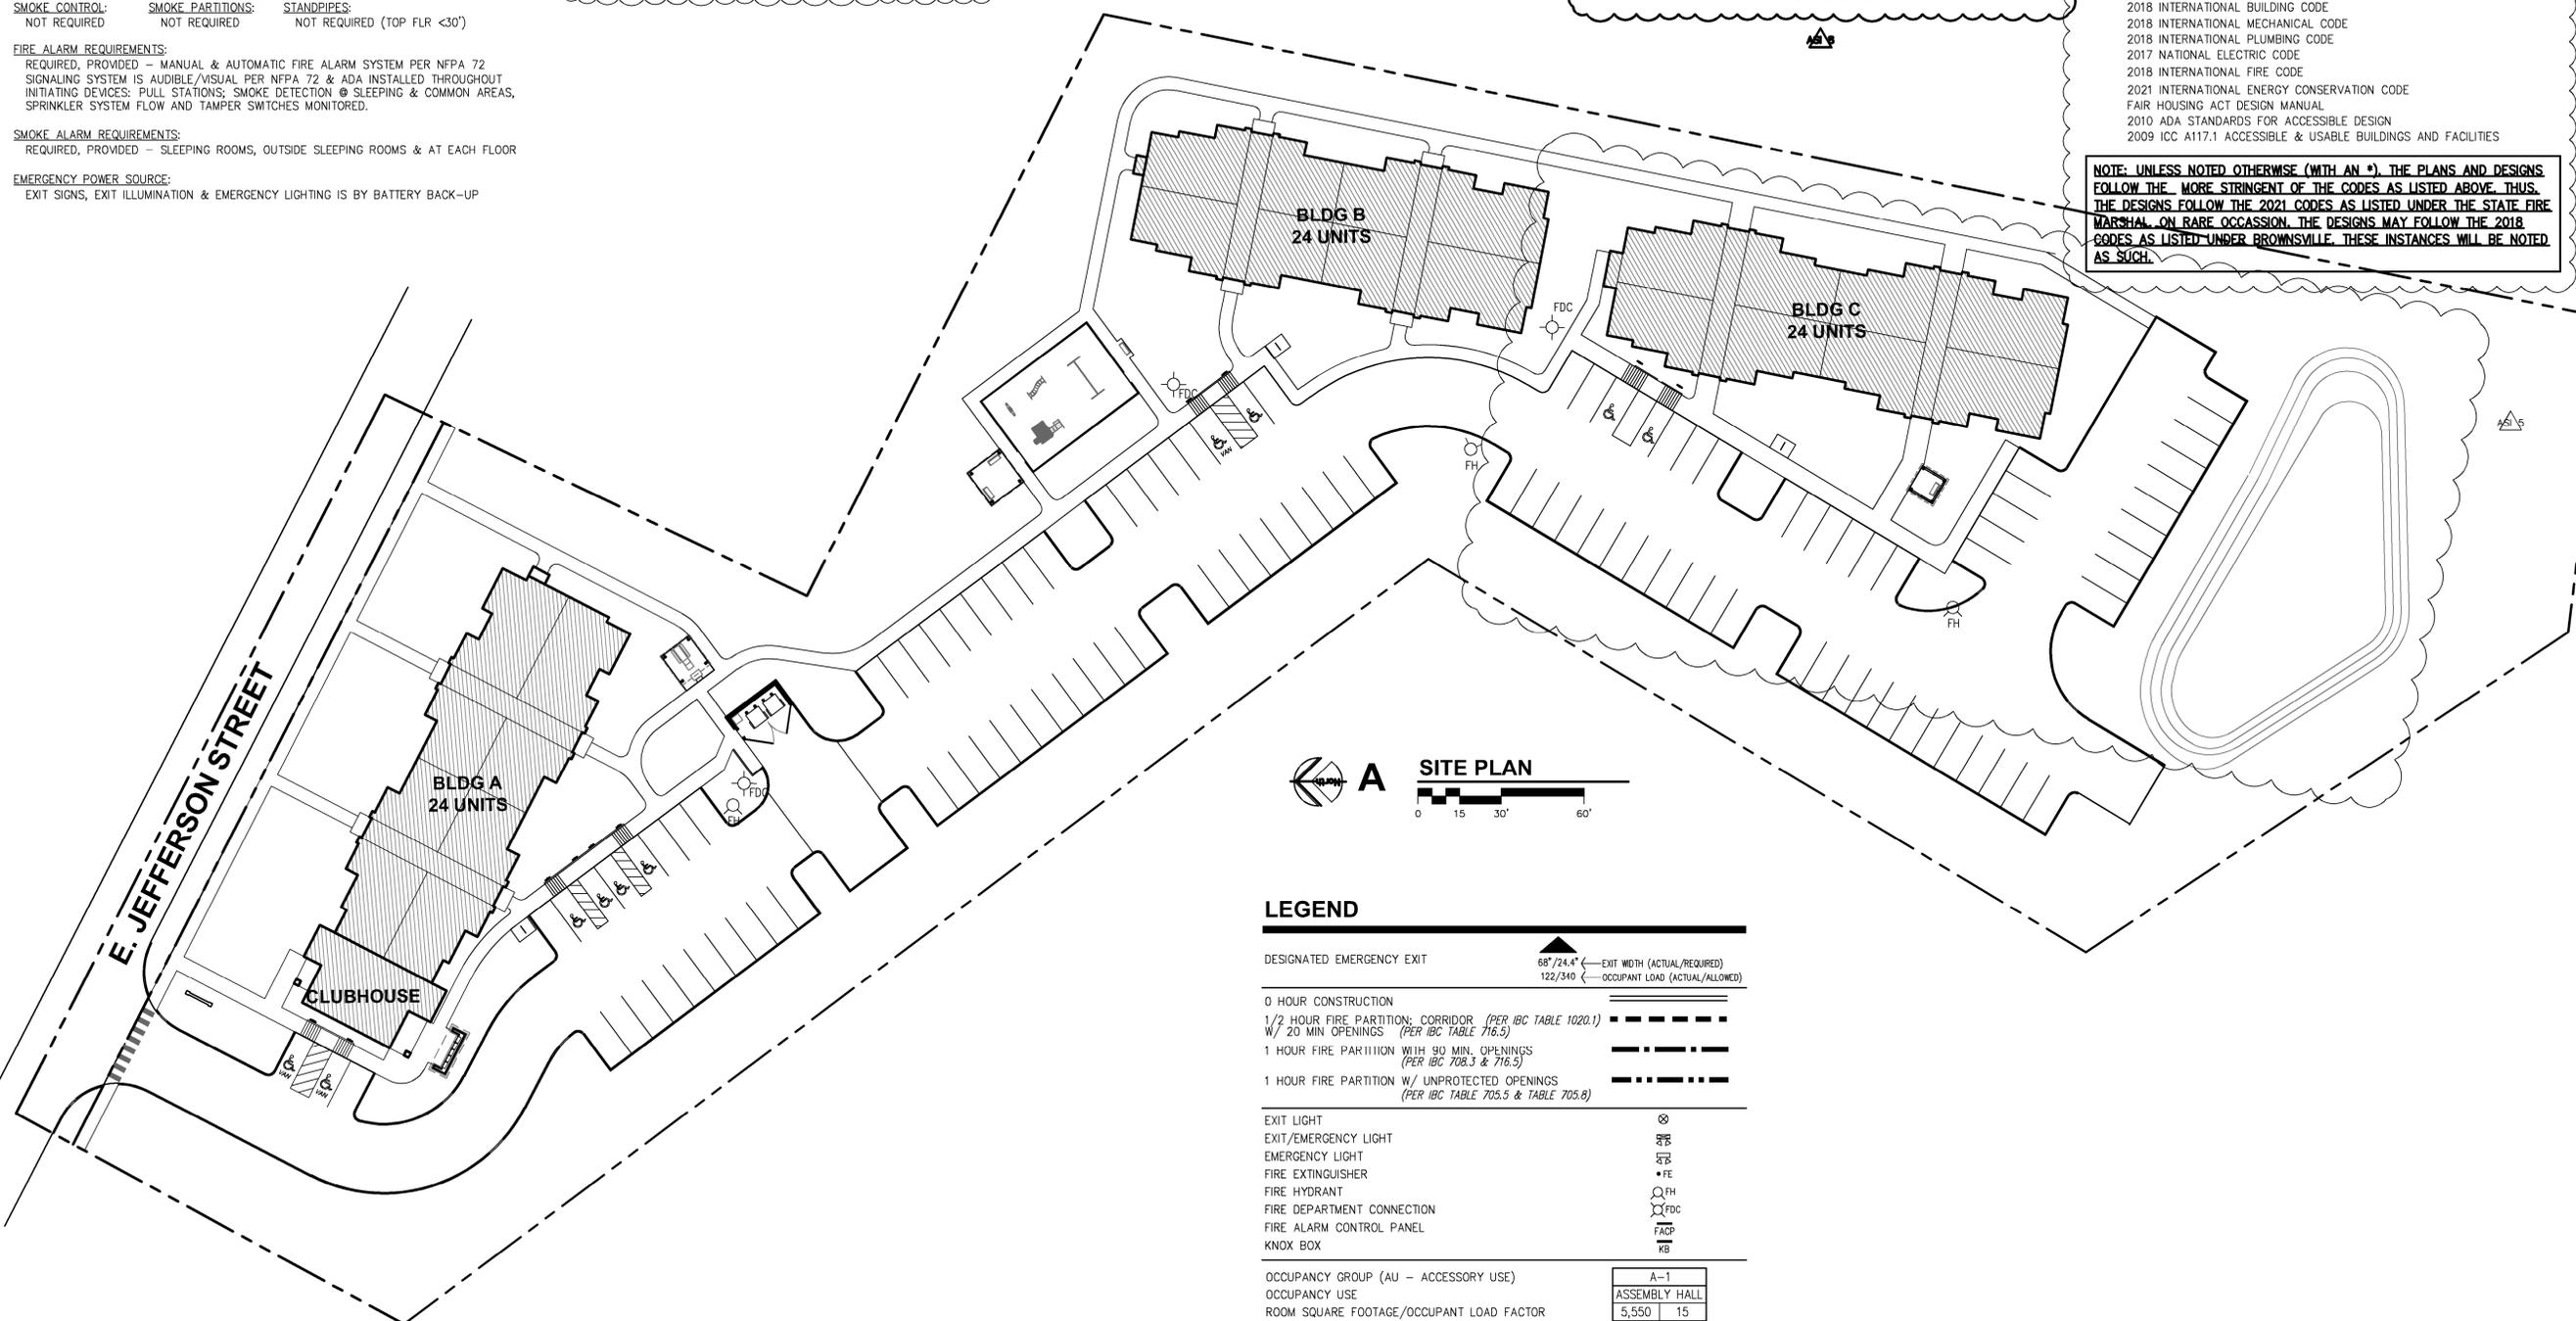

LEGEND

DESIGNATED EMERGENCY EXIT	▲	68"/24.4" (← EXIT WIDTH (ACTUAL/REQUIRED))
	▲	122/340 (← OCCUPANT LOAD (ACTUAL/ALLOWED))
0 HOUR CONSTRUCTION	---	
1/2 HOUR FIRE PARTITION; CORRIDOR (PER IBC TABLE 1020.1)	---	
W/ 20 MIN OPENINGS (PER IBC TABLE 716.5)	---	
1 HOUR FIRE PARTITION WITH 90 MIN. OPENINGS (PER IBC 708.3 & 716.5)	---	
1 HOUR FIRE PARTITION W/ UNPROTECTED OPENINGS (PER IBC TABLE 705.5 & TABLE 705.8)	---	
EXIT LIGHT	⊗	
EXIT/EMERGENCY LIGHT	⊗	
EMERGENCY LIGHT	⊗	
FIRE EXTINGUISHER	• FE	
FIRE HYDRANT	⊗ FH	
FIRE DEPARTMENT CONNECTION	⊗ FDC	
FIRE ALARM CONTROL PANEL	⊗ FACP	
KNOX BOX	⊗ KB	
OCCUPANCY GROUP (AU - ACCESSORY USE)	A-1	
OCCUPANCY USE	ASSEMBLY HALL	
ROOM SQUARE FOOTAGE/OCCUPANT LOAD FACTOR	5,550 15	
OCCUPANT LOAD/REQUIRED NUMBER OF EXITS	370 2	

JonesGillamRenz
 1881 Main Street, Suite 301
 Salina, KS 67401
 Kansas City, MO 64108
 jgr@jgarchitects.com
 785.827.0386


JGR

THE RESERVES AT COBALT CIRCLE
 NEW APARTMENTS
 BROWNSVILLE,
 TENNESSEE


WARGRET J. CLAWSON
 REGISTERED PROFESSIONAL ARCHITECT
 No. 10788
 STATE OF TENNESSEE
 1-20-2026

REVISION:
 10-30-2025
 12-5-2025
 1-20-2026
 DATE: 5-9-2025
 JOB: 24-3446
 SHEET NO.:
CFP1
 COPYRIGHTED ©

- GENERAL NOTES**
- REF. SHEET A1.1 FOR LOCATION & ORIENTATION OF BUILDINGS.
 - REF. SHEET A2.11 FOR BREEZEWAY, MECH & FIRE CLOSETS FINISH & DOOR SCHEDULES.
 - F.O.S. = FACE OF STUD.
 - REF. STRUCTURAL DRAWINGS FOR SHEAR WALL LOCATIONS.
 - TYPICAL GROUND FLOOR FINISH FLOOR ELEVATION IS REFERENCED AS 100'-0". CONTRACTOR SHALL VERIFY BUILDING ELEVATION WITH SITE CIVIL DRAWINGS.
 - CONTRACTOR SHALL PROVIDE FIREBLOCKING, ANCHOR BOLTS, AND ANY REQUIRED SHEAR WALL BLOCKING AS REQUIRED BY STRUCTURAL DRAWINGS.
 - CONTRACTOR TO PROVIDE FIRE BLOCKING AT PARTY WALL AT 10'-0" O.C., TYPICAL. CONTRACTOR TO PROVIDE FIRE BLOCKING AT PARTY WALL AT ALL BACK TO BACK ELECTRICAL OUTLETS, PROVIDED AND INSTALL ALL FIRE BLOCKING AND DRAFTSTOPS PER 2021 IBC, SECTION 718.2, 718.3 & 718.4.
 - FIRE EXTINGUISHERS SHALL BE INSTALLED & PROVIDED IN ACCORDANCE WITH NFPA 10 & 2021 IBC, SECTION 906.1. LOCATED PER OFF SHEET.
 - ALL PENETRATIONS THRU BATED WALLS AND/OR FLOOR ASSEMBLIES SHALL BE FIRESTOPPED PER APPROVED U.L. DESIGNS. REFERENCE SHEET A4.9 FOR FIRE PENETRATION ASSEMBLIES.
 - ALL SIGNAGE MUST COMPLY W/ ADA 2010 SECTIONS 216 & 703 FOR SIZE, LOCATION AND FABRICATION.
- KEY NOTES**
- FIRE LINE IN INSULATED BULKHEAD ADD'L WATER LINES TO BE UNDERGROUND REF. MECH DWGS & SHEET A6.1. COORDINATE LOCATION OF BULKHEAD.
 - MECH. CLOSET 1st FLOOR ONLY. REF. SITE PLAN & MECH DWGS. FULLY INSULATE WALLS & CEILING.
 - RADON PIPE THROUGH ROOF. REF. N-A4.5 & MECH DWGS.
 - KNOX BOX REF. SHEET A1.1 FOR LOCATION.
 - METER CENTER LOCATON REF. ELECT. DWGS.
 - FEC - FIRE EXTINGUISHER & CABINET.
- APARTMENT CHART**
- SYMBOL INDICATES ACCESSIBLE UNITS
A102, A104, A106, A108
- SYMBOL INDICATES A HEARING & VISION IMPAIRED ACCESSIBLE UNIT
A101, A105
- ALL OTHER UNITS:
 • ADAPTABLE (TYPE-B) UNITS ON FIRST FLOOR
 • STANDARD UNITS ON SECOND/THIRD FLOORS

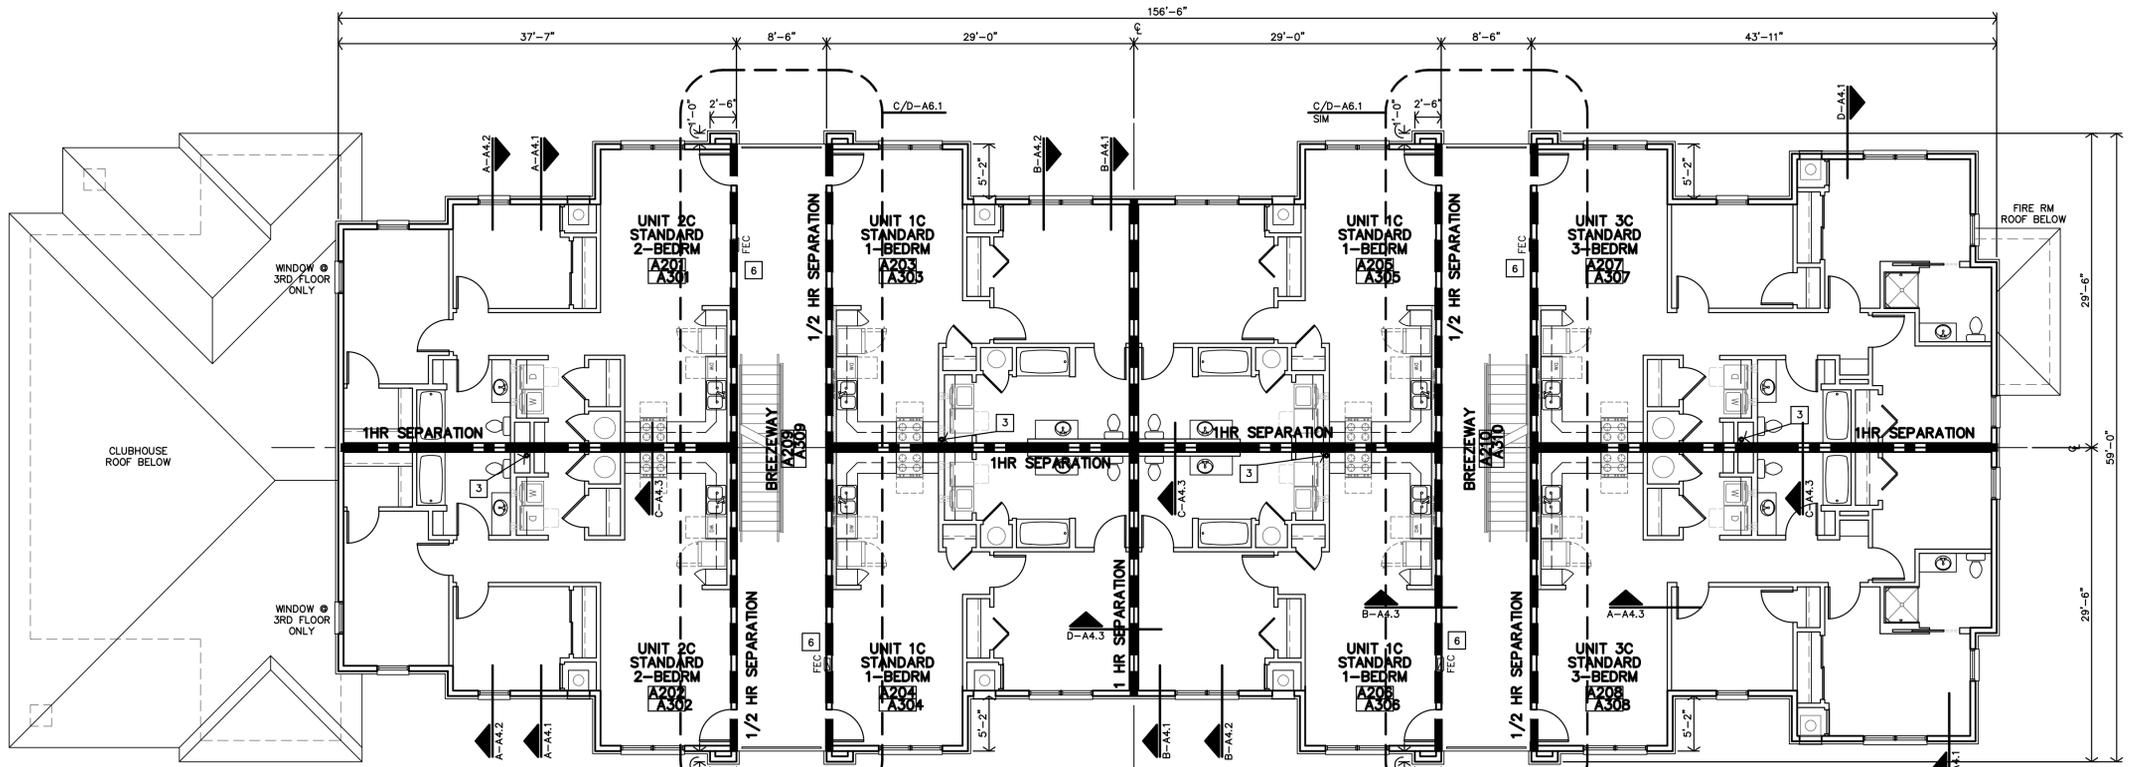

B
BUILDING A
SECOND FLOOR PLAN
THIRD FLOOR PLAN (SIM)
 1/8"=1'-0"

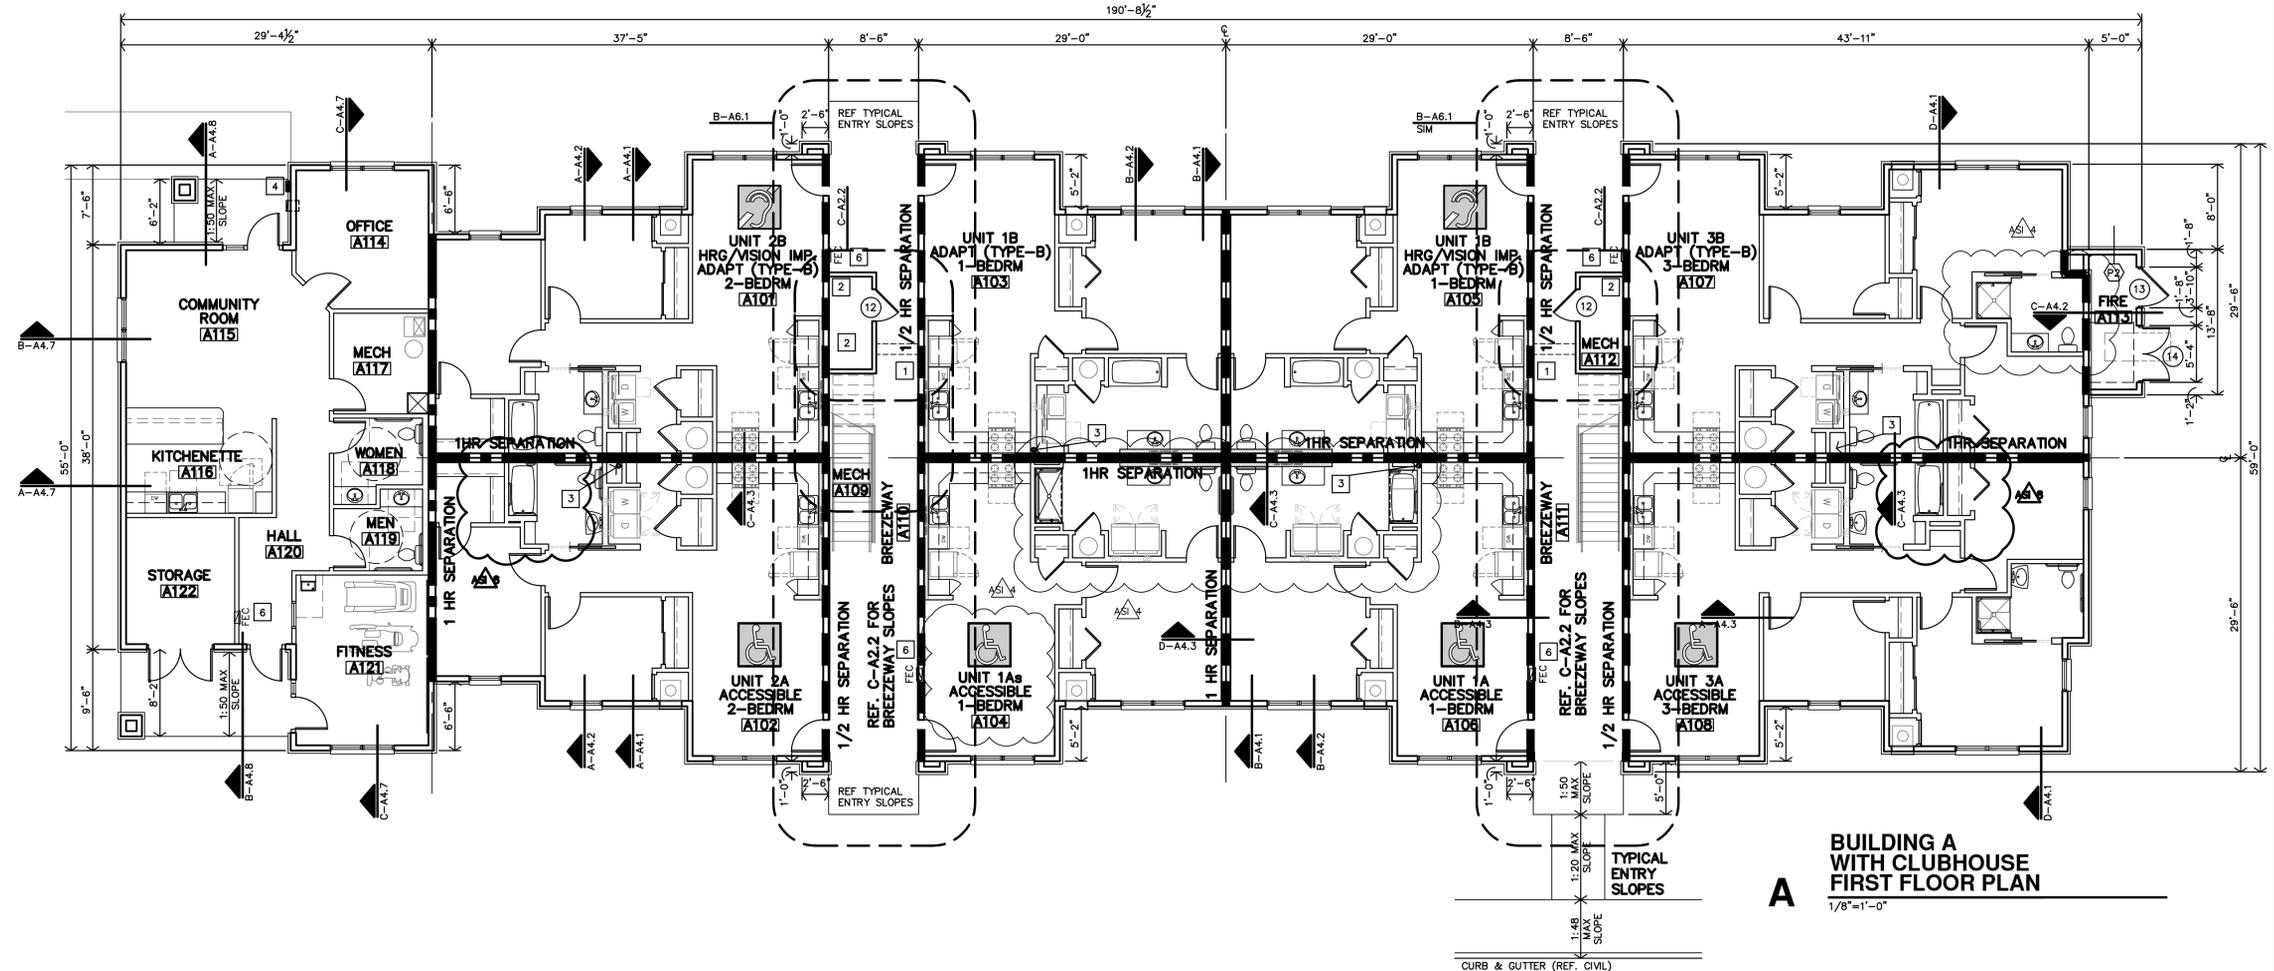


A
BUILDING A
WITH CLUBHOUSE
FIRST FLOOR PLAN
 1/8"=1'-0"




REVISION:	
10-30-2025	
1-20-2026	
DATE:	5-9-2025
JOB:	24-3446
SHEET NO.:	

APARTMENT PARTITION SCHEDULE

- PARTITION NOTES:**
- SHEAR WALLS: REF. STRUCTURAL FOR LOCATIONS, MATERIAL & SECTIONS
 - EXTERIOR SHEAR WALLS: CONTRACTOR TO EXTEND SHEAR WALL MATERIAL TO CORNER OF WALL, TO ENSURE FLUSH WITH EXTERIOR FINISH MATERIALS. REFERENCE STRUCT. DWGS FOR MORE NOTES AND DETAILS.
 - FIRE BLOCKING REQUIRED PER 2021 IBC SEC. 708 & 718. (1) LAYER - 5/8" TYPE X G.B. OR 1/2" PLYWOOD TO EXTEND THRU SPACE ELECTRICAL OUTLETS. (2) LAYER - 5/8" TYPE X G.B. OR 1/2" PLYWOOD TO EXTEND THRU SPACE




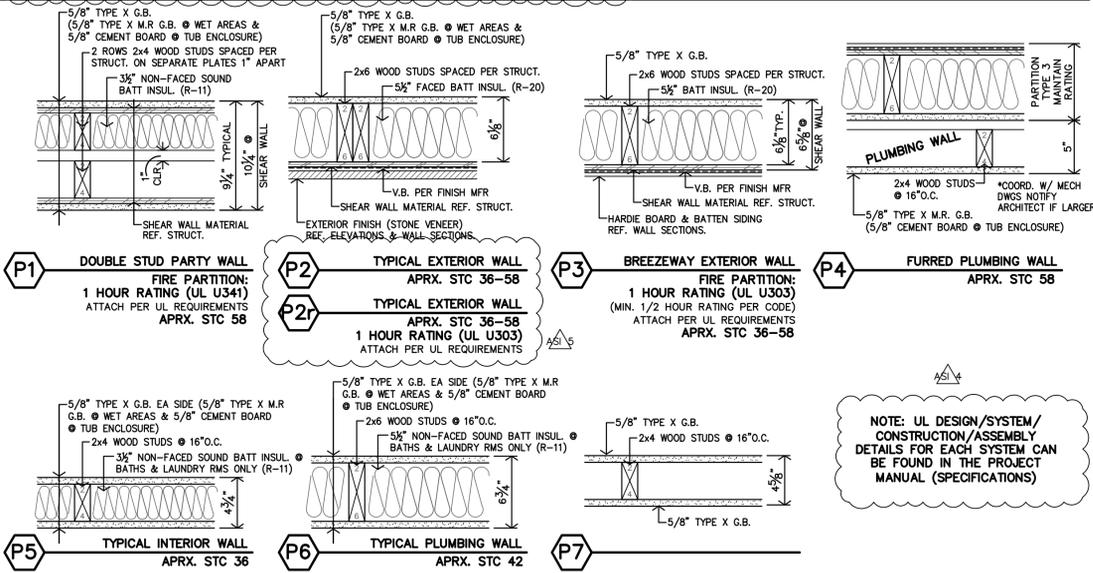


ASSEMBLY SCHEDULE

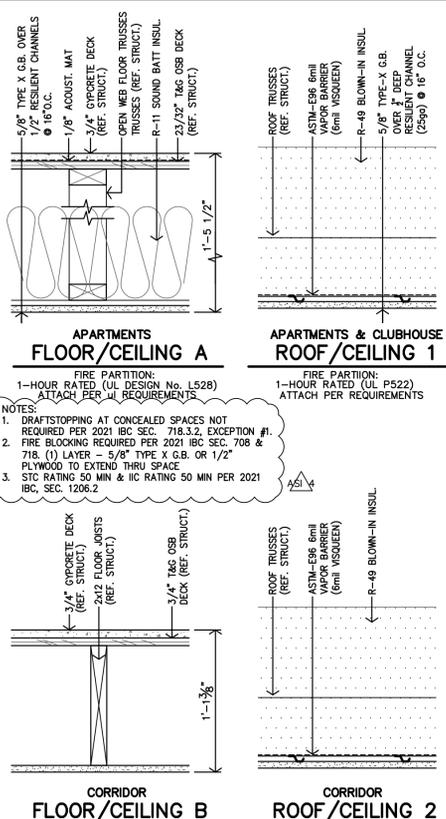

PLAN NOTES

- REF. SHEET A2.3 FOR APARTMENT GENERAL NOTES.
- REF. SHEET A2.5 FOR APARTMENT FINISH & DOOR SCHEDULES.
- FOR UL ASSEMBLY/ATTACHMENT DETAILS - REF. SPECIFICATIONS & PROJECT MANUAL.
- REF. SHEET A2.10 FOR APARTMENT BATH ACCESSIBLE DETAILS.
- REF. SHEET A2.8 FOR APARTMENT CASEWORK SECTIONS.

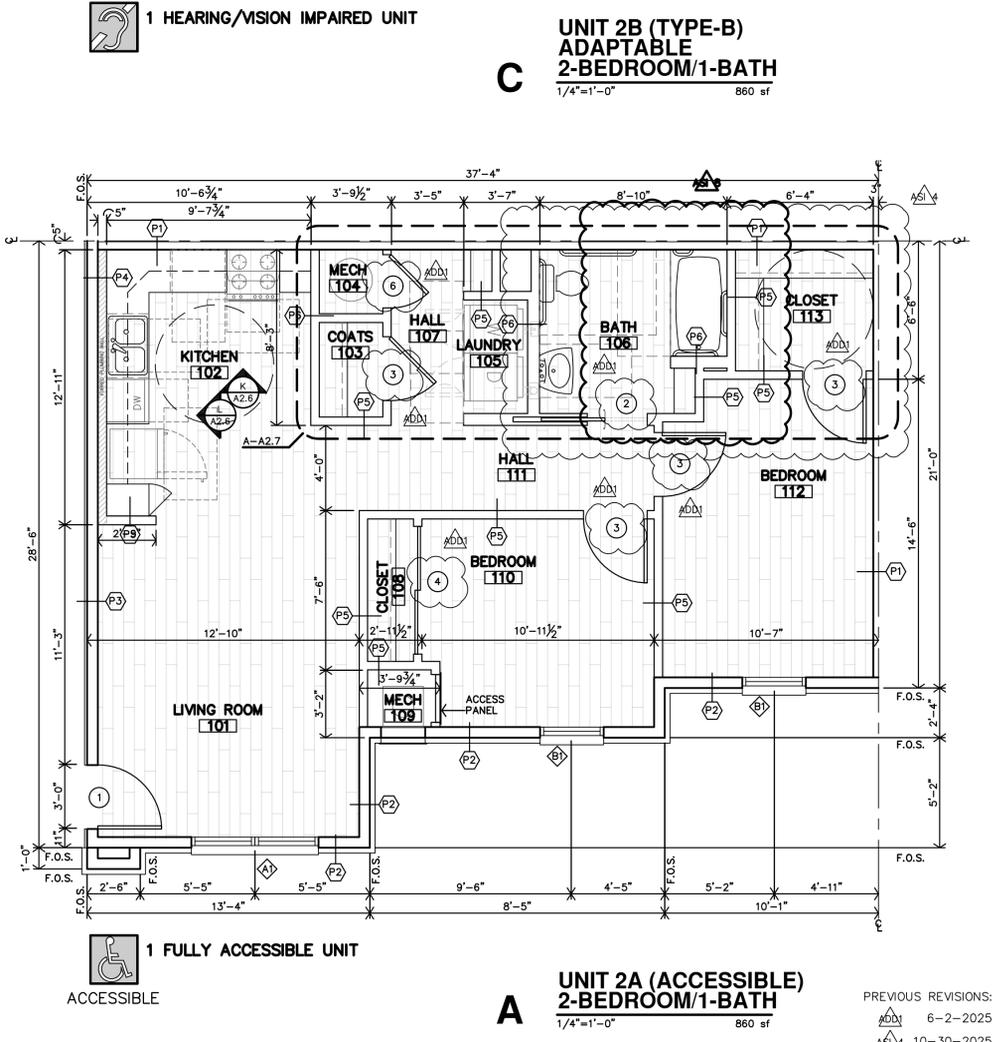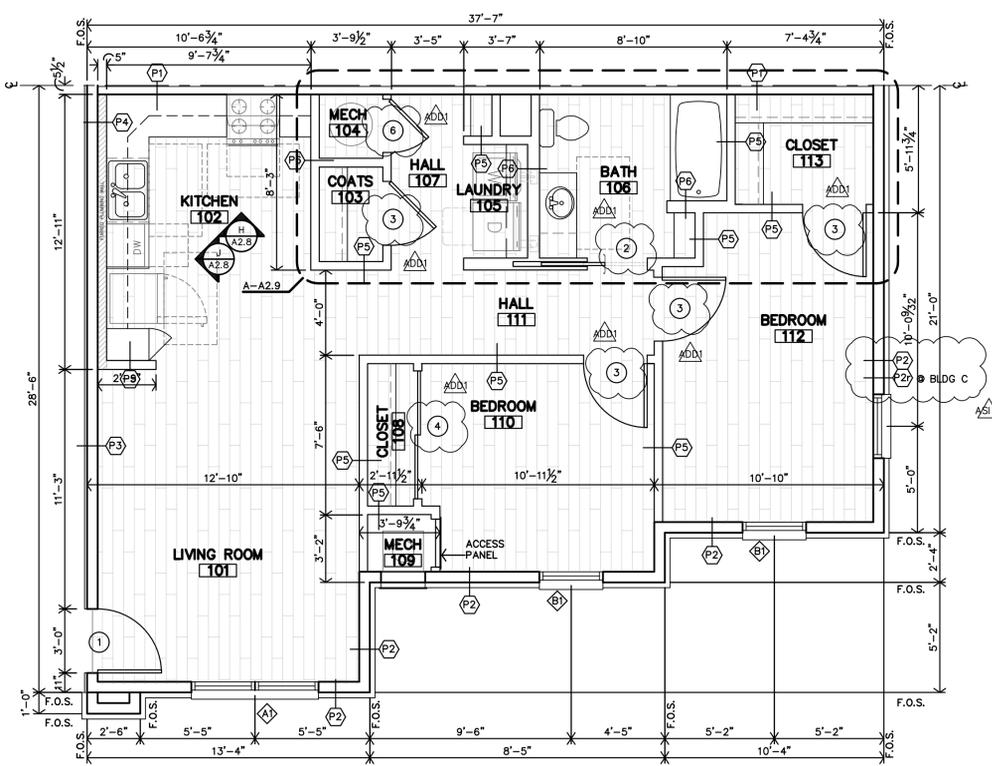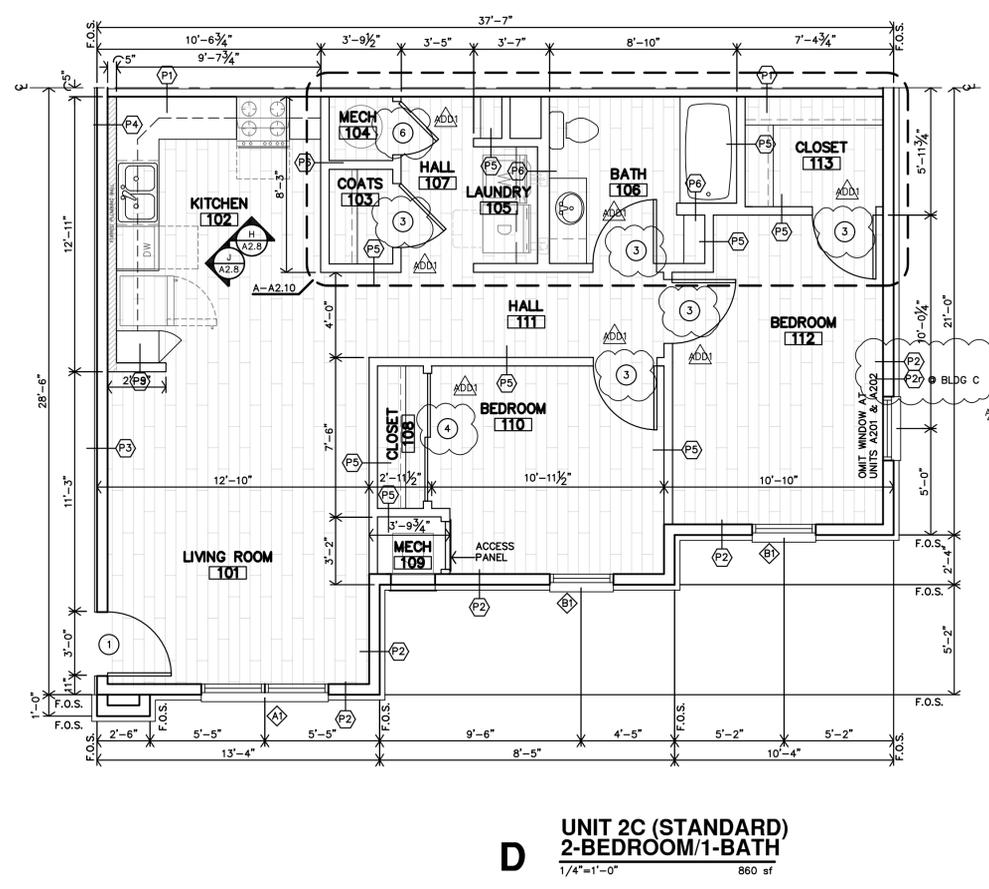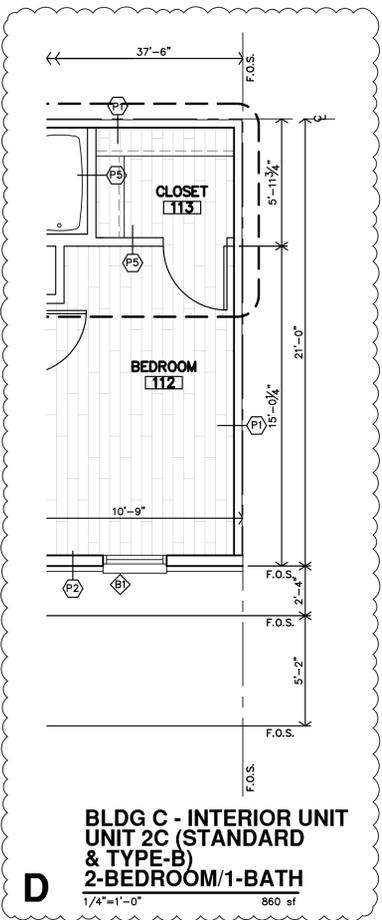

JonesGillamRenz
730 N. Ninth 1881 Main Street, Suite 301
Salina, KS 67401
Kansas City, MO 64108
785.827.0386
jgr@jrgarchitects.com

JGR

THE RESERVES AT COBALT CIRCLE
NEW APARTMENTS
BROWNSVILLE, TENNESSEE

MARGARET J. GILLAM
REGISTERED PROFESSIONAL ARCHITECT
STATE OF TENNESSEE
12-5-2025

REVISION:	
AS	12-5-2025
AS	1-20-2026
DATE:	5-9-2025
JOB:	24-3446
SHEET NO.:	

A2.4

PREVIOUS REVISIONS:
ADD 6-2-2025
AS 10-30-2025


COPYRIGHTED ©

APARTMENT INTERIOR FINISH SCHEDULE										
FINISHES & INSTRUCTIONS										
P1 - LATEX ENAMEL			C1 - CARPET #1			V - VINYL PLANK FLR'G TILE				
P2 - EPOXY PAINT			C2 - CARPET #2			ST - SPRAY TEXTURE				
CT - CERAMIC TILE			SV - SHEET VINYL			S - SMOOTH				
						T - TEXTURED LIGHT KNOCKDOWN				
NO.	DESCRIPTION	FLOOR	BASE	N. WALL	E. WALL	S. WALL	W. WALL	CLG	HGT.	NOTES
101	LIVING ROOM	V	P1	P1	P1	P1	P1	ST	8'-0"	NOTE 1
102	KITCHEN	V	P1	P1	P1	P1	P1	ST	8'-0"	NOTE 1
103	COATS	V	P1	P1	P1	P1	P1	ST	8'-0"	NOTE 1
104	MECH	V	P1	P1	P1	P1	P1	ST	8'-0"	NOTE 1
105	LAUNDRY	V	P1	P1	P1	P1	P1	ST	8'-0"	NOTE 1
106	BATH	V	P1	P1	P1	P1	P1	ST	8'-0"	NOTE 1
107	HALL	V	P1	P1	P1	P1	P1	ST	8'-0"	NOTE 1, 2
108	CLOSET	V	P1	P1	P1	P1	P1	ST	8'-0"	NOTE 1, 2
109	MECH	V	P1	P1	P1	P1	P1	ST	8'-0"	NOTE 1, 2
110	BEDROOM	V	P1	P1	P1	P1	P1	ST	8'-0"	NOTE 1, 2
111	HALL	V	P1	P1	P1	P1	P1	ST	8'-0"	NOTE 1, 2
112	BEDROOM	V	P1	P1	P1	P1	P1	ST	8'-0"	NOTE 1, 2
113	CLOSET	V	P1	P1	P1	P1	P1	ST	8'-0"	NOTE 1, 2
114	NOT USED									
115	BEDROOM	V	P1	P1	P1	P1	P1	ST	8'-0"	NOTE 1, 2
116	CLOSET	V	P1	P1	P1	P1	P1	ST	8'-0"	NOTE 1, 2
117	BATH	V	P1	P1	P1	P1	P1	ST	8'-0"	NOTE 1, 2

NOTES: 1. INSTALL 5/8" TYPE X MR. G.B. @ ALL WET AREAS.
2. 5/8" CEMENT BOARD @ TUB & SHOWER ENCLOSURES.

WINDOW NOTES:

- 3/4" DBL SEALED INSULATED GLASS & SHALL HAVE A MIN. U-VALUE OF .27
- SAFETY GLASS SHALL BE LOCATED PER 2021 IBC SECTION 2406.4
- FOR WINDOWS W/ SILLS @ 6'-0" ABOVE GRADE SHALL HAVE OPENING CONTROL DEVICE PER ASTM 2090 & 2021 IBC SEC. 1030.1.1
- EMERGENCY ESCAPE & RESCUE: PER 2021 IBC SEC. 1030.2. 20" x 24" MIN. OPENINGS, 5.7ft MIN. AREA.
- TEMPERED GLASS IS REQUIRED AT ALL GLAZING PANELS WITHIN 18" OF THE FINISHED FLOOR.

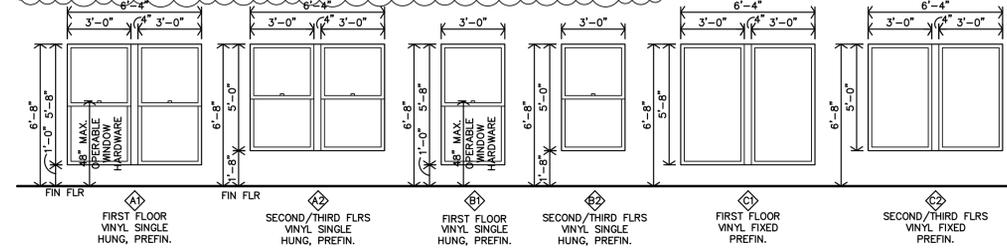


E APARTMENT WINDOW SCHEDULE

1/4"=1'-0"

APARTMENT DOOR SCHEDULE									
MARK	DOOR			FRAME		RATING	NOTES		
	W	H	T	MATERIAL	FINISH				
1	3'-0"	6'-8"	1 3/4"	MASONITE	WOOD H.C.	20min	NOTES 1,2,3,4		
2	3'-0"	6'-8"	1 3/8"	WOOD H.C.	WOOD H.C.		NOTE 7		
3	3'-0"	6'-8"	1 3/8"	WOOD H.C.	WOOD H.C.		NOTES 5,6,8		
4	PR3'-0"	6'-8"	1 3/8"	WOOD H.C.	WOOD H.C.		REF. A2.6		
5	PR2'-0"	6'-8"	1 3/8"	WOOD H.C.	WOOD H.C.		REF. A2.6		
6	2'-6"	6'-8"	1 3/8"	WOOD H.C.	WOOD H.C.		NOTE 9		
7	2'-6"	6'-8"	1 3/8"	WOOD H.C.	WOOD H.C.		NOTE 8		


GENERAL NOTES:
A. ALL DOOR HARDWARE TO BE LEVER TYPE LATCH SETS, KEYPED OUTSIDE & RELEASE INSIDE PER SPECIFICATIONS SEC. 8710
B. REF. SHEET A2.11 FOR BREEZEWAY DOOR SCHEDULE.

SPECIFIC NOTES:
1. ENTRY DOOR - HARDWARE TO BE LEVER TYPE LATCH SETS, KEYPED OUTSIDE & RELEASE INSIDE PER SPECIFICATIONS SEC. 8710 & 8710.1 W/ THUMB TURN INSIDE & NO KEY OUTSIDE W/ 1" MIN THROW. COORDINATE W/ MFR. FOR ADA INSTALLATION REQUIREMENTS. COORDINATE KEYPED REQUIREMENTS WITH OWNER.
2. ENTRY DOOR - PEEP HOLES @ STANDARD/TYP-B (ADAPTABLE) UNITS: (1) PEEP HOLE TO BE INSTALLED @ 60" AFF.
3. ENTRY DOOR - PEEP HOLES @ ACCESSIBLE UNITS: (2) PEEP HOLES TO BE INSTALLED @ 43" AFF & 60" AFF.
4. ENTRY DOOR - WEATHER STRIPPING TO BE INSTALLED.
5. BEDROOM & BATH DOORS - HARDWARE TO BE PRIVACY LEVER TYPE LATCH SET.
6. BEDROOM & BATH DOORS - UNDERCUT DOORS PER MECH DWGS 1" TYP.
7. POCKET DOOR - 32" MIN CLEAR OPENING, W/ ADA COMPLIANT HANDLE SIMILAR TO TRIMCO SERIES 106B.
8. CLOSET LINER DOORS - HARDWARE TO BE PASSAGE LEVER TYPE LATCH SET.
9. MECHANICAL DOORS - HARDWARE TO BE STORAGE LOCK LEVER TYPE LATCH SET.

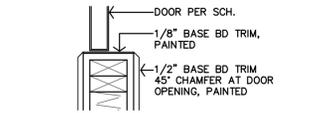


F TYP. BASE DETAIL @ BI-FOLD & BI-PASS DOOR

1/2"=1'-0"

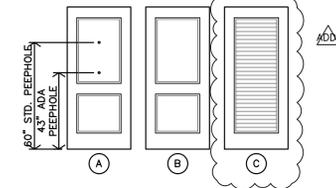

D APARTMENT DOOR TYPES

1/4"=1'-0"

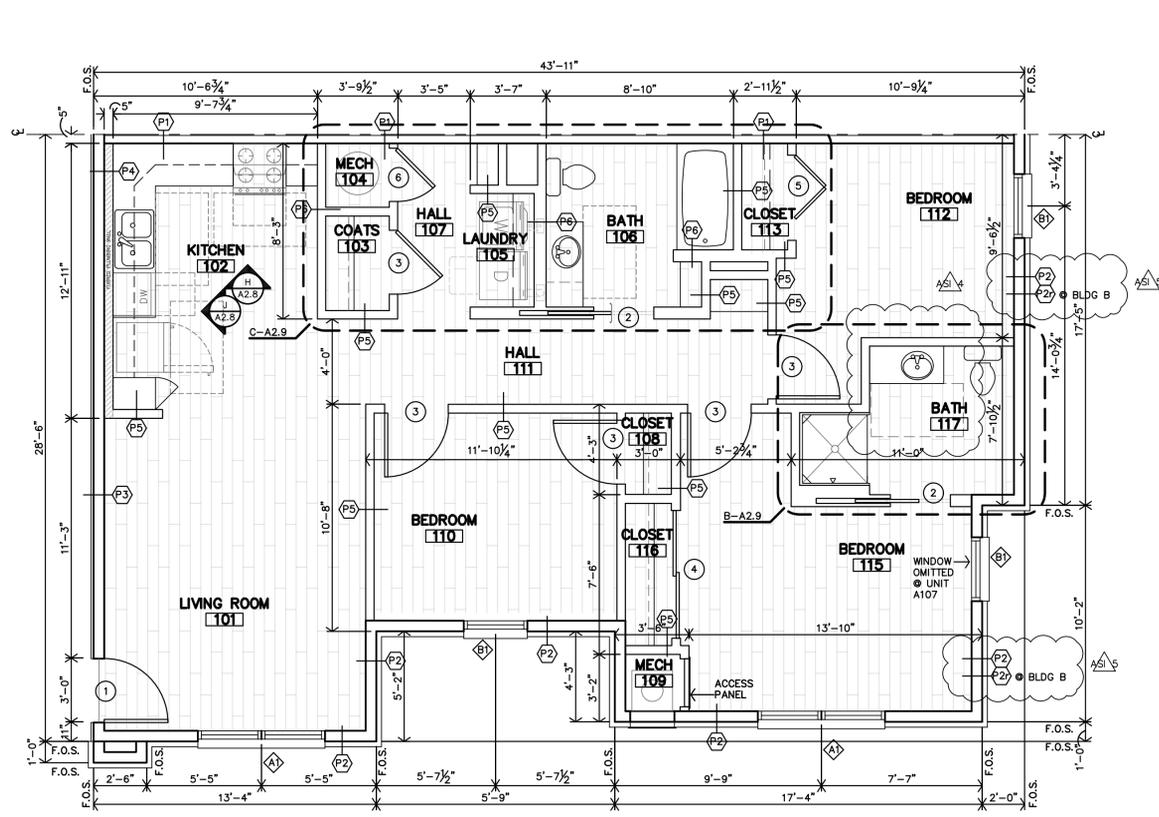


PLAN NOTES

- REF. SHEET A2.3 FOR APARTMENT GENERAL NOTES.
- REF. SHEET A2.4 FOR APARTMENT PARTITION TYPES & ASSEMBLY SCHEDULES.
- FOR U/I ASSEMBLY/ATTACHMENT DETAILS - REF. SPECIFICATIONS & PROJECT MANUAL.
- REF. SHEET A2.10 FOR APARTMENT BATH ACCESSIBLE DETAILS.
- REF. SHEET A2.8 FOR APARTMENT CASEWORK SECTIONS.


C UNIT 3B (TYPE-B) ADAPTABLE 3-BEDROOM/2-BATH

1/4"=1'-0" 1,083 sf

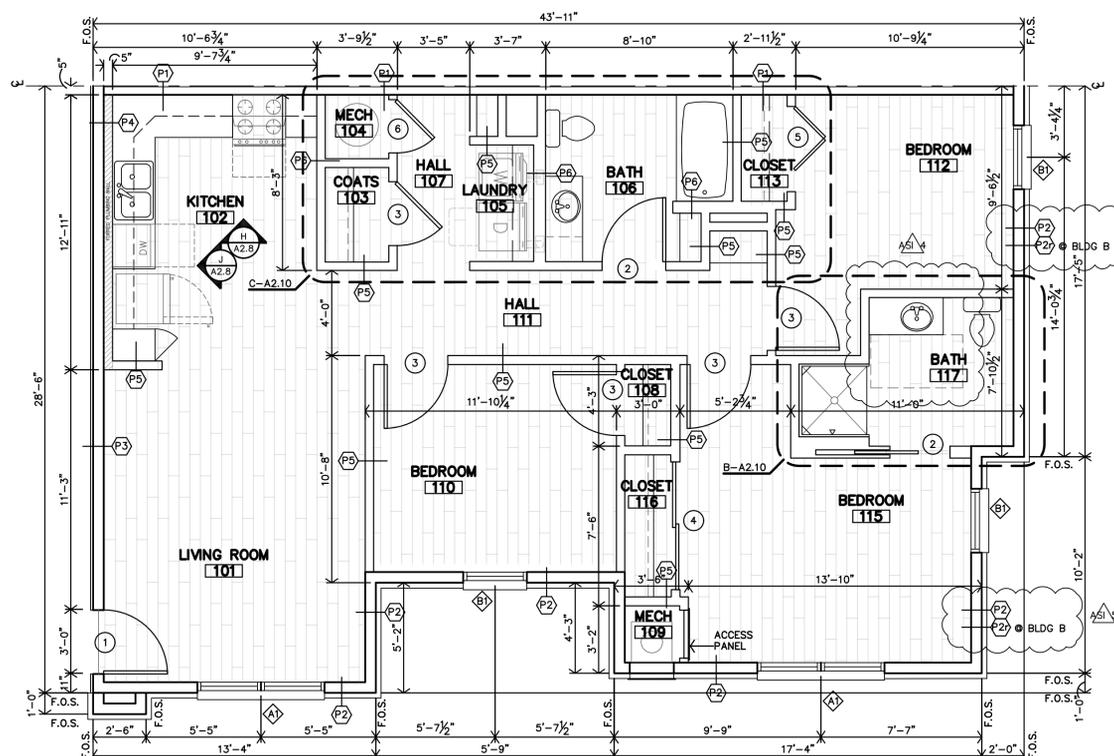

D UNIT 3C (STANDARD) 3-BEDROOM/2-BATH

1/4"=1'-0" 1,083 sf

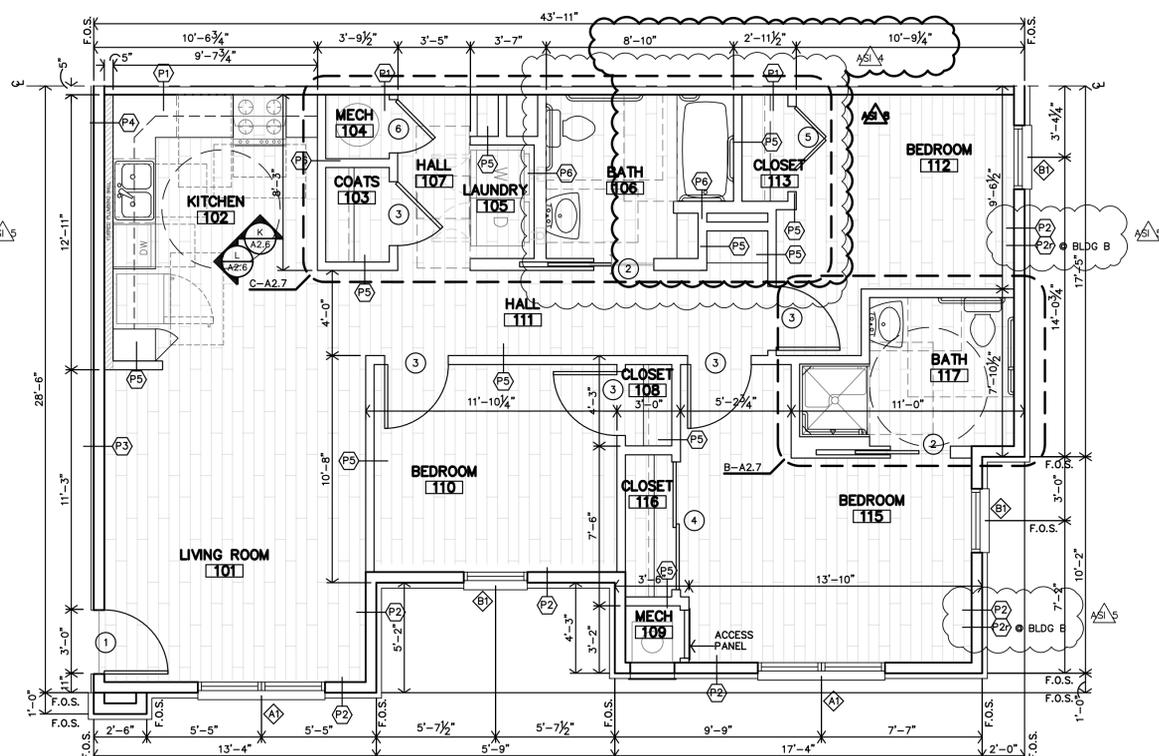

1 FULLY ACCESSIBLE UNIT

ACCESSIBLE


A UNIT 3A (ACCESSIBLE) 3-BEDROOM/2-BATH

1/4"=1'-0" 1,083 sf


PREVIOUS REVISIONS:
A2.5 6-2-2025
A2.5 10-30-2025




REVISION:	
A2.5	12-5-2025
A2.5	1-20-2026
DATE:	5-9-2025
JOB:	24-3446
SHEET NO.:	

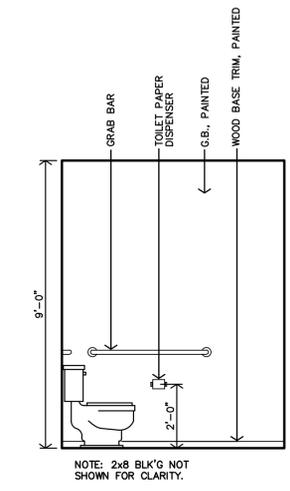


M
UNIT 3A
BATH #117
INTERIOR ELEVATION
3/8"=1'-0"

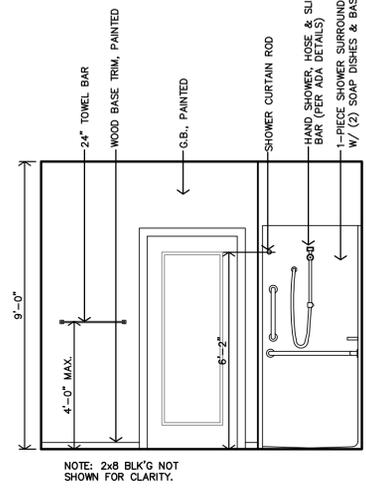


L
UNIT 3A
BATH #117
INTERIOR ELEVATION
3/8"=1'-0"

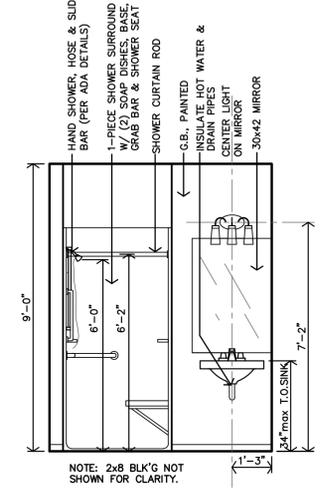


K
UNIT 3A
BATH #117
INTERIOR ELEVATION
3/8"=1'-0"

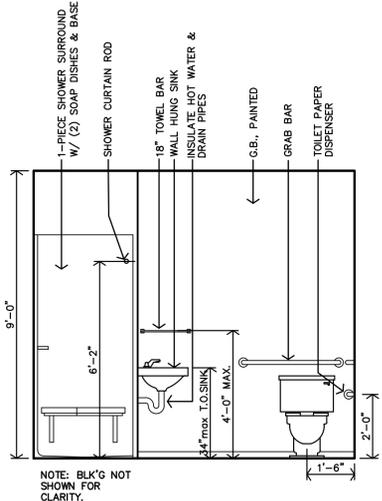


J
UNIT 3A
BATH #117
INTERIOR ELEVATION
3/8"=1'-0"

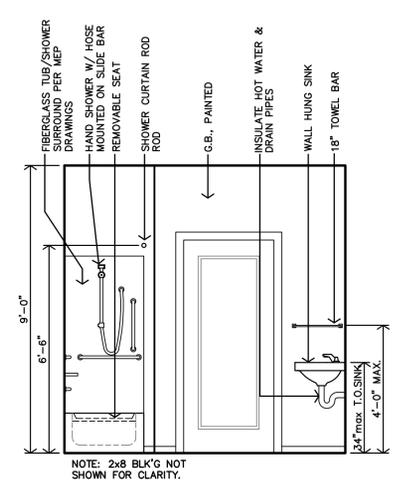


H
UNIT 2A & 3A
BATH #106
INTERIOR ELEVATION
3/8"=1'-0"

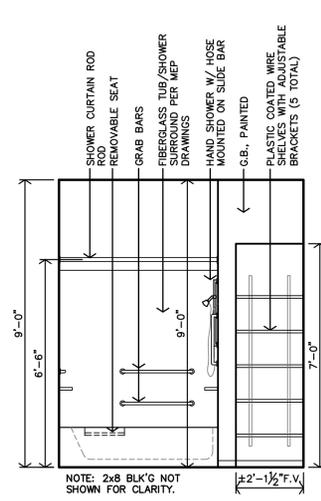


G
UNIT 2A & 3A
BATH #106
INTERIOR ELEVATION
3/8"=1'-0"

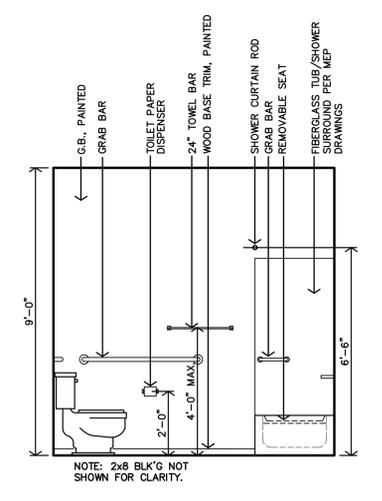


F
UNIT 2A & 3A
BATH #106
INTERIOR ELEVATION
3/8"=1'-0"

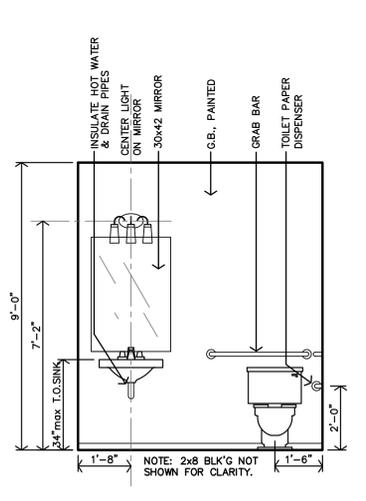


E
UNIT 2A & 3A
BATH #106
INTERIOR ELEVATION
3/8"=1'-0"

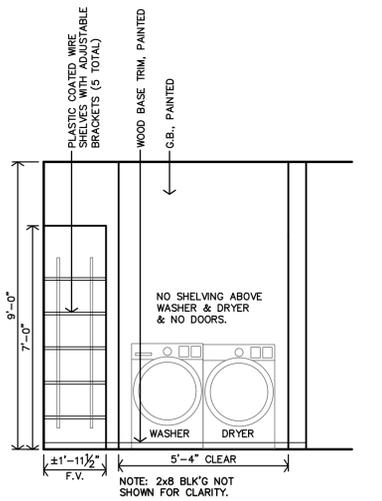

D
UNIT 2A & 3A
LAUNDRY #106
INTERIOR ELEVATION
3/8"=1'-0"

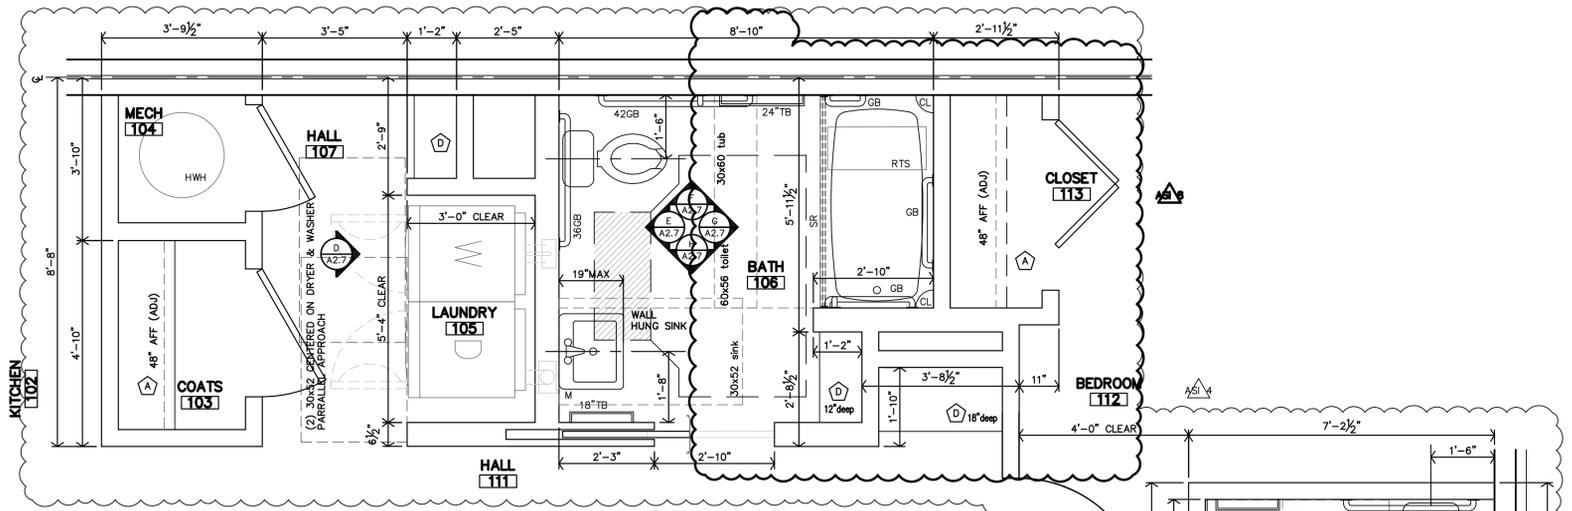


C
UNIT 3A (ACCESSIBLE)
BATH #106 & LAUNDRY #105
ENLARGED PLAN
1/2"=1'-0"

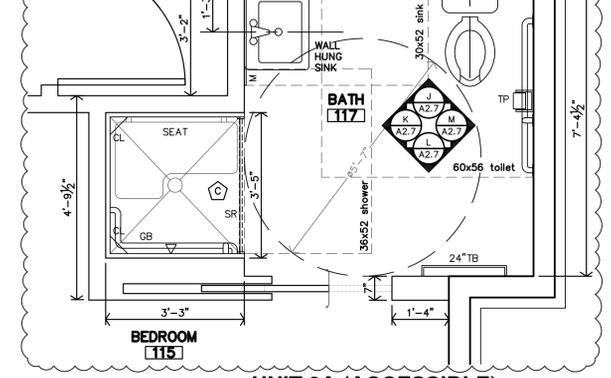

B
UNIT 3A (ACCESSIBLE)
BATH #117
ENLARGED PLAN
1/2"=1'-0"


ACCESSIBLE UNIT BATH NOTES	
1. REF UNIT NOTES ON SHEET A2.3 FOR ADDITIONAL DIRECTION.	
2. ALL DIMENSIONS ARE TO FACE OF C/P, BB, UNLESS NOTED OTHERWISE	
3. CONTRACTOR TO INSTALL 2x8 BLOCKING IN WALLS FOR ALL WALL MOUNTED/SUPPORTED COUNTERTOPS & BRACES, SHOWER UNIT, SLIDE BAR, TOWEL BARS, FUTURE GRAB BARS & FUTURE SHOWER SEAT, ETC. AS REQ'D. (REF SHEET A2.10)	
4. LOCATION OF WASHER & DRYER IS CRITICAL. WASHER IS TO BE LEFT OF DRYER, ALWAYS. THIS NEEDS TO BE COORDINATED ON SITE. UNITS DESIGNED AROUND 27"x33.5" FRONT LOADING ACCESSIBLE WASHER & DRYER.	
5. REF. SHEET A2.10 FOR APARTMENT BATH ACCESSIBLE DETAILS.	
6. REF. SHEET A2.8 FOR APARTMENT CASEWORK SECTIONS.	
LEGEND	KEYNOTES:
M MIRROR	A PLASTIC COATED WIRE CLOTHES SHELF & ROD (HEIGHT AS CALLED OUT ON PLAN)
TP TOILET PAPER DISP.	B NOT USED
TB TOWEL BAR	C VERIFY SIZE W/ FIBERGLASS SHOWER UNIT
CL CORNER LEDGE	D 12" or 18" DEEP PLASTIC COATED WIRE SHELVES (5 TOTAL) WITH ADJUSTABLE BRACKETS
SR SHOWER ROD	
GB GRAB BAR	
HWH HOT WATER HEATER	
RTS REMOVABLE TUB SEAT	

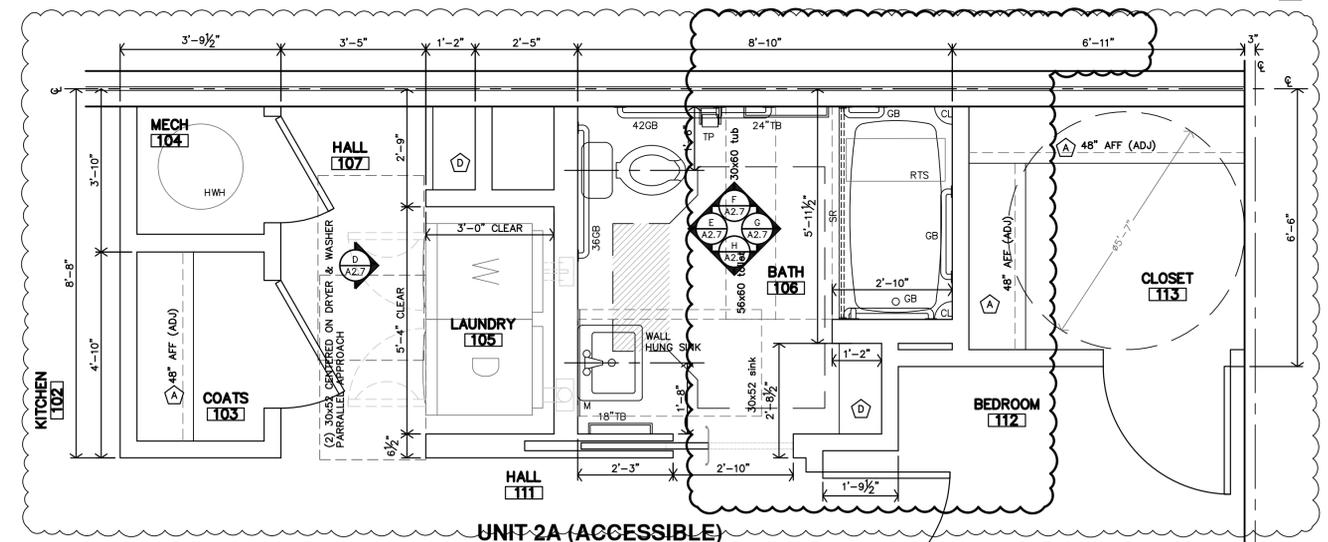


A
UNIT 2A (ACCESSIBLE)
BATH #106 & LAUNDRY #105
ENLARGED PLAN
1/2"=1'-0"



REVISION:	
A6	10-30-2025
A7	1-20-2026
DATE:	5-9-2025
JOB:	24-3446
SHEET NO.:	






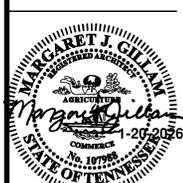


REVISION:
 1-20-2026
 DATE: 5-9-2025
 JOB: 24-3446
 SHEET NO. 1

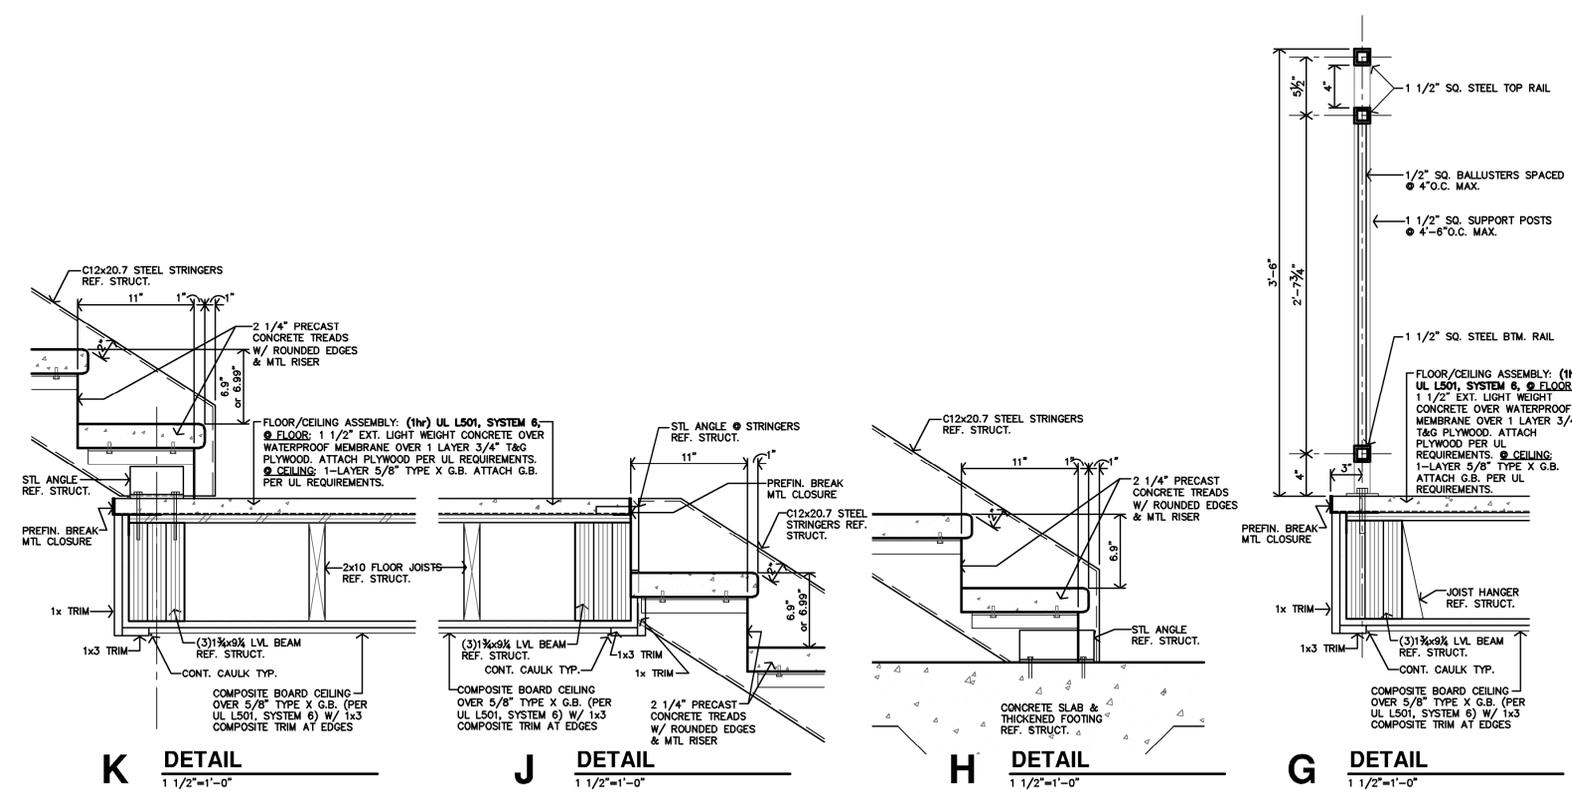

ROOFING DETAIL NOTES
 1. TYPICAL MANUFACTURER'S DETAILS ACTUAL CONDITIONS MAY VARY, REFER AND COORDINATE W/ BUILDING DETAILS PROVIDING THE MANUFACTURER'S MOST STRINGENT REQUIREMENTS, RECOMMENDATIONS, NECESSARY TO ACHIEVE COMPLETE WATERTIGHT WARRANTY.
 2. A WOOD NAILER IS REQUIRED WHEN INSULATION IS GREATER THAN 1" COORDINATE WITH MANUFACTURER'S REQUIREMENTS TOP OF WOOD ATTACH WOOD NAILERS SHALL BE SPACED NO GREATER THAN 18" O.C.

MANUFACTURER'S-ROOFING DETAILS, CONDITIONS VARY

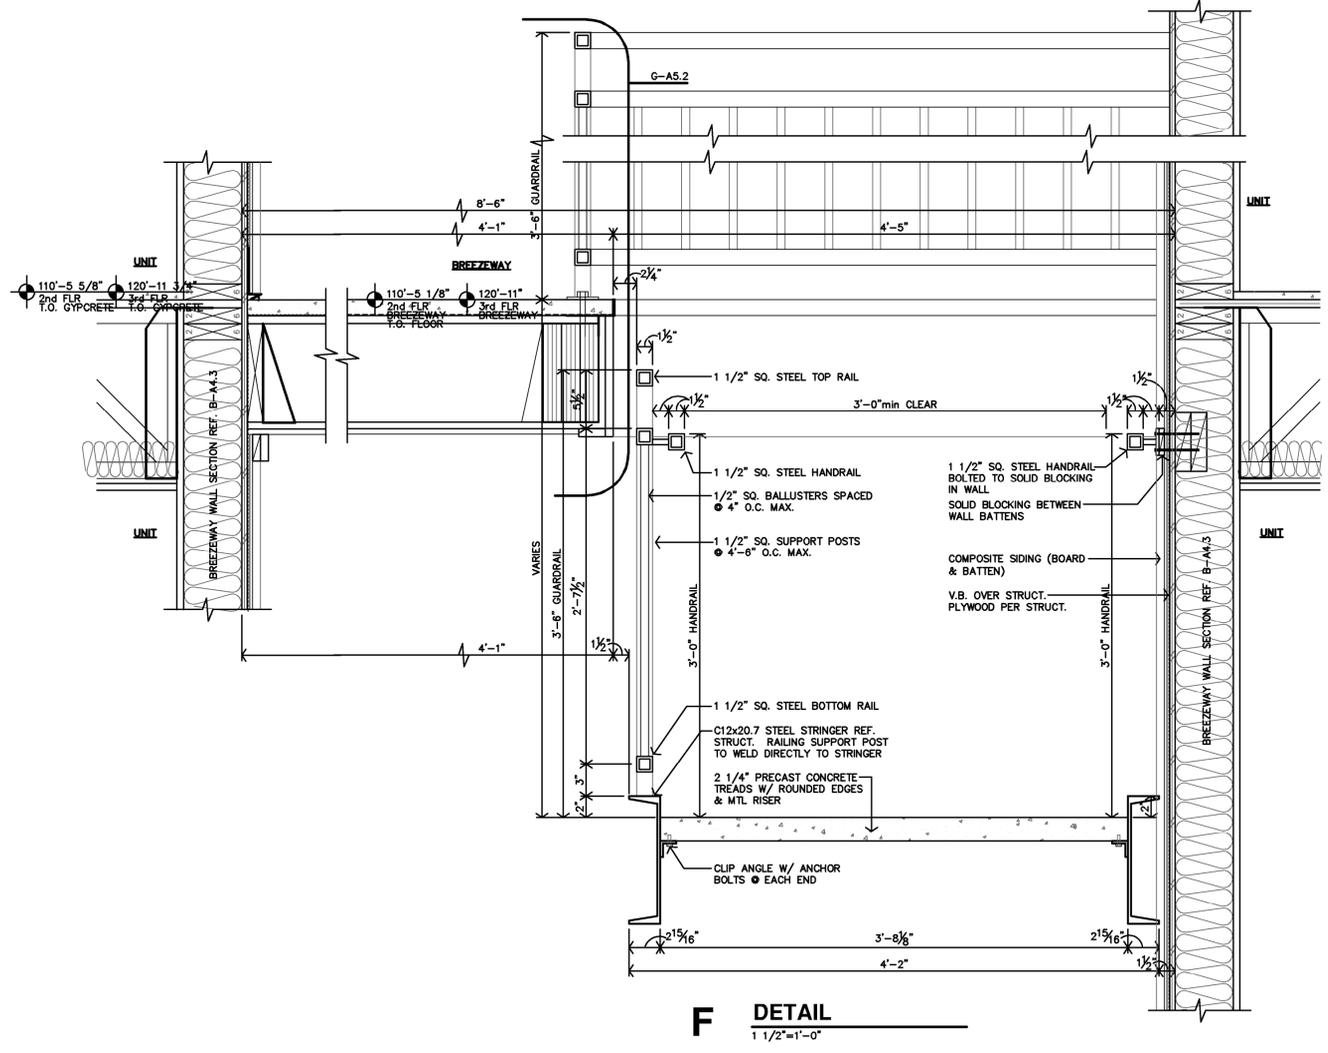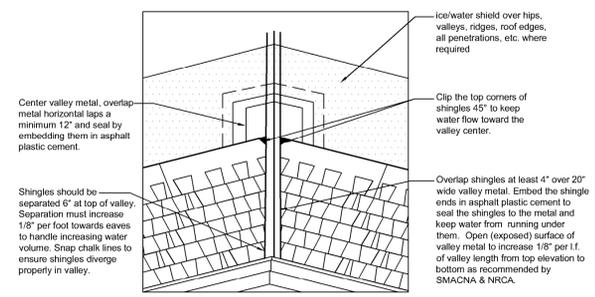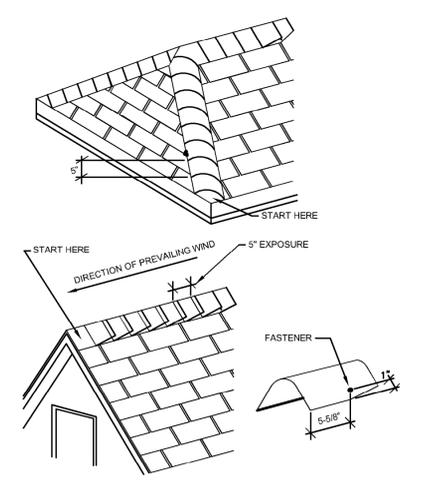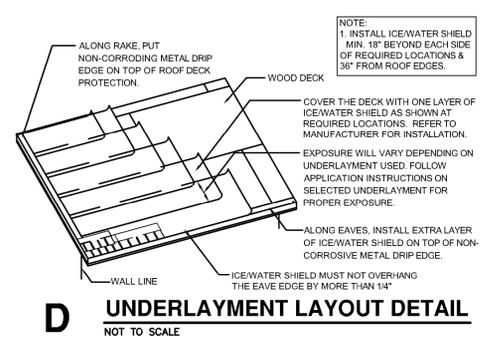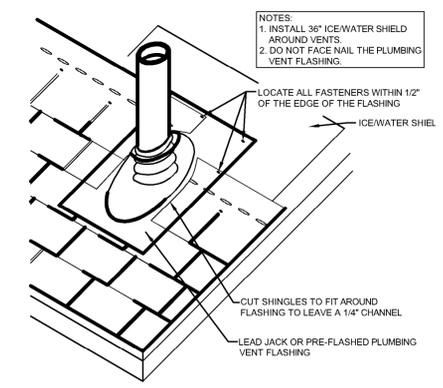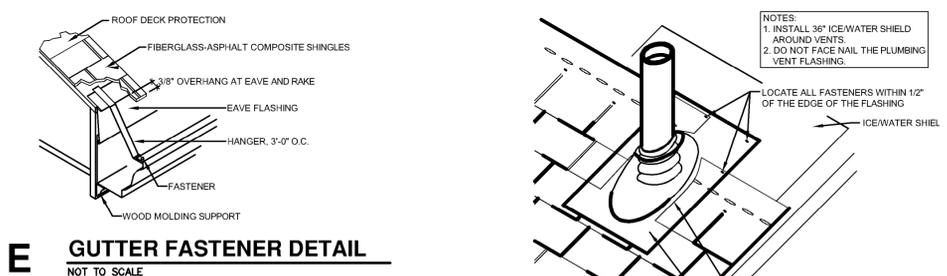

GENERAL FIRE ALARM NOTES

1 DB RATING FOR ALL FIRE ALARM HORNS SHALL BE SET 15 DB ABOVE AMBIENT PER CODE REQUIREMENTS.

LST Consulting Engineers, PA
 MANHATTAN 4809 Vue Du Lac Place, Suite 201 65003
 WICHITA 125 S. Washington, Suite 150 67202
 785.587.8042 316.285.0696
 www.LSTengineers.com mail@LSTengineers.com
 Project 24072 05/09/2025

JonesGillamRenz
 1881 Main Street, Suite 301
 Salina, KS 67401
 785.827.0386
 jgr@jgarchitects.com

JGR

THE RESERVES AT COBALT CIRCLE
 NEW APARTMENT COMPLEX

BROWNSVILLE



REVISIONS:


1	12-3-2025	ASI #5
2	01-20-2026	ASI #8

DATE: 05/09/2025
 JOB: 24-3446
 SHEET NO.:


E1.1

NOTES BY SYMBOL

- CEILING MOUNTED SMOKE ALARM IN APARTMENTS TO BE 120VAC WITH 9V BATTERY BACKUP, INTERCONNECTED TO OTHERS IN SAME APARTMENT. DEVICE SHALL HAVE PHOTOELECTRIC TYPE SMOKE DETECTOR WITH SOUNDER HORN HAVING AN 85 db OUTPUT AT 10'. SHALL HAVE A SINGLE BUTTON FOR TEST/SILENCE AND LED INDICATOR LIGHTS, AND SHALL BE UL 217 LISTED, BRK #SC701L.BL OR EQUAL.
- FIRE ALARM SMOKE DETECTOR.
- FIRE ALARM ADDRESSABLE CONTROL MODULE FOR CONTROL OF APARTMENT UNITS NOTIFICATION APPLIANCE CIRCUIT. MODULE SHALL BE PROGRAMMED TO ACTIVATE APARTMENT UNITS NOTIFICATION APPLIANCES UPON GENERAL BUILDING FIRE ALARM AND UPON ACTIVATION OF ANY SMOKE DETECTOR OR CO DETECTOR WITHIN APARTMENT UNIT. MOUNT FLUSH IN WALL AT 8'-0" AFF.
- PROVIDE DOOR ANNUNCIATOR SYSTEM AV HORN/STROBE DEVICE AND LOW VOLTAGE TRANSFORMER AT ALL ACCESSIBLE APARTMENTS AND ALSO AT APARTMENTS DESIGNATED HEARING-IMPAIRED. INSTALL HORN/STROBE APPLIANCE AT 8' AFF. INSTALL TRANSFORMER IN DOUBLE GANG JUNCTION BOX ABOVE HORN/STROBE WITH BLANK COVER PLATE AND PROVIDE LOW VOLTAGE CONTROL WIRING. SEE DETAIL #, SHEET E.#. PROVIDE ENGRAVED SIGN AT THE HORN/STROBE DEVICE TO READ "DOOR"
- PROVIDE PUSH BUTTON AT 48" AFF FOR ANNUNCIATOR SYSTEM AT ALL ACCESSIBLE APARTMENTS AND ALSO AT APARTMENTS DESIGNATED FOR HEARING-IMPAIRED. REFER TO ARCH DRAWINGS FOR APPLICABLE ROOMS. SEE DETAIL #, SHEET E.#.
- PROVIDE SMOKE DETECTOR ABOVE FACP AND CONNECT TO FIRE ALARM SYSTEM.
- PROVIDE ADDRESSABLE FIRE ALARM RELAYS AND MONITORING MODULES FOR ALL FIRE SPRINKLER FLOW SWITCHES, TAMPER SWITCHES AND BELL/CHONG. COORDINATE QUANTITIES AND LOCATIONS WITH FIRE SPRINKLER CONTRACTOR.
- COVER WALL WITH 4"x8"x3/4" ACX FIRE RETARDANT PLYWOOD SHEETS INSTALLED VERTICALLY WITH BOTTOM AT 5" AFF. PLYWOOD SHALL BE PERMANENTLY FASTENED TO THE WALL BY MEANS OF WALL ANCHORS UTILIZING GALVANIZED, ZINC PLATED, OR STAINLESS STEEL HARDWARE WITH A FLAT HEAD. FINISHED INSTALLATION SHALL HAVE FLUSH APPEARANCE WITH COUNTERSUNK SCREW HEADS TO PREVENT SPLITTING OF THE PLYWOOD. DRYWALL SCREWS ARE NOT ACCEPTABLE. PAINT WITH TWO COATS OF LIGHT GRAY FIRE RETARDANT SEALER PRIOR TO INSTALLATION OF ANY EQUIPMENT.
- TELECOMMUNICATIONS GROUND BAR SHALL BE 13-1/4"W x 2-1/4" x 1/4" THICK ELECTRO-TIN PLATED COPPER BUS BAR, COMPLETE WITH INSULATED STAND-OFFS AND STAINLESS STEEL BRACKETS. ERICO #TGBA14L06PT OR EQUAL MOUNT AT 18" AFF. ALL CONNECTIONS TO GROUND BAR SHALL BE MADE USING COMPRESSION TYPE LUGS.
- 120V POWER FOR FIRE SPRINKLER SYSTEM FLOW SWITCH(ES) AND BELL. PROVIDE #8 CU BONDING JUMPER FROM CIRCUIT EQUIPMENT GROUNDING CONDUCTOR TO METAL SPRINKLER SYSTEM PIPING AT AN ACCESSIBLE LOCATION PER NEC 250.104(B). COORDINATE WORK WITH FIRE SPRINKLER SYSTEM INSTALLER.
- CIRCUIT BREEZEWAY LIGHTS FOR CONTINUOUS OPERATION. SEE FLOORS ABOVE FOR CONTINUATION OF BREEZEWAY LIGHTING CIRCUIT.
- PROVIDE MANUAL PULL STATION AT FACP CLOSET AND CONNECT TO FIRE ALARM SYSTEM.
- WHERE FIRE PROTECTION PIPING MUST CROSS HALLWAY, ROUTE IN SOFFIT. PROVIDE HEAT TRACE AND INSULATE PIPING IN SOFFIT PER HEAT TRACE MANUFACTURER'S INSTRUCTIONS. PROVIDE ALL REQUIRED HEAT TRACE COMPONENTS AND CONTROLS FOR FREEZE PROTECTION OF PIPING. SEE WATER RISER CLOSET FOR MORE INFORMATION.
- PROVIDE HEAT TRACE CONTROLLER EQUAL TO CHROMALOX INTELLITRACE ITC-FS DIGITAL HEAT TRACE CONTROLLER WITH (2) CIRCUITS. PROVIDE (2) 20 AMP CIRCUITS. (1) FOR EACH BREEZEWAY. ROUTE CIRCUITS FROM PANEL HA TO HEAT TRACE CONTROLLER. EXTEND LINE VOLTAGE AND LOW VOLTAGE MONITORING CABLES FROM HEAT TRACE CONTROLLER TO EACH FIRE SUPPRESSION BREEZEWAY CROSSING.
- (2) 2" CONDUITS FOR COMMUNICATIONS SERVICES. SEE SITE PLAN FOR CONTINUATION.
- PROVIDE (2) CAT 5e UTP, NEC TYPE 'CMP' CABLES (SUPERIOR ESSEX #51-241-48 OR EQUAL) IN 3/4" CONDUIT FROM FACP TO MAIN TELECOM TERMINAL BOARD FOR CONNECTION TO FA SYSTEM DUCT FOR REMOTE MONITORING.
- PROVIDE PHOTOCELL ON NORTH SIDE OF BUILDING FOR OPERATION OF PARKING LOT LIGHTS AND BUILDING MOUNTED LIGHTS. SEE DETAIL 1E6.1 & 2E6.1 FOR MORE INFORMATION.
- PROVIDE ALTERNATE BID TO CONNECT DOMESTIC WATER BOOSTER PUMP.
- ALL REQUIRED DOCUMENTATION REGARDING THE DESIGN OF FIRE DETECTION, ALARM AND COMMUNICATIONS SYSTEMS AND THE PROCEDURES FOR MAINTENANCE, INSPECTION, AND TESTING OF FIRE DETECTION, ALARM AND COMMUNICATIONS SYSTEMS SHALL BE MAINTAINED AT AN APPROVED, SECURED LOCATION FOR THE LIFE OF THE SYSTEM. PER IFC 901.6.3.1.

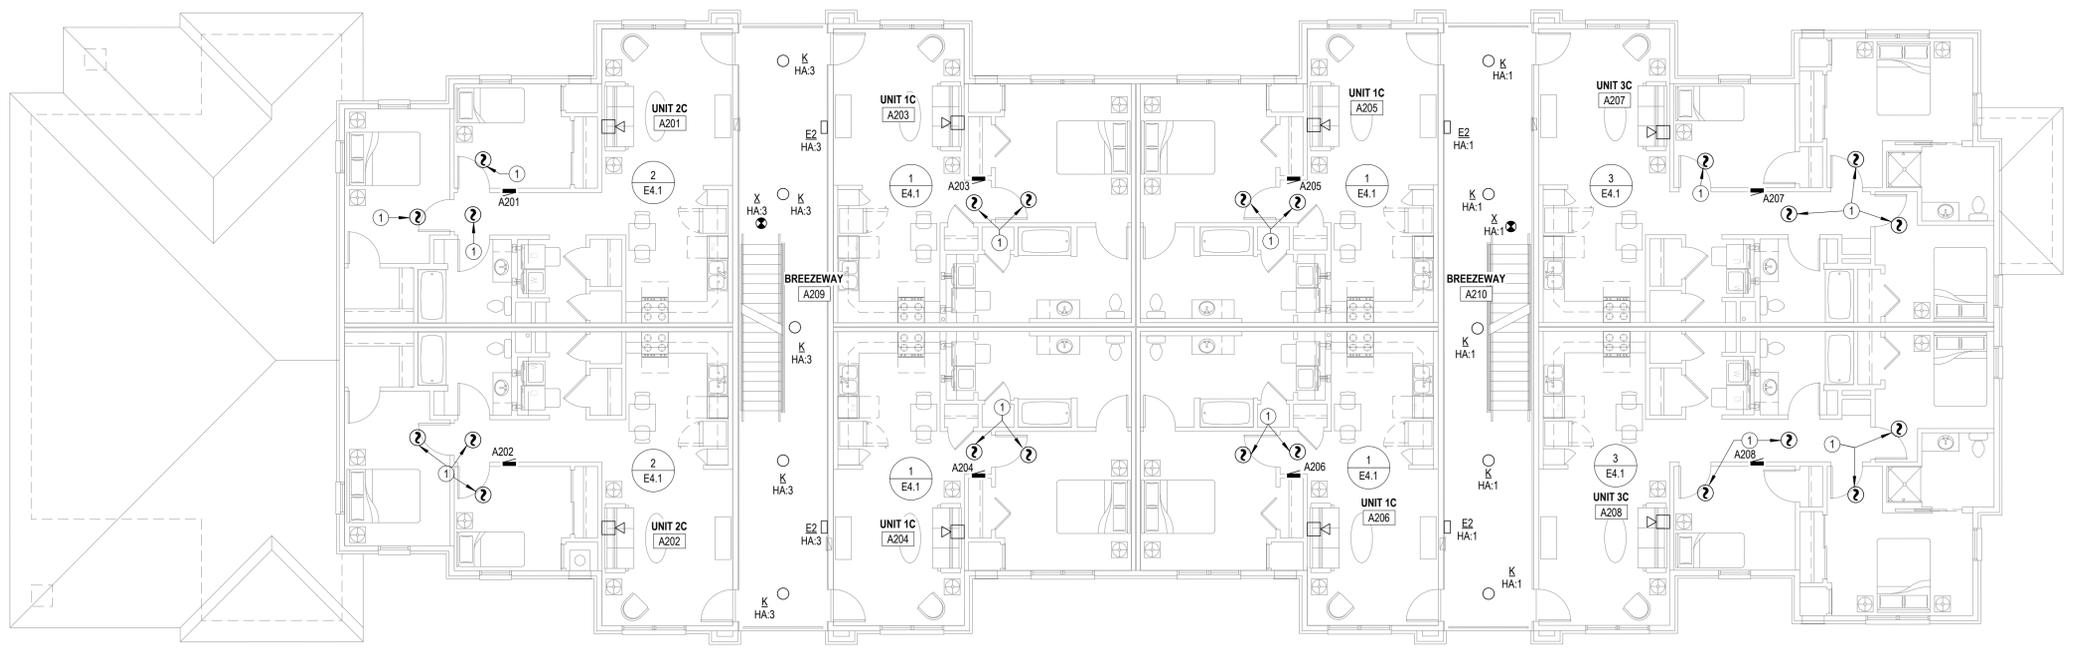


2 BUILDING A-SECOND FLOOR-POWER PLAN
 1/8" = 1'-0"

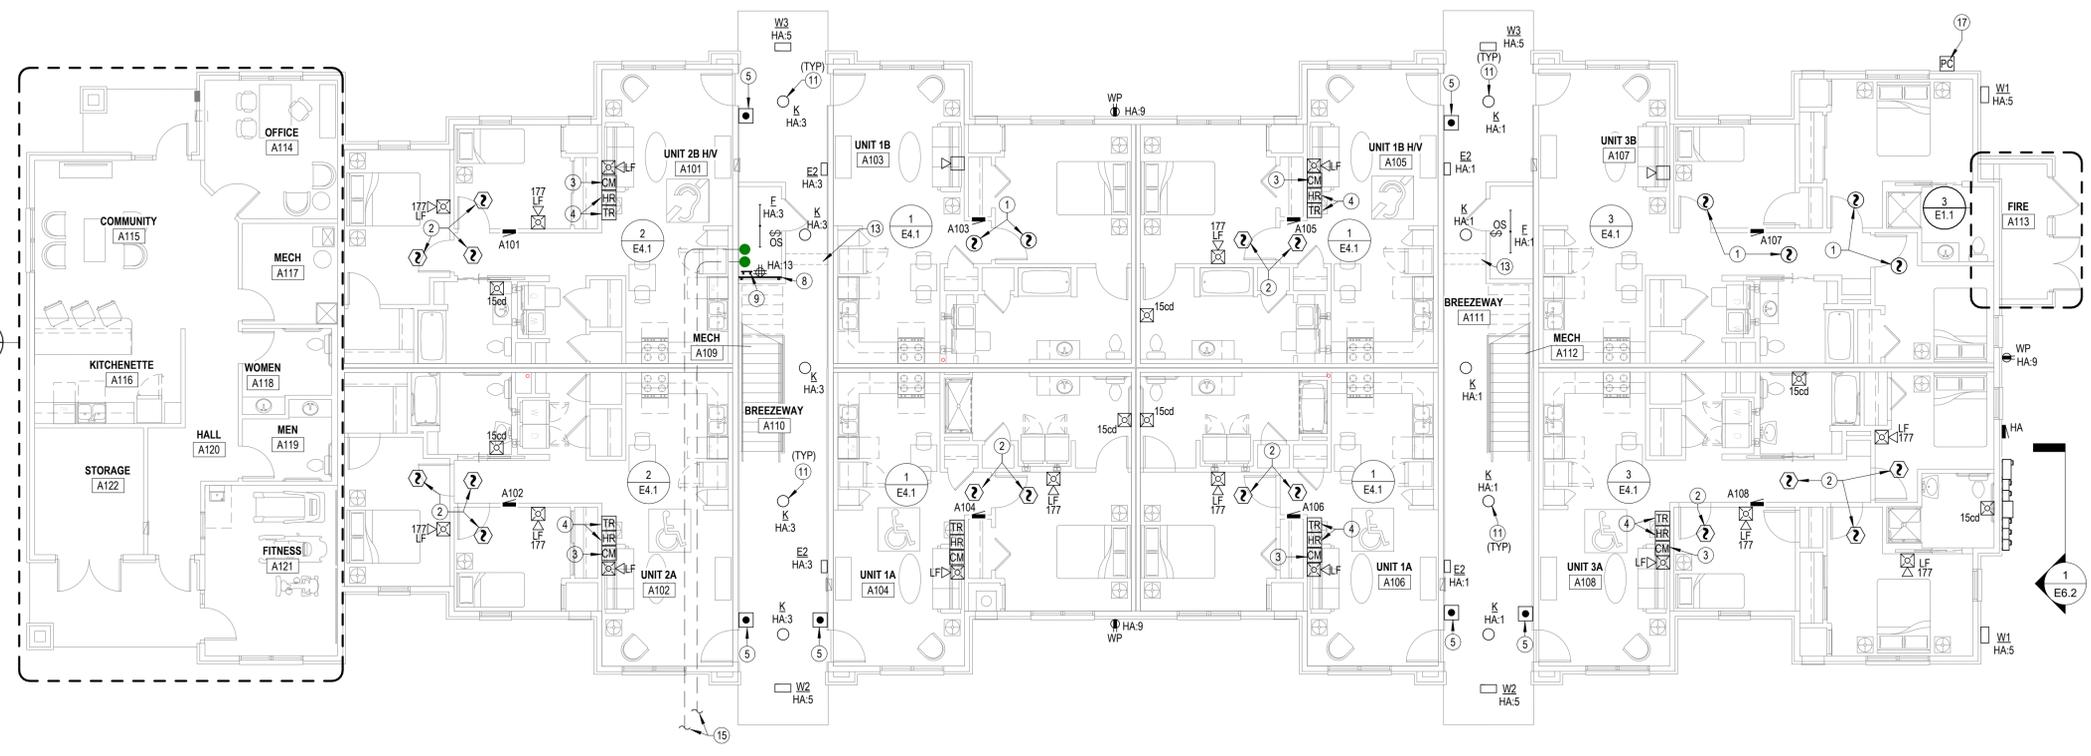

1 BUILDING A-FIRST FLOOR-POWER PLAN
 1/8" = 1'-0"

3 BUILDING A-WATER RISER CLOSET
 3/8" = 1'-0"

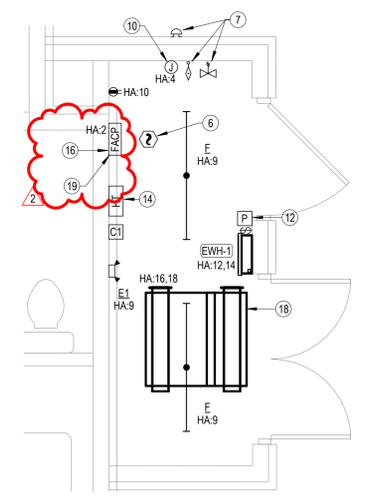

COPYRIGHTED

GENERAL FIRE ALARM NOTES

1 DB RATING FOR ALL FIRE ALARM HORNS SHALL BE SET 15 DB ABOVE AMBIENT PER CODE REQUIREMENTS.

LST Consulting Engineers, PA
 MANHATTAN 4809 Vue Du Lac Place, Suite 201, Manhattan, KS 66503
 WICHITA 125 S. Washington, Suite 150, Wichita, KS 67202
 Project 24072 05/09/2025
 www.LSTengineers.com
 mail@LSTengineers.com

JonesGillamRenz
 1881 Main Street, Suite 301
 Salina, KS 67401
 785.827.0386
 jgr@jgarchitects.com

JGR

TENNESSEE

THE RESERVES AT COBALT CIRCLE

NEW APARTMENT COMPLEX


BROWNSVILLE



REVISIONS:


1	12-3-2025	ASI #5
2	01-20-2026	ASI #8

DATE: 05/09/2025
 JOB: 24-3446
 SHEET NO.:

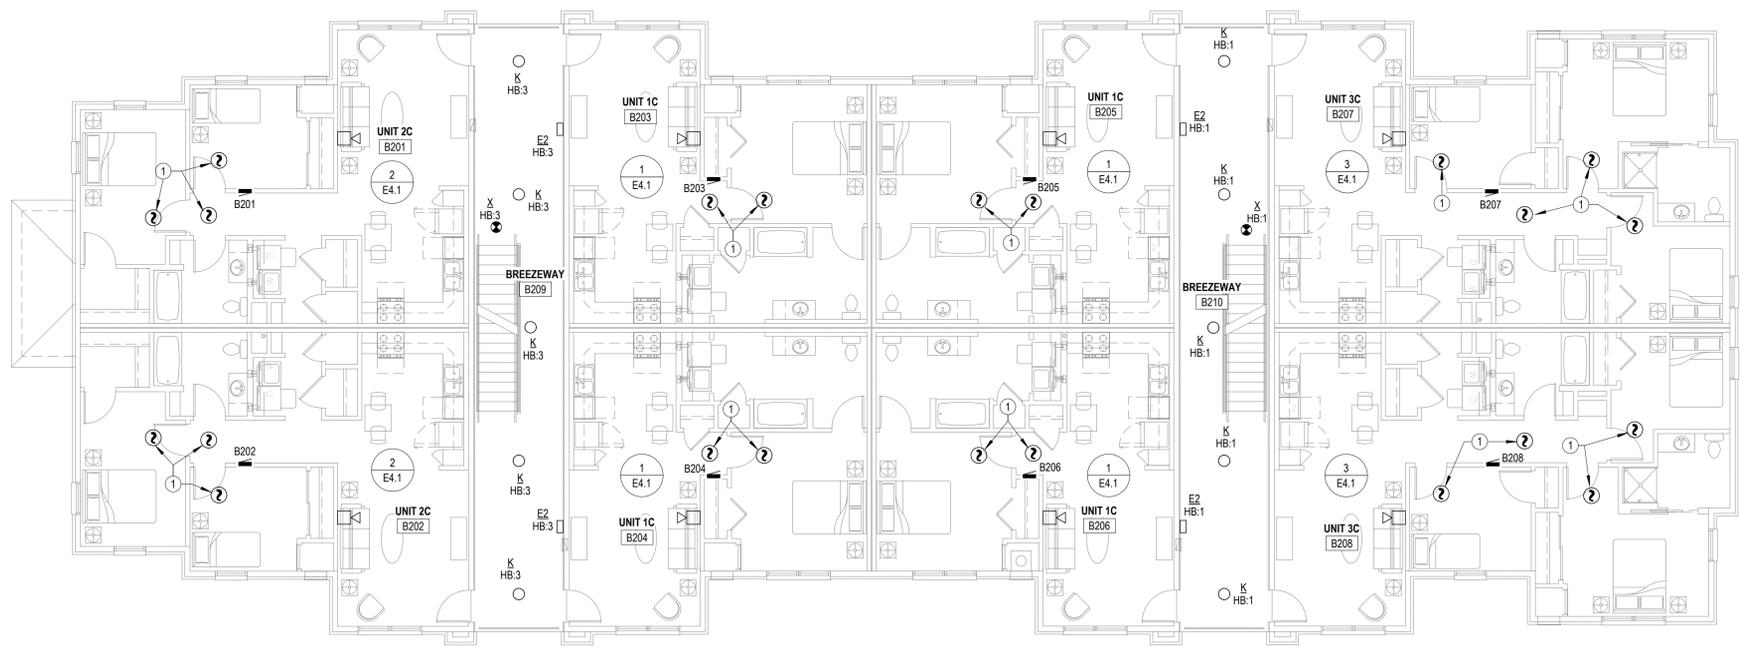


- NOTES BY SYMBOL**
- CEILING MOUNTED SMOKE ALARM IN APARTMENTS TO BE 120VAC WITH 9V BATTERY BACKUP, INTERCONNECTED TO OTHERS IN SAME APARTMENT. DEVICE SHALL HAVE PHOTOELECTRIC TYPE SMOKE DETECTOR WITH SOUNDER HORN HAVING AN 85 db OUTPUT AT 10'. SHALL HAVE A SINGLE BUTTON FOR TEST/SILENCE AND LED INDICATOR LIGHTS, AND SHALL BE UL 217 LISTED, BRK #SC701BL OR EQUAL.
 - PROVIDE SMOKE DETECTOR ABOVE FACP AND CONNECT TO FIRE ALARM SYSTEM.
 - PROVIDE ADDRESSABLE FIRE ALARM RELAYS AND MONITORING MODULES FOR ALL FIRE SPRINKLER FLOW SWITCHES, TAMPER SWITCHES AND BELLRING. COORDINATE QUANTITIES AND LOCATIONS WITH FIRE SPRINKLER CONTRACTOR.
 - COVER WALL WITH 4x8x3/4" ACX FIRE RETARDANT PLYWOOD SHEETS INSTALLED VERTICALLY WITH BOTTOM AT 6" AFF. PLYWOOD SHALL BE PERMANENTLY FASTENED TO THE WALL BY MEANS OF WALL ANCHORS UTILIZING GALVANIZED, ZINC PLATED, OR STAINLESS STEEL HARDWARE WITH A FLAT HEAD. FINISHED INSTALLATION SHALL HAVE FLUSH APPEARANCE WITH COUNTERSUNK SCREW HEADS TO PREVENT SPLITTING OF THE PLYWOOD. DRYWALL SCREWS ARE NOT ACCEPTABLE. PAINT WITH TWO COATS OF LIGHT GRAY FIRE RETARDANT SEALER PRIOR TO INSTALLATION OF ANY EQUIPMENT.
 - TELECOMMUNICATIONS GROUND BAR SHALL BE 13-1/4"W x 2"H x 1/4" THICK ELECTRO-TIN PLATED COPPER BUS BAR, COMPLETE WITH INSULATED STAND-OFFS AND STAINLESS STEEL BRACKETS, ERICO #TGBA140PT OR EQUAL. MOUNT AT 18" AFF. ALL CONNECTIONS TO GROUND BAR SHALL BE MADE USING COMPRESSION TYPE LUGS.
 - 120V POWER FOR FIRE SPRINKLER SYSTEM FLOW SWITCH(ES) AND BELL PROVIDING #8 CU BONDING JUMPER FROM CIRCUIT EQUIPMENT GROUNDING CONDUCTOR TO METAL SPRINKLER SYSTEM PIPING AT AN ACCESSIBLE LOCATION PER NEC 250.104(B). COORDINATE WORK WITH FIRE SPRINKLER SYSTEM INSTALLER.
 - CIRCUIT BREEZEWAY LIGHTS FOR CONTINUOUS OPERATION. SEE FLOORS ABOVE FOR CONTINUATION OF BREEZEWAY LIGHTING CIRCUIT.
 - PROVIDE MANUAL PULL STATION AT FACP CLOSET AND CONNECT TO FIRE ALARM SYSTEM.
 - WHERE FIRE PROTECTION PIPING MUST CROSS HALLWAY, ROUTE IN SOFFIT. PROVIDE HEAT TRACE AND INSULATE PIPING IN SOFFIT PER HEAT TRACE MANUFACTURER'S INSTRUCTIONS. PROVIDE ALL REQUIRED HEAT TRACE COMPONENTS AND CONTROLS FOR FREEZE PROTECTION OF PIPING. SEE WATER RISER CLOSET FOR MORE INFORMATION.
 - PROVIDE HEAT TRACE CONTROLLER EQUAL TO CHROMALOX INTELLITRACE ITC-FS DIGITAL HEAT TRACE CONTROLLER WITH (2) CIRCUITS. PROVIDE (2) 20 AMP CIRCUITS, (1) FOR EACH BREEZEWAY. ROUTE CIRCUITS FROM PANEL 'HA' TO HEAT TRACE CONTROLLER. EXTEND LINE VOLTAGE AND LOW VOLTAGE MONITORING CABLING FROM HEAT TRACE CONTROLLER TO EACH FIRE SUPPRESSION BREEZEWAY CROSSING.
 - (2) 2" CONDUITS FOR COMMUNICATIONS SERVICES. SEE SITE PLAN FOR CONTINUATION.
 - PROVIDE (2) CAT 5e UTP, NEC TYPE 'CMP' CABLES (SUPERIOR ESSEX #51-241-48 OR EQUAL) IN 3/4" CONDUIT FROM FACP TO MAIN TELECOM TERMINAL BOARD FOR CONNECTION TO FA SYSTEM DUCT FOR REMOTE MONITORING.
 - PROVIDE PHOTOCELL ON NORTH SIDE OF BUILDING FOR OPERATION OF PARKING LOT LIGHTS AND BUILDING MOUNTED LIGHTS. SEE DETAIL 1-E6.1 & 2-E6.1 FOR MORE INFORMATION.
 - PROVIDE ALL REQUIRED DOCUMENTATION REGARDING THE DESIGN OF FIRE DETECTION, ALARM AND COMMUNICATIONS SYSTEMS AND THE PROCEDURES FOR MAINTENANCE, INSPECTION, AND TESTING OF FIRE DETECTION, ALARM AND COMMUNICATIONS SYSTEMS SHALL BE MAINTAINED AT AN APPROVED, SECURED LOCATION FOR THE LIFE OF THE SYSTEM. PER IFC 901.6.3.1.

2 BUILDING B-SECOND FLOOR-POWER PLAN
 1/8" = 1'-0"

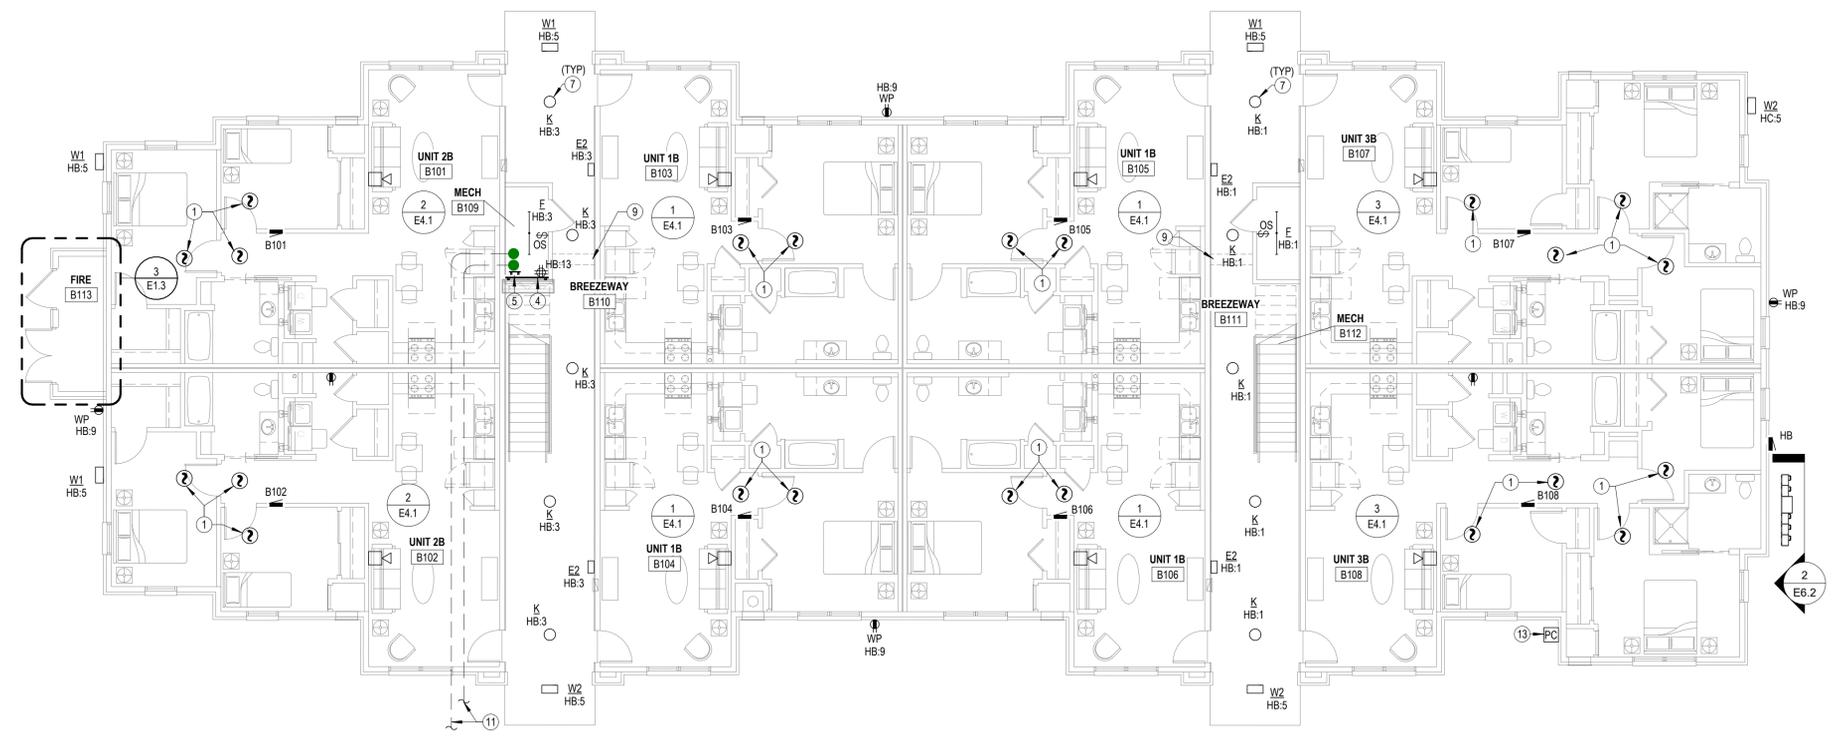

1 BUILDING B-FIRST FLOOR-POWER PLAN
 1/8" = 1'-0"

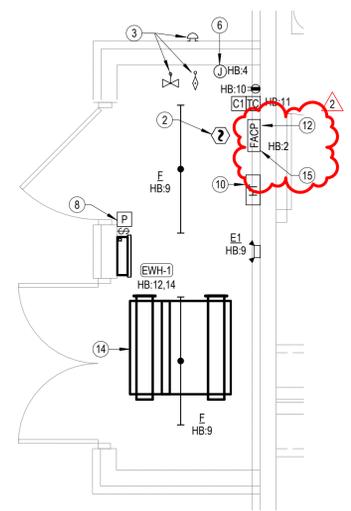

3 BUILDING B-WATER RISER CLOSET
 3/8" = 1'-0"
 BUILDING 'C' SIMILAR

E1.3

COPYRIGHTED

GENERAL FIRE ALARM NOTES

1 DB RATING FOR ALL FIRE ALARM HORNS SHALL BE SET 15 DB ABOVE AMBIENT PER CODE REQUIREMENTS.

LST Consulting Engineers, PA

MANHATTAN 4809 Vue Du Lac Place, Suite 201
 Manhattan, KS 66503
 785.587.8042
 www.LSTengineers.com
 mail@LSTengineers.com

WICHITA 125 S. Washington, Suite 150
 Wichita, KS 67202
 316.285.0696

Project 24072 05/09/2025

NOTES BY SYMBOL

1 CEILING MOUNTED SMOKE ALARM IN APARTMENTS TO BE 120VAC WITH 9V BATTERY BACKUP, INTERCONNECTED TO OTHERS IN SAME APARTMENT. DEVICE SHALL HAVE PHOTOELECTRIC TYPE SMOKE DETECTOR WITH SOUNDER HORN HAVING AN 85 db OUTPUT AT 10', SHALL HAVE A SINGLE BUTTON FOR TEST/SILENCE AND LED INDICATOR LIGHTS, AND SHALL BE UL 217 LISTED, BRK #SC701BL OR EQUAL.

2 PROVIDE RECEPTACLE IN ATTIC NEAR RADON PIPE FOR FUTURE RADON FAN.

3 DOWNLIGHTS TO BE INSTALLED IN SOFFIT ABOVE THIRD FLOOR.

JGR JonesGillamRenz

1881 Main Street, Suite 301
 Salina, KS 67401
 785.827.0386
 jgr@jgarchitects.com



THE RESERVES AT COBALT CIRCLE
 NEW APARTMENT COMPLEX
 BROWNVILLE
 TENNESSEE




REVISIONS:

1	12-3-2025	ASI #5
2	01-20-2026	ASI #8

DATE: 05/09/2025
 JOB: 24-3446
 SHEET NO.:

E1.4

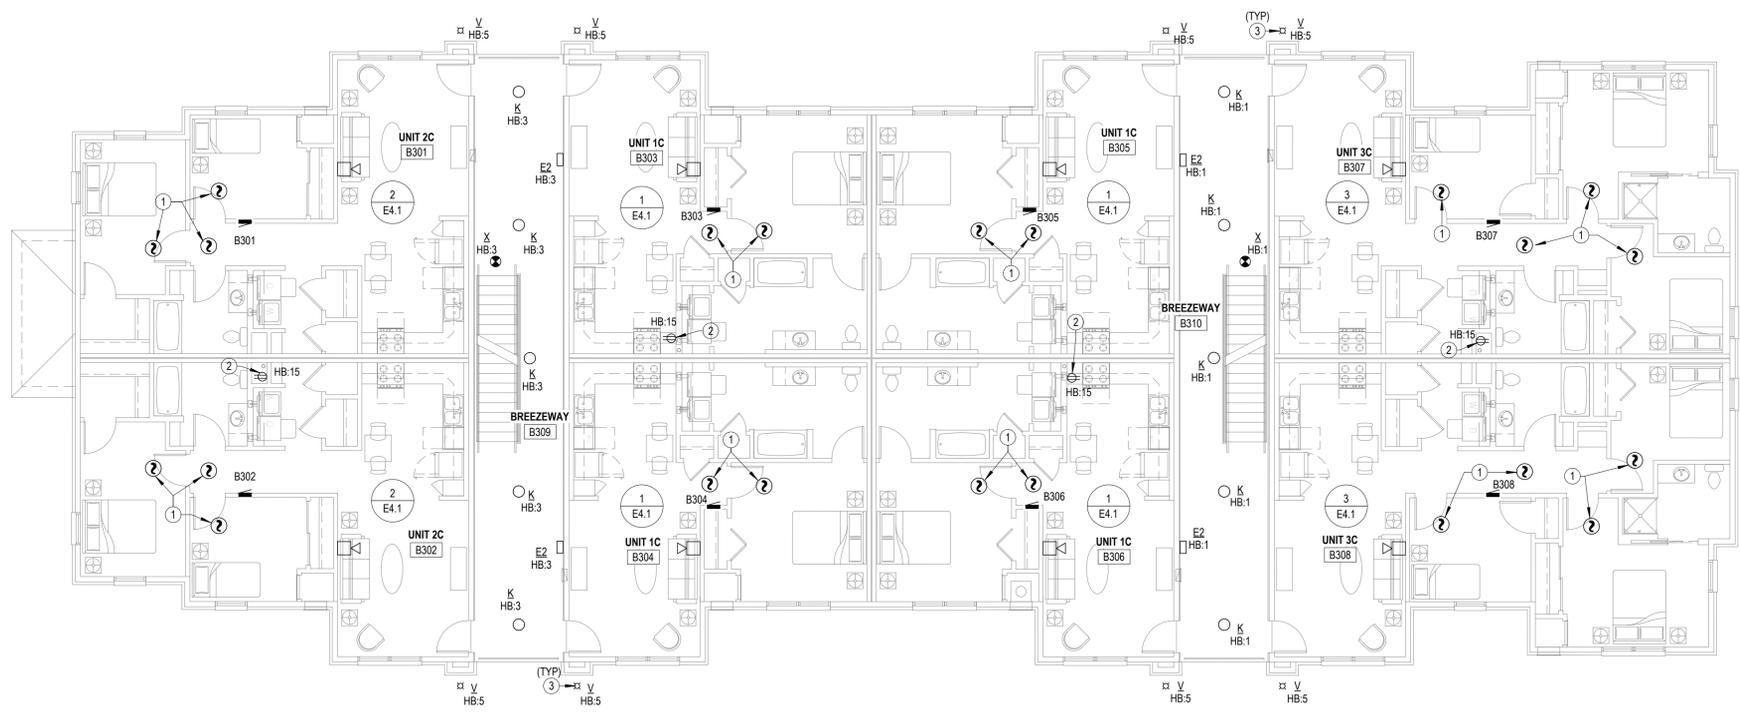

1 BUILDING B-THIRD FLOOR-POWER PLAN
 1/8" = 1'-0"

COPYRIGHTED ©

GENERAL FIRE ALARM NOTES

1 DB RATING FOR ALL FIRE ALARM HORNS SHALL BE SET 15 DB ABOVE AMBIENT PER CODE REQUIREMENTS.

LST Consulting Engineers, PA
 MANHATTAN 4809 Vue Du Lac Place, Suite 201
 WICHITA 125 S. Washington, Suite 150
 Manhattan, KS 66503 Wichita, KS 67202
 785.587.8042 316.285.0696
 www.LSTengineers.com mail@LSTengineers.com
Project 24072 05/09/2025

JonesGillamRenz
 1881 Main Street, Suite 301
 Salina, KS 67401
 785.827.0386
 jgr@jgarchitects.com

JGR

THE RESERVES AT COBALT CIRCLE
 NEW APARTMENT COMPLEX
 BROWNVILLE
 TENNESSEE




REVISIONS:

1	12-3-2025	ASI #5
2	01-20-2026	ASI #8


DATE: 05/09/2025
 JOB: 24-3446
 SHEET NO.:

E1.5

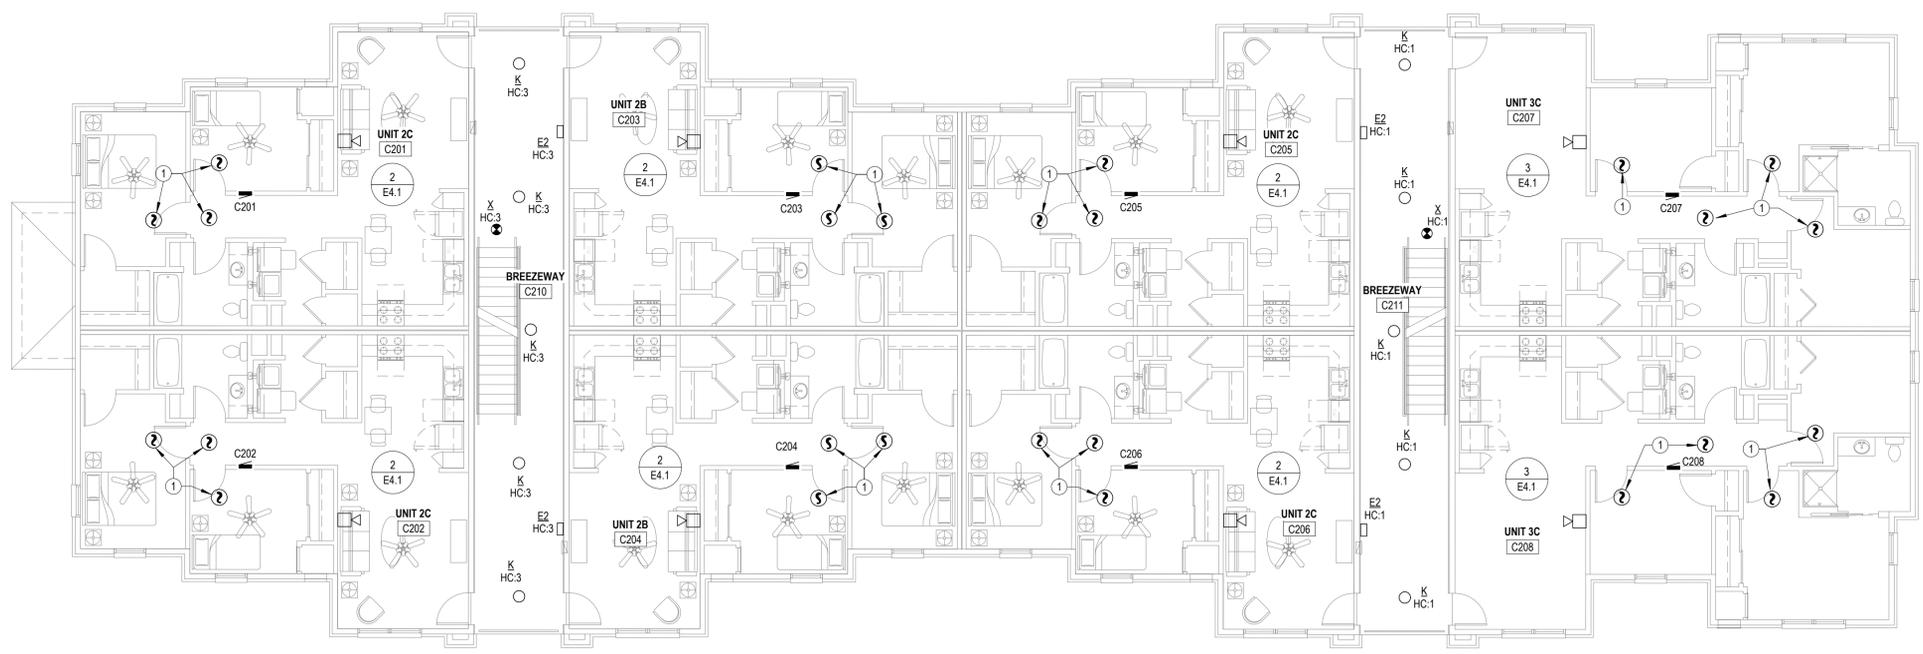

- NOTES BY SYMBOL**
- 1 CEILING MOUNTED SMOKE ALARM IN APARTMENTS TO BE 120VAC WITH 9V BATTERY BACKUP, INTERCONNECTED TO OTHERS IN SAME APARTMENT. DEVICE SHALL HAVE PHOTOELECTRIC TYPE SMOKE DETECTOR WITH SOUNDER HORN HAVING AN 85 db OUTPUT AT 10'. SHALL HAVE A SINGLE BUTTON FOR TEST/SILENCE AND LED INDICATOR LIGHTS, AND SHALL BE UL 217 LISTED, BRK #SC701LBL OR EQUAL.
 - 2 COVER WALL WITH 4x8x3/4" ACX FIRE RETARDANT PLYWOOD SHEETS INSTALLED VERTICALLY WITH BOTTOM AT 6" AFF. PLYWOOD SHALL BE PERMANENTLY FASTENED TO THE WALL BY MEANS OF WALL ANCHORS UTILIZING GALVANIZED, ZINC PLATED, OR STAINLESS STEEL HARDWARE WITH A FLAT HEAD. FINISHED INSTALLATION SHALL HAVE FLUSH APPEARANCE WITH COUNTERSUNK SCREW HEADS TO PREVENT SPLITTING OF THE PLYWOOD. DRYWALL SCREWS ARE NOT ACCEPTABLE. PAINT WITH TWO COATS OF LIGHT GRAY FIRE RETARDANT SEALER PRIOR TO INSTALLATION OF ANY EQUIPMENT.
 - 3 TELECOMMUNICATIONS GROUND BAR SHALL BE 13-1/4"W x 2"H x 1/4" THICK ELECTRO-TIN PLATED COPPER BUS BAR, COMPLETE WITH INSULATED STAND-OFFS AND STAINLESS STEEL BRACKETS, ERICO #TGBA14L06PT OR EQUAL. MOUNT AT 18" AFF. ALL CONNECTIONS TO GROUND BAR SHALL BE MADE USING COMPRESSION TYPE LUGS.
 - 4 CIRCUIT BREEZEWAY LIGHTS FOR CONTINUOUS OPERATION. SEE FLOORS ABOVE FOR CONTINUATION OF BREEZEWAY LIGHTING CIRCUIT.
 - 5 WHERE FIRE PROTECTION PIPING MUST CROSS HALLWAY, ROUTE IN SOFFIT. PROVIDE HEAT TRACE AND INSULATE PIPING IN SOFFIT PER HEAT TRACE MANUFACTURER'S INSTRUCTIONS. PROVIDE ALL REQUIRED HEAT TRACE COMPONENTS AND CONTROLS FOR FREEZE PROTECTION OF PIPING. SEE WATER RISER CLOSET FOR MORE INFORMATION.
 - 6 (2) 2" CONDUITS FOR COMMUNICATIONS SERVICES. SEE SITE PLAN FOR CONTINUATION.
 - 7 PROVIDE PHOTOCELL ON NORTH SIDE OF BUILDING FOR OPERATION OF PARKING LOT LIGHTS AND BUILDING MOUNTED LIGHTS. SEE DETAIL 1-E6.1 & 2-E6.1 FOR MORE INFORMATION.

2 BUILDING C-SECOND FLOOR-POWER PLAN
 1/8" = 1'-0"

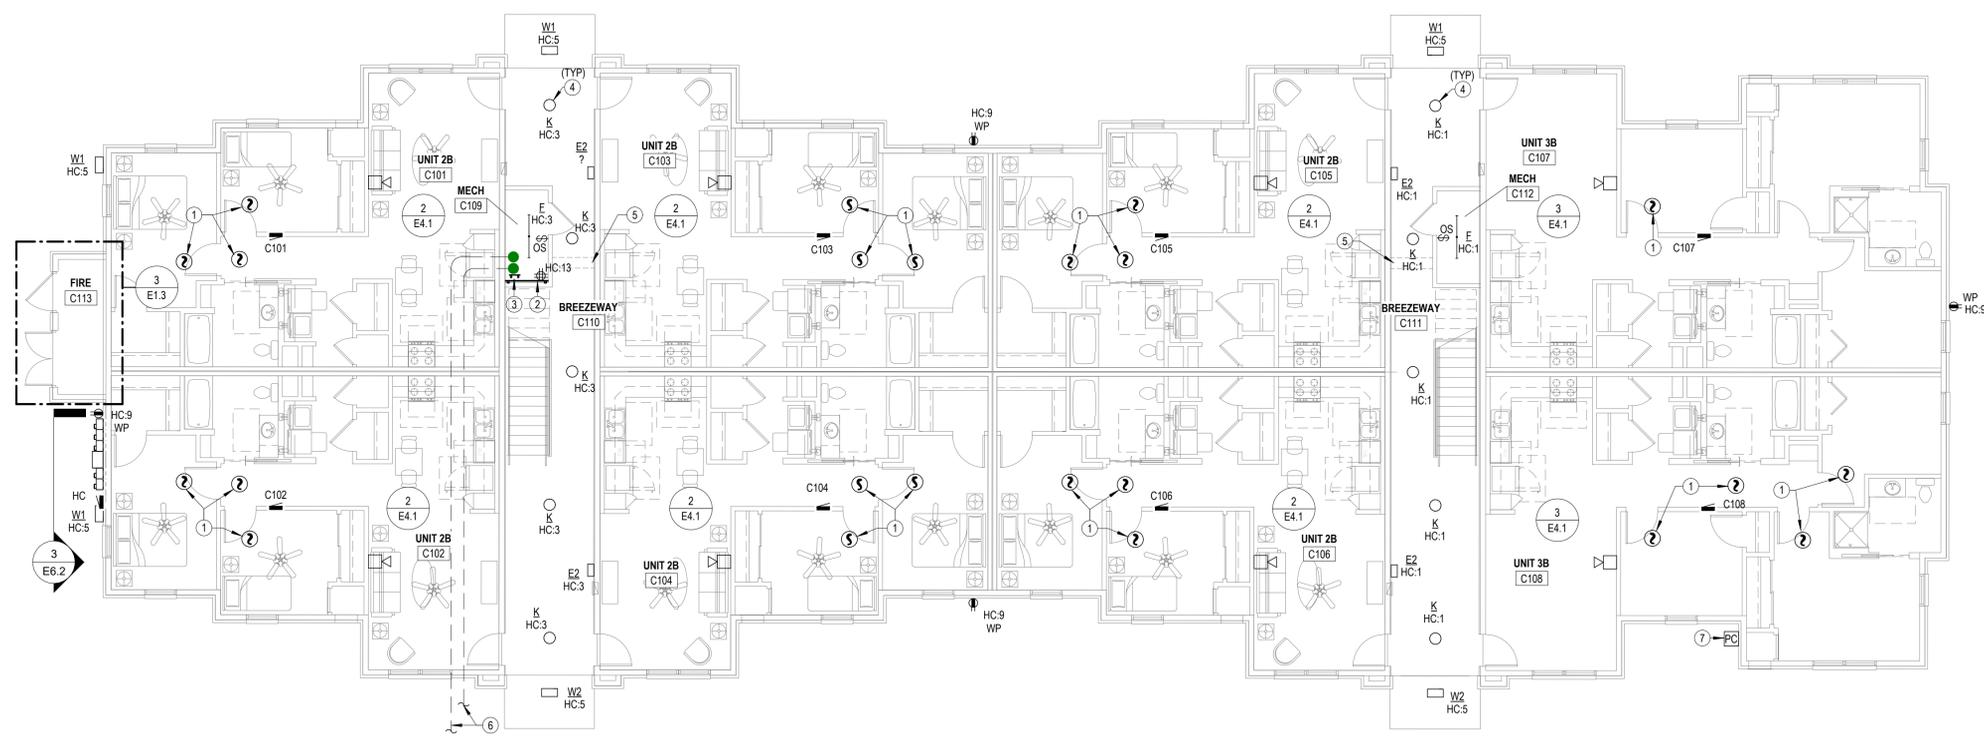

1 BUILDING C-FIRST FLOOR-POWER PLAN
 1/8" = 1'-0"

COPYRIGHTED ©

GENERAL FIRE ALARM NOTES

1 DB RATING FOR ALL FIRE ALARM HORNS SHALL BE SET 15 DB ABOVE AMBIENT PER CODE REQUIREMENTS.

LST Consulting Engineers, PA

MANHATTAN 4809 Vue Du Lac Place, Suite 201
Manhattan, KS 66503
785.587.8042
www.LSTengineers.com
mail@LSTengineers.com

WICHITA 125 S. Washington, Suite 150
Wichita, KS 67202
316.285.0696

Project 24072 05/09/2025

NOTES BY SYMBOL

1 CEILING MOUNTED SMOKE ALARM IN APARTMENTS TO BE 120VAC WITH 9V BATTERY BACKUP, INTERCONNECTED TO OTHERS IN SAME APARTMENT. DEVICE SHALL HAVE PHOTOELECTRIC TYPE SMOKE DETECTOR WITH SOUNDER HORN HAVING AN 85 db OUTPUT AT 10', SHALL HAVE A SINGLE BUTTON FOR TEST/SILENCE AND LED INDICATOR LIGHTS, AND SHALL BE UL 217 LISTED, BRK #SC701LBL OR EQUAL.

2 PROVIDE RECEPTACLE IN ATTIC NEAR RADON PIPE FOR FUTURE RADON FAN.

3 DOWNLIGHTS TO BE INSTALLED IN SOFFIT ABOVE THIRD FLOOR.

JGR JonesGillamRenz

1881 Main Street, Suite 301
Salina, KS 67401
785.827.0386
jgr@jgarchitects.com




THE RESERVES AT COBALT CIRCLE

NEW APARTMENT COMPLEX

BROWNSVILLE

TENNESSEE

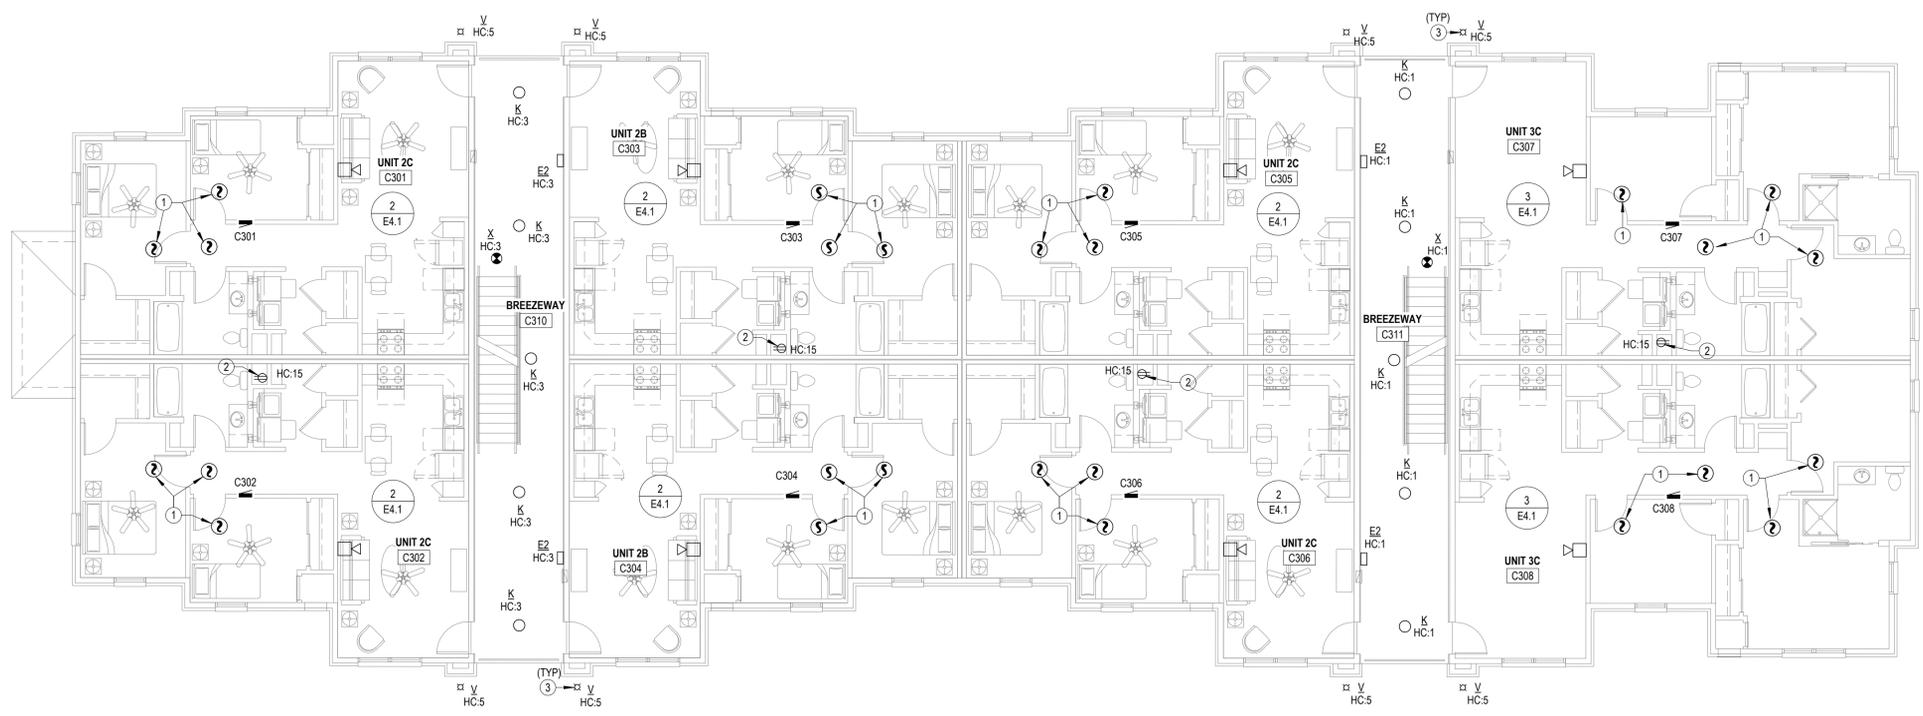

1 BUILDING C-THIRD FLOOR-POWER PLAN
1/8" = 1'-0"



REVISIONS:		
1	12-3-2025	ASI #5
2	01-20-2026	ASI #8
DATE: 05/09/2025		
JOB: 24-3446		
SHEET NO.:		

E1.6

COPYRIGHTED

GENERAL PANEL SCHEDULE NOTES
 1 FIRE ALARM CONTROL PANEL CIRCUIT BREAKER SHALL HAVE RED MARKING AND BE PERMANENTLY IDENTIFIED PER NFPA 72, 10.6.5.2.2, 10.6.5.2.3, 10.6.5.2.5.

LST Consulting Engineers, PA
 MANHATTAN 4809 Vue Du Lac Place, Suite 201 125 S. Washington, Suite 150
 WICHITA 785 587 8042 785 587 8042
 WICHITA 316 285 0696
 www.LSTengineers.com
 mail@LSTengineers.com
Project 24072 05/09/2025

JGR
 JonesGillamRenz
 1881 Main Street, Suite 301
 Salina, KS 67401
 785.827.0386
 jgr@jgarchitects.com

THE RESERVES AT COBALT CIRCLE
 NEW APARTMENT COMPLEX
 BROWNVILLE
 TENNESSEE

Designation: 1B
 Installed Location: Voltage: 120/208 1PH 3W-1Ph-3W
 Mounting: Flush Enclosure: NEMA 1
 Bus Amps: 150 MCB Amps: MLO Features & Modifications: -
 SCCR/AIC: 22.0 kA Mains FN/Note: -

Ckt	Description	Circuitry	Trip (A)	FN	A	B	FN	Trip (A)	Circuitry	Description	Ckt
1B-1	Kitchen Receptacles	1/2"C,1#12,#12N,#12G	20	AG	5 A	0 A		30	1/2"C,2#10,#10G	Electric Water Heating	1B-2
1B-3	Kitchen Receptacles	1/2"C,1#12,#12N,#12G	20	AG	4 A	41 A	9 A	0 A			1B-4
1B-5	Dishwasher	1/2"C,1#12,#12N,#12G	20	AG	4 A	41 A		G	1/2"C,2#10,#10N,#10G	Clothes Dryer	1B-6
1B-7	Refrigerator	1/2"C,1#12,#12N,#12G	20	AG	2 A	41 A	2 A	41 A			1B-8
1B-9	Hood/Microwave	1/2"C,1#12,#12N,#12G	20	AG	2 A	41 A		G	3/4"C,2#6,#6N,#10G	Range	1B-10
1B-11	Living Room Receptacles	1/2"C,1#12,#12N,#12G	20	A			9 A	41 A			1B-12
1B-13	Kitchen/Living/Hall Lighting	1/2"C,1#12,#12N,#12G	20	A	2 A	0 A			1/2"C,2#12,#12G	VTAC-12	1B-14
1B-15	Bathroom	1/2"C,1#12,#12N,#12G	20	A			3 A	0 A			1B-16
1B-17	Bedroom	1/2"C,1#12,#12N,#12G	20	A	6 A	2 A		AG	1/2"C,1#12,#12N,#12G	Clothes Washer Receptacle	1B-18
1B-19	Spare	--	20				0 A	0 A			1B-20
1B-21	Spare	--	20		0 A	--					1B-22
1B-23	Spare	--	20				0 A	--			1B-24

Designation: HA
 Installed Location: Voltage: 120/208 1PH 3W-1Ph-3W
 Mounting: Surface Enclosure: NEMA 1
 Bus Amps: 100 MCB Amps: MLO Features & Modifications: -
 SCCR/AIC: 22.0 kA Mains FN/Note: -

Ckt	Description	Circuitry	Trip (A)	FN	A	B	FN	Trip (A)	Circuitry	Description	Ckt
HA-1	East Breezeway Lights	1/2"C,1#12,#12N,#12G	20		310...	360...		20	1/2"C,1#12,#12N,#12G	FIRE ALARM CIRCUIT	HA-2
HA-3	West Breezeway Lights	1/2"C,1#12,#12N,#12G	20		310...	360...		20	1/2"C,1#12,#12N,#12G	Fire Sprinkler Flow Switches	HA-4
HA-5	Exterior Lighting	3/4"C,1#10,#10N,#10G	20		340...	360...		20	1/2"C,1#12,#12N,#12G	Heat Trace Circuit #1	HA-6
HA-7	Parking Lot Pole Mounted Lights	3/4"C,1#10,#10N,#10G	20		291...	0 VA		20	1/2"C,1#12,#12N,#12G	Heat Trace Circuit #2	HA-8
HA-9	Exterior Receptacles/ Fire A113 Lighting	1/2"C,1#12,#12N,#12G	20		607...	180...		20	1/2"C,1#12,#12N,#12G	Fire Sprinkler Air Compressor	HA-10
HA-11	Timedock	1/2"C,1#12,#12N,#12G	20		360...	150...		20	1/2"C,2#12,#12G	Electric Wall Heater 'EWH-1'	HA-12
HA-13	Telecomm	1/2"C,1#12,#12N,#12G	20		360...	150...		20			HA-14
HA-15	Future Radon Fans	1/2"C,1#12,#12N,#12G	20		222...	211...		30	1/2"C,2#10,#10G	Domestic Water Booster Pump	HA-16
HA-17	Monument Sign Lights	3/4"C,1#10,#10N,#10G	20								HA-18
HA-19	Spare	--	20				0 VA	--			HA-20
HA-21	Spare	--	20		0 VA	--		--			HA-22
HA-23	Spare	--	20				0 VA	--			HA-24

Connected Load: 6352 VA 5654 VA
 Connected Amps: 60 A 54 A

Designation: 2B
 Installed Location: Voltage: 120/208 1PH 3W-1Ph-3W
 Mounting: Flush Enclosure: NEMA 1
 Bus Amps: 150 MCB Amps: MLO Features & Modifications: -
 SCCR/AIC: 22.0 kA Mains FN/Note: -

Ckt	Description	Circuitry	Trip (A)	FN	A	B	FN	Trip (A)	Circuitry	Description	Ckt	
2B-1	Kitchen Receptacles	1/2"C,1#12,#12N,#12G	20	AG	5 A	0 A		30	1/2"C,2#10,#10G	Electric Water Heating	2B-2	
2B-3	Kitchen Receptacles	1/2"C,1#12,#12N,#12G	20	AG	4 A	41 A	9 A	0 A			2B-4	
2B-5	Dishwasher	1/2"C,1#12,#12N,#12G	20	AG	4 A	41 A		G	1/2"C,2#10,#10N,#10G	Clothes Dryer	2B-6	
2B-7	Refrigerator	1/2"C,1#12,#12N,#12G	20	AG	2 A	41 A	2 A	41 A			2B-8	
2B-9	Hood/Microwave	1/2"C,1#12,#12N,#12G	20	A	2 A	41 A		G	3/4"C,2#6,#6N,#10G	Range	2B-10	
2B-11	Living Room Receptacles	1/2"C,1#12,#12N,#12G	20	A			8 A	41 A			2B-12	
2B-13	Kitchen/Living/Hall Lighting	1/2"C,1#12,#12N,#12G	20	A	2 A	8 A		30	1/2"C,2#10,#10G	VTAC-18	2B-14	
2B-15	Bathroom	1/2"C,1#12,#12N,#12G	20	A			2 A	8 A			2B-16	
2B-17	Bedroom 1	1/2"C,1#12,#12N,#12G	20	A	5 A	2 A		AG	1/2"C,1#12,#12N,#12G	Clothes Washer Receptacle	2B-18	
2B-19	Bedroom 2	1/2"C,1#12,#12N,#12G	20	A			9 A	5 A	20	1/2"C,1#12,#12N,#12G	Laundry/Hall Receptacles	2B-20
2B-21	Spare	--	20		0 A	--					2B-22	
2B-23	Spare	--	20				0 A	--			2B-24	

Designation: HB
 Installed Location: Voltage: 120/208 1PH 3W-1Ph-3W
 Mounting: Surface Enclosure: NEMA 1
 Bus Amps: 100 MCB Amps: MLO Features & Modifications: -
 SCCR/AIC: 42.0 kA Mains FN/Note: -

Ckt	Description	Circuitry	Trip (A)	FN	A	B	FN	Trip (A)	Circuitry	Description	Ckt
HB-1	East Breezeway Lights	1/2"C,1#12,#12N,#12G	20		310...	360...		20	1/2"C,1#12,#12N,#12G	FIRE ALARM CIRCUIT	HB-2
HB-3	West Breezeway Lights	1/2"C,1#12,#12N,#12G	20		310...	360...		20	1/2"C,1#12,#12N,#12G	Fire Sprinkler Flow Switches	HB-4
HB-5	Exterior Lighting	1/2"C,1#12,#12N,#12G	20		193...	360...		20	1/2"C,1#12,#12N,#12G	Heat Trace Circuit #1	HB-6
HB-7	Parking Lot Pole Mounted Lights	3/4"C,1#10,#10N,#10G	20		264...	0 VA		20	1/2"C,1#12,#12N,#12G	Heat Trace Circuit #2	HB-8
HB-9	Exterior Receptacles/ Fire B113 Lighting	1/2"C,1#12,#12N,#12G	20		787...	180...		20	1/2"C,1#12,#12N,#12G	Fire Sprinkler Air Compressor	HB-10
HB-11	Timedock	1/2"C,1#12,#12N,#12G	20		360...	150...		20	3/4"C,2#8,#8G	Electric Wall Heater 'EWH-1'	HB-12
HB-13	Telecomm	1/2"C,1#12,#12N,#12G	20		360...	150...		20			HB-14
HB-15	Future Radon Fans	1/2"C,1#12,#12N,#12G	20		720...	211...		30	3/4"C,2#8,#8G	Domestic Water Booster Pump	HB-16
HB-17	Spare	--	20		0 VA	211...		--			HB-18
HB-19	Spare	--	20		0 VA	--		--			HB-20
HB-21	Spare	--	20		0 VA	--		--			HB-22
HB-23	Spare	--	20				0 VA	--			HB-24

Connected Load: 6163 VA 5628 VA
 Connected Amps: 59 A 54 A

Designation: 3B
 Installed Location: Voltage: 120/208 1PH 3W-1Ph-3W
 Mounting: Flush Enclosure: NEMA 1
 Bus Amps: 150 MCB Amps: MLO Features & Modifications: -
 SCCR/AIC: 22.0 kA Mains FN/Note: -

Ckt	Description	Circuitry	Trip (A)	FN	A	B	FN	Trip (A)	Circuitry	Description	Ckt	
3B-1	Kitchen Receptacles	1/2"C,1#12,#12N,#12G	20	AG	5 A	41 A		50	3/4"C,2#6,#6N,#10G	Range	3B-2	
3B-3	Kitchen Receptacles	1/2"C,1#12,#12N,#12G	20	AG	4 A	41 A	9 A	41 A			3B-4	
3B-5	Dishwasher	1/2"C,1#12,#12N,#12G	20	AG	4 A	41 A		G	1/2"C,2#10,#10N,#10G	Clothes Dryer	3B-6	
3B-7	Refrigerator	1/2"C,1#12,#12N,#12G	20	AG	2 A	41 A	2 A	41 A			3B-8	
3B-9	Hood/Microwave	1/2"C,1#12,#12N,#12G	20	AG	2 A	0 A		30	1/2"C,2#10,#10G	Electric Water Heating	3B-10	
3B-11	Living Room Receptacles	1/2"C,1#12,#12N,#12G	20	A			8 A	0 A			3B-12	
3B-13	Kitchen/Living/Hall Lighting	1/2"C,1#12,#12N,#12G	20	A	2 A	8 A		30	1/2"C,2#10,#10G	VTAC-18	3B-14	
3B-15	Hall Bathroom	1/2"C,1#12,#12N,#12G	20	A			2 A	8 A			3B-16	
3B-17	Bedroom 2	1/2"C,1#12,#12N,#12G	20	A	6 A	2 A		AG	1/2"C,1#12,#12N,#12G	Clothes Washer Receptacle	3B-18	
3B-19	Bedroom 3	1/2"C,1#12,#12N,#12G	20	A			8 A	5 A	20	1/2"C,1#12,#12N,#12G	Laundry/Hall Receptacles	3B-20
3B-21	Master Bedroom	1/2"C,1#12,#12N,#12G	20	A	8 A	--		--			3B-22	
3B-23	Master Bathroom	1/2"C,1#12,#12N,#12G	20				2 A	--			3B-24	

Designation: C
 Installed Location: Voltage: 120/208 1PH 3W-1Ph-3W
 Mounting: Surface Enclosure: NEMA 1
 Bus Amps: 200 MCB Amps: MLO Features & Modifications: Provide Integral Surge Protection
 SCCR/AIC: 10.0 kA Mains FN/Note: -

Ckt	Description	Circuitry	Trip (A)	FN	A	B	FN	Trip (A)	Circuitry	Description	Ckt
C-1	Lighting - Office, Community, Kitchenette, Mech	1/2"C,1#12,#12N,#12G	20		460...	900...		20	1/2"C,1#12,#12N,#12G	Receptacle - Office A114	C-2
C-3	Lighting - Rest Rooms, Hall, Fitness, Storage	1/2"C,1#12,#12N,#12G	20		413...	720...		20	1/2"C,1#12,#12N,#12G	Receptacle - Community Room A115	C-4
C-5	Receptacle - Hall A120	1/2"C,1#12,#12N,#12G	20		720...	720...		20	1/2"C,1#12,#12N,#12G	Receptacle - Kitchenette A116	C-6
C-7	Receptacle - Fitness A121	1/2"C,1#12,#12N,#12G	20		720...	839...		20	1/2"C,1#12,#12N,#12G	Receptacle - Mech A117	C-8
C-9	Receptacle - Fitness A121	1/2"C,1#12,#12N,#12G	20		720...	360...		20	1/2"C,1#12,#12N,#12G	Receptacle - Storage A122	C-10
C-11	Receptacle - Fitness A121	1/2"C,1#12,#12N,#12G	20		720...	360...		20	1/2"C,1#12,#12N,#12G	Receptacle - Storage A122	C-12
C-13	Receptacle - Dishwasher	1/2"C,1#12,#12N,#12G	20		500...	234...		30	1/2"C,2#10,#10G	Hot Water Heater 'HW-H'	C-14
C-15	Receptacle - Disposal	1/2"C,1#12,#12N,#12G	20		680...	234...		30			C-16
C-17	Receptacle - Refrigerator	1/2"C,1#12,#12N,#12G	20		180...	221...		30	1/2"C,2#10,#10G	Blower Coil 'BC-1'	C-18
C-19	Heater 'EH-1'	1/2"C,2#10,#10G	30		183...	221...		30			C-20
C-21	Receptacle - Office A114 (Controlled)	1/2"C,1#12,#12N,#12G	20		183...	156...		20	1/2"C,2#12,#12G	Heat Pump 'HP-1'	C-22
C-23	Other	1/2"C,1#12,#12N,#12G	20		360...	--		--			C-24
C-25	Spare	--	20		0 VA	--		--			C-26
C-27	Spare	--	20		0 VA	--		--			C-28
C-29	Spare	--	20		0 VA	--		--			C-30
C-31	Spare	--	20		0 VA	--		--			C-32
C-33	Spare	--	20		--	--		--			C-34
C-35	Spare	--	20		--	--		--			C-36
C-37	Spare	--	20		--	--		--			C-38
C-39	Spare	--	20		--	--		--			C-40
C-41	Spare	--	20		--	--		--			C-42

Connected Load: 12865 VA 13117 VA
 Connected Amps: 124 A 126 A

Designation: HC
 Installed Location: Voltage: 120/208 1PH 3W-1Ph-3W
 Mounting: Surface Enclosure: NEMA 1
 Bus Amps: 100 MCB Amps: MLO Features & Modifications: -
 SCCR/AIC: 42.0 kA Mains FN/Note: -

Ckt	Description	Circuitry	Trip (A)	FN	A	B	FN	Trip (A)	Circuitry	Description	Ckt
HC-1	East Breezeway Lights	1/2"C,1#12,#12N,#12G	20		3 A	3 A		20	1/2"C,1#12,#12N,#12G	FIRE ALARM CIRCUIT	HC-2
HC-3	West Breezeway Lights	1/2"C,1#12,#12N,#12G	20		3 A	3 A		20	1/2"C,1#12,#12N,#12G	Fire Sprinkler Flow Switches	HC-4
HC-5	Exterior Lighting	1/2"C,1#12,#12N,#12G	20		2 A	3 A		20	1/2"C,1#12,#12N,#12G	Heat Trace Circuit	



REVISIONS:

1	10-30-2025	ASI #4
2	01-20-2026	ASI #8


DATE: 05/09/2025

JOB: 24-3446

SHEET NO.:

M1.1


COPYRIGHTED

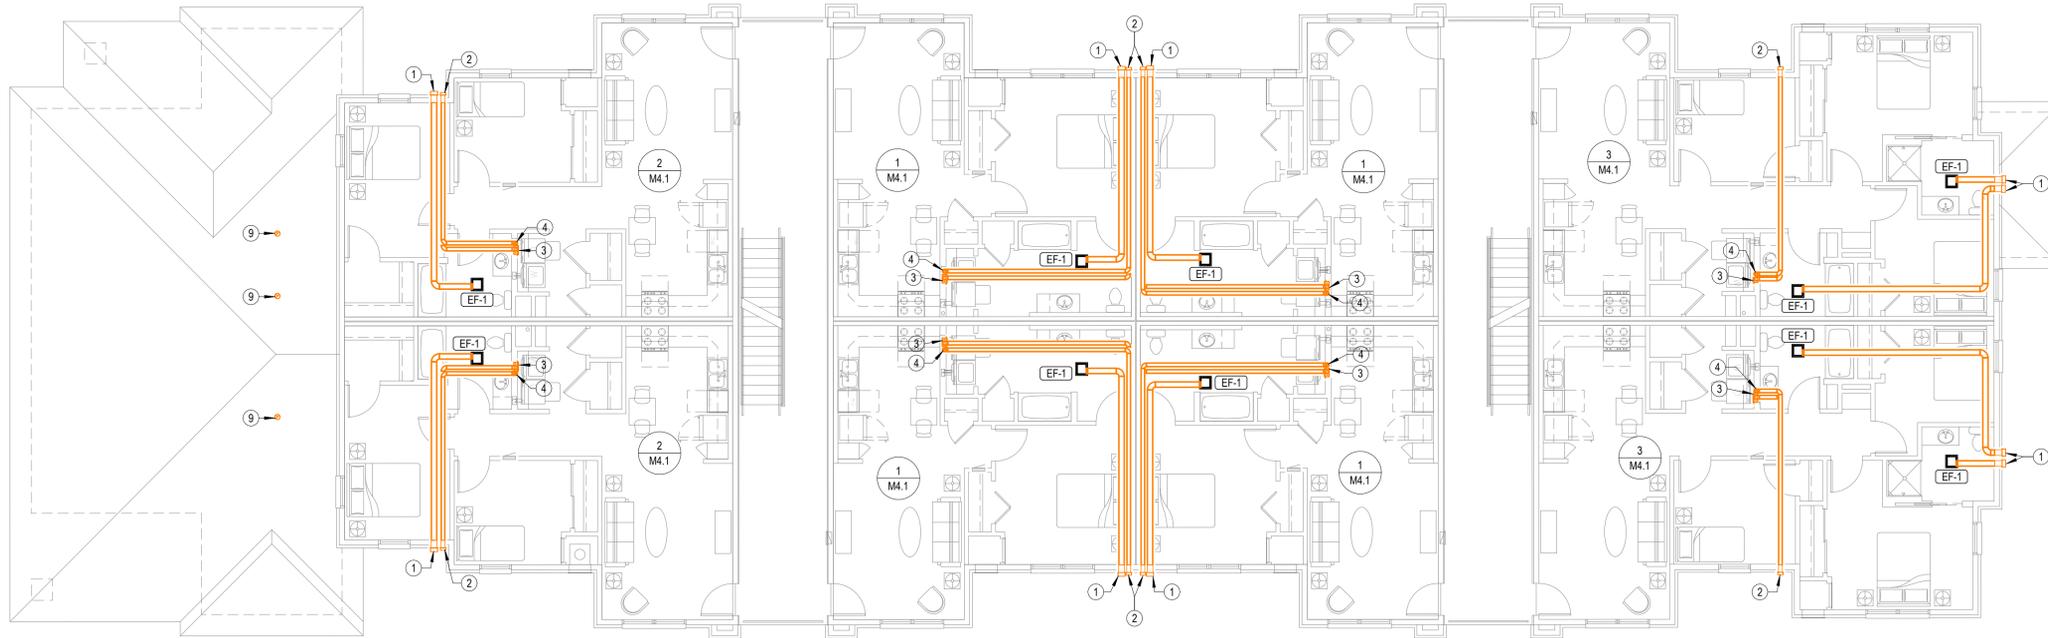

- GENERAL MECHANICAL NOTES**
- 1 PROVIDE SHOP DRAWINGS SHOWING EXACT ROUTING OF REFRIGERANT PIPING FOR REVIEW BY ARCHITECT AND ENGINEER.
 - 2 INSTALL REFRIGERANT PIPING IN ACCORDANCE WITH ALL PROVISIONS OF ASHRAE 15 INCLUDING LATEST ADDENDA.
 - 3 PROTECT PIPING PER ASHRAE 15 SECTION 9.12.
 - 4 PRESSURE TEST PIPING PER ASHRAE 15 SECTION 9.13.
 - 5 DUCTWORK CONSTRUCTION SHALL COMPLY WITH 2021 IECC.

- NOTES BY SYMBOL**
- 1 ROUTE 6" Ø EXHAUST DUCT TO MANUFACTURER'S WALL CAP WITH BACKDRAFT DAMPER AND BIRD SCREEN. COORDINATE FINAL LOCATION WITH ARCHITECT.
 - 2 4" DRYER DUCT. SEE ENLARGED PLANS FOR MORE INFORMATION. COORDINATE FINAL LOCATION OF WALL CAP WITH ARCHITECT.
 - 3 PROVIDE UL LISTED DRYER BOX EQUAL TO IN-O-VATE TECHNOLOGIES IN WALL INSTALLED IN ACCORDANCE WITH MANUFACTURER'S RECOMMENDATIONS, AND ROUTE 4" Ø DRYER EXHAUST DUCT TO WALL CAP WITH BACKDRAFT DAMPER. SEE OVERALL MECHANICAL PLANS FOR UNIT SPECIFIC ROUTING. MAXIMUM ALLOWABLE EQUIVALENT DUCT LENGTH = 35'. UTILIZE LONG RADIUS SMOOTH ELBOWS WHERE REQUIRED. MAXIMUM EQUIVALENT DUCT LENGTH MAY BE INCREASED WHERE DRYER MANUFACTURER'S INSTALLATION INSTRUCTIONS ALLOW, AND DOCUMENTATION IS PROVIDED TO CODE OFFICIAL PRIOR TO CONCEALMENT INSPECTION. COORDINATE EXACT REQUIREMENTS WITH EQUIPMENT PROVIDED. PROVIDE PERMANENT LABEL IDENTIFYING EQUIVALENT LENGTH OF DRYER DUCT INSTALLED PER IMC 504.
 - NOTE: ANNUAL SPACE AROUND DUCT IS TO BE SEALED AT ALL PENETRATIONS OF FLOORS AND CEILINGS WITH U.L. LISTED FIRE STOPPING SYSTEM.
 - 4 DRYER EXHAUST DUCT ROUTED FROM THIRD FLOOR ROUTED AS HIGH AS POSSIBLE BELOW THIRD FLOOR TO MANUFACTURER'S WALL CAP.
 - 5 ROUTE REFRIGERANT PIPING FROM HEAT PUMP TO BLOWER COIL. PENETRATE WALL 1/8" AFG AND ROUTE PIPING CONCEALED IN WALLS AND ABOVE CEILINGS. UTILIZE PIPE PENETRATION ASSEMBLY EQUAL TO APREX TITAN OUTLET.
 - 6 MOUNT HEAT PUMP ON 3-1/2" CONCRETE PAD. COORDINATE EXACT LOCATION WITH OWNER.
 - 7 PROVIDE 6"x8" ALUMINUM OUTDOOR AIR GRILLE EQUAL TO TITUS MODEL 301. PROVIDE WITH BIRD SCREEN AND TRANSITION TO 6" DIA. DUCT.
 - 8 PROVIDE CEILING RADIATION DAMPER AT DUCT PENETRATION OF RATED CEILING ASSEMBLY.
 - 9 PROVIDE ROOF JACK FOR EXHAUST TERMINATION.

2 BUILDING A-SECOND FLOOR-HVAC PLAN
 1/8" = 1'-0"

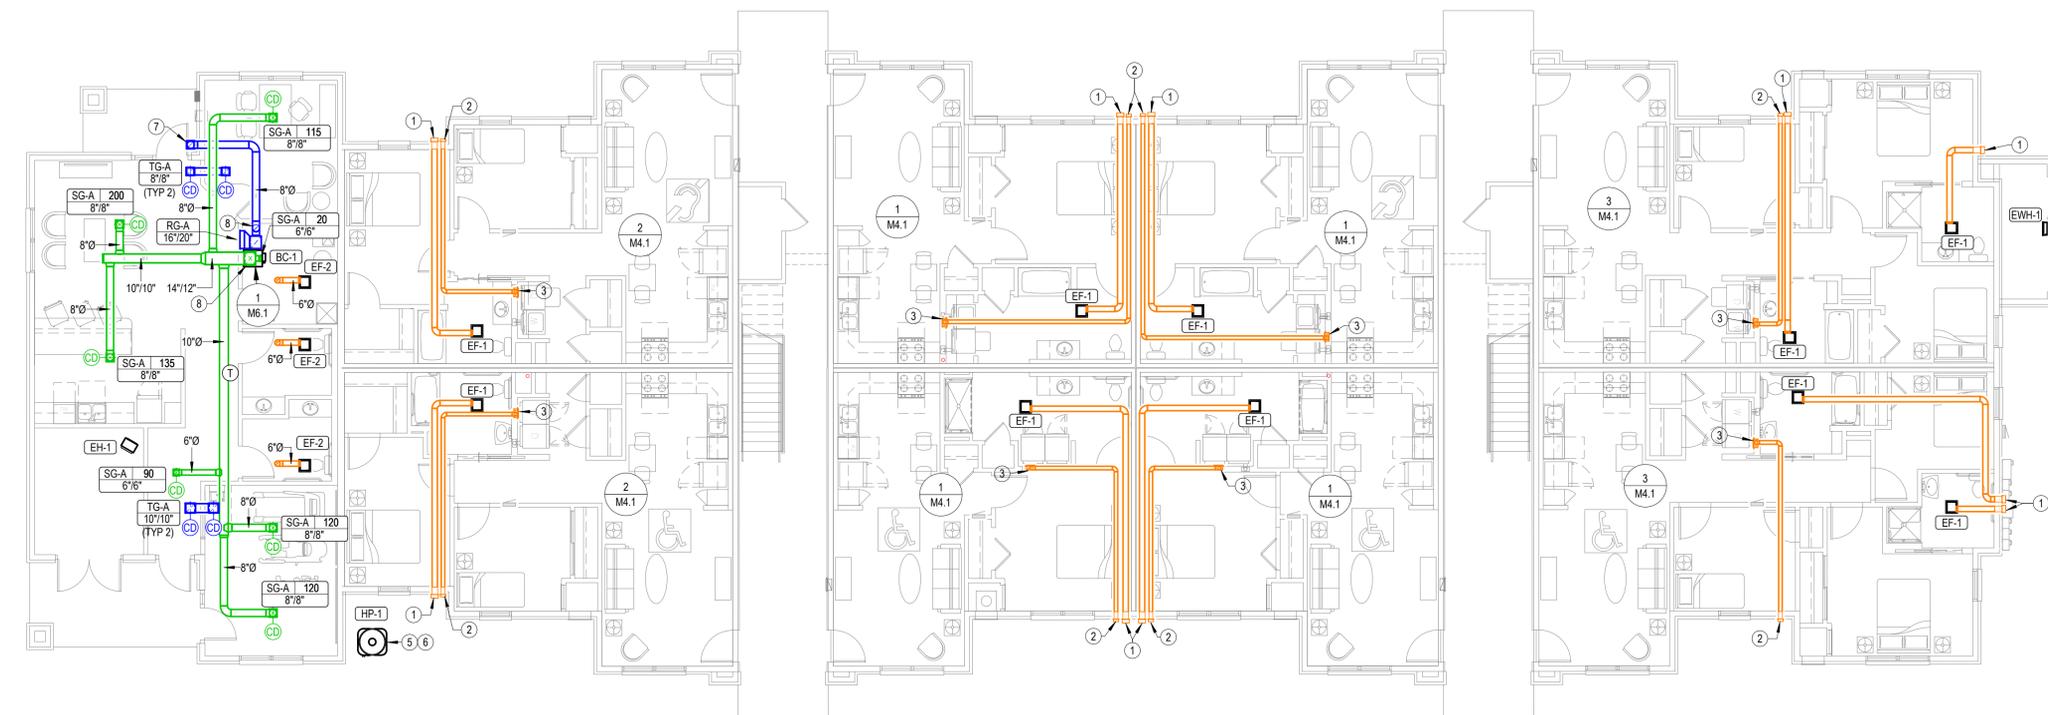

1 BUILDING A-FIRST FLOOR-HVAC PLAN
 1/8" = 1'-0"




REVISIONS:

1	01-20-2026	ASI #8
---	------------	--------

DATE: 05/09/2025
 JOB: 24-3446
 SHEET NO.:

METAL-FAB inc. INSTALLATION INSTRUCTION SUPPLEMENT
 MODELS MRCD MSCD & MCCD
 GYPSUM BOARD/WOOD TRUSS INSTALLATION

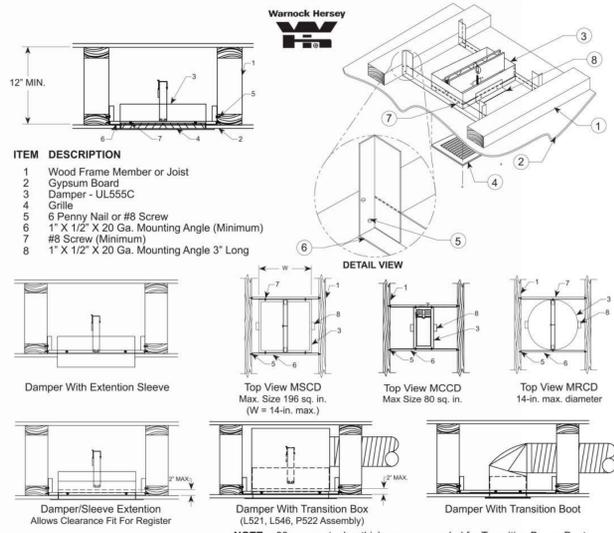

INSTALLATION:

A. Measure spacing between framing members and cut the mounting angle (two required) to that length plus 6 inches. Cut the 1 inch side of each mounting angle approximately 3 inches from each end of the mounting angle and bend angle up 90° at both ends as shown in detailed view above. Attach angles to wood frame with minimum of two each #6 penny nails or #8 screws.

B. Attach the ceiling damper (or metal surrounds such as sleeve, transition box or boot) to the mounting angles using screws or rivets. A minimum of 2 fasteners per mounting angle is required for rectangular dampers. A minimum of one fastener is required for round dampers.

C. On the sides adjacent to the retaining angles, a 3-inch long mounting angle is required. A minimum of two fasteners is required to attach the mounting angles to damper. Bottom leg of mounting angle should rest on the ceiling material.

IMPORTANT: FASTENERS USED TO ATTACH MOUNTING ANGLES TO DAMPER SHALL NOT INTERFERE WITH DAMPER BLADE MOTION.

D. If damper has an adjustable volume control, the 2 fuse links (shipped loose with damper) must be installed on damper for proper operation.

E. Cycle damper after installation is completed.

VERTICAL PACKAGED TERMINAL AIR CONDITIONER SCHEDULE

MARK	MANUFACTURER	MODEL NUMBER	OA DB	ENT DB	ENT WB	COOLING			HEATING			ELECTRICAL				NOTES		
						SENSIBLE	TOTAL	SEER2	TOTAL HEATING	HSPF2	ELECTRIC HEAT OUTPUT	AIRFLOW	ESP	FAN SPEED	MCA		MOCP	VOLTAGE
VTAC-12	Friedrich	VHA12-34RTQ	95 °F	75 °F	63 °F	6,797 Btu/h	9,850 Btu/h	14.3	10,400 Btu/h	7.5	2.7 kW	420 CFM	0.30 in-wg	HIGH	19 A	20 A	208 V	1
VTAC-18	Friedrich	VHA18-50RTQ	95 °F	75 °F	63 °F	12,248 Btu/h	16,330 Btu/h	14.3	16,000 Btu/h	7.5	4.1 kW	560 CFM	0.30 in-wg	HIGH	28 A	30 A	208 V	1

NOTES:

- Provide with access panel.
- Provide with accessory drain pan.
- Provide with wall plenum and accessory architectural louver in color as selected by architect.
- Provide with wired programmable thermostat.
- Coordinate mounting height of unit and exterior louver with G.C.
- Permanently seal fresh air opening in VTAC unit. Outside air is provided to space via bathroom exhaust fan.
- Provide filter bracket at unit with minimum MERV 6 filter.
- Provide with integral disconnect switch.
- Provide with R-32 refrigerant.

Heat Pump Schedule

Type ID	Manufacturer	Model	Nominal Capacity	Cooling Capacity			Heating Capacity			Electrical							
				EDB	EDB	EWB	Net Sensible Capacity	Rated Cooling Capacity	SEER2 Rating	OA EDB	EDB	Rated Heating Capacity	HSPF2 Rating	Phase	MCA	MOCP	Voltage
HP-1	Trane	4TWR4024	2.0 ton	105 °F	80 °F	67 °F	17,200 Btu/h	22,200 Btu/h	14.3	47 °F	70 °F	22,500 Btu/h	7.5	1	15 A	25 A	208 V

NOTES:

- Refrigerant lines shall be field fabricated. Coordinate line sizing requirements with equipment manufacturer for length.
- Provide 7-day programmable thermostat.
- Provide with R454B refrigerant.
- Provide 2 sets of MERV-7 filters.

Exhaust Fan Schedule

Mark	Manufacturer	Model	CFM	ESP	Power	Electrical Voltage	Phase	Notes
EF-1	Panasonic	FV-0511VQ1	80 CFM	0.25 in-wg	11 W	120 V	1	1,2,3,4,5,6
EF-2	Panasonic	FV-0511VQ1	50 CFM	0.25 in-wg	7 W	120 V	1	1,2,3,4,5,6

NOTES:

- Fixture shall be Energy Star listed.
- Fixture shall operate at < 1 SONE.
- Provide with EC motor with integral disconnect.
- Provide manufacturer's wall cap or roof jack, see plans.
- Provide integral backdraft damper.
- Provide with manufacturer's ceiling radiation damper. Omit radiation dampers where rated ceilings are not present, coordinate with Architect.

Blower Coil Schedule

Mark	Manufacturer	Model	Fan			Heating	Electrical		MCA	MOCP
			Airflow	ESP	Speed		Voltage	Phase		
BC-1	Trane	TEM4A0B31	800 CFM	0.50 in-wg	Medium	5.8 kW	208 V	1	38 A	40 A

NOTES:

- Single point connection required, coordinate the exact electrical requirements of equipment provided with E.C.
- Electric heater shall not operate simultaneously with heat pump. Electric heater shall be used as back-up heat only.

Grilles, Registers & Diffusers Schedule

ID Type	Manufacturer	Model	Application			Mounting	Include Damper	Product Specification
			Supply	Return	Exhaust/Transfer			
RG-A	Titus	355RL	■	■	■	Surface Mount	No	Steel louvered return grille
SG-A	Titus	300R	■	■	■	Surface Mount	Yes	Steel double deflection supply grille with front blades parallel to long dimension
TG-A	Titus	355RL	■	■	■	Surface Mount	No	Steel louvered return grille

NOTES:

- Maximum noise criteria shall be 25.
- Runouts to diffusers shall be same size as neck, U.N.O.
- Paint objects visible through grilles with flat black paint.
- Provide mounting frame as required for ceiling type. Coordinate with Architect.
- Verify finish with Architect.
- Provide devices with radiation dampers as required in rated ceilings. Coordinate with Architect.

Electric Wall Heater Schedule

Mark	Manufacturer	Model	Mounting	Watts	Voltage	Phase	Description	Notes
EW-1	Trane	UHWA	Wall	3.0 kW	208 V	1	Architectural fan forced wall heater	1,2,3

NOTES:


- Provide with high temperature thermal cutout and fan delay.
- Provide with thermostat and unit mounted disconnect switch.
- Provide with manufacturer's surface mounting adapter sleeve.

Electric Unit Heater Schedule


Mark	Manufacturer	Model	Mounting	Watts	Voltage	Phase	Description	Notes
EH-1	Berko	RUX300812	Unit	3.0 kW	208 V	1	Explosion proof heater	1,2,3,4

NOTES:


- Provide with 24V thermostat.
- Provide with mounting bracket as required.
- Provide with integral disconnect switch.
- Mount as high as possible, per manufacturers recommendations.

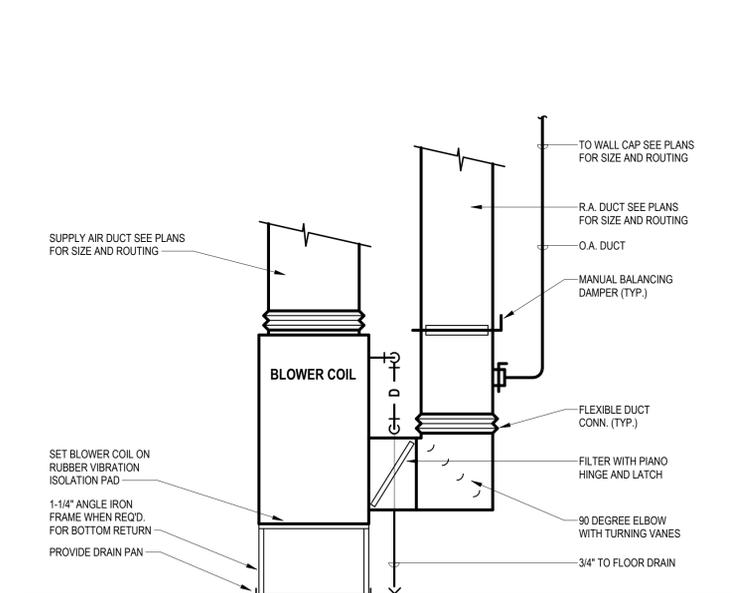

1 BLOWER COIL DETAIL
 NO SCALE

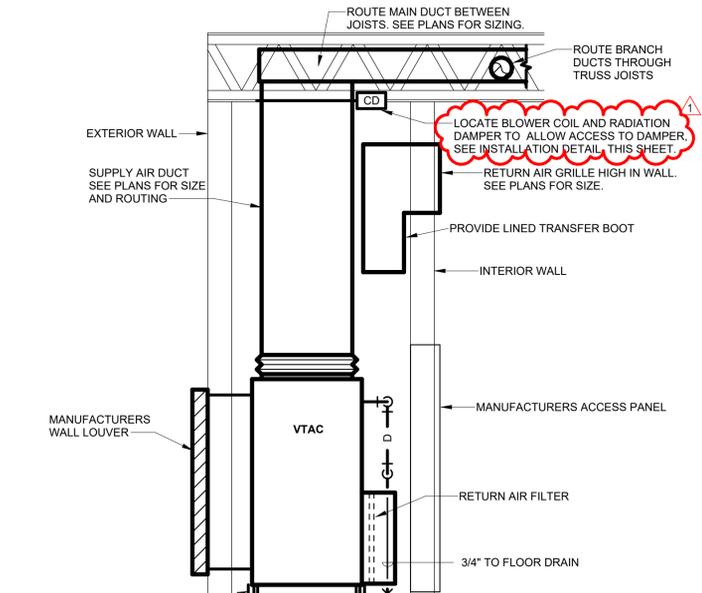

2 VTAC COIL DETAIL
 NO SCALE

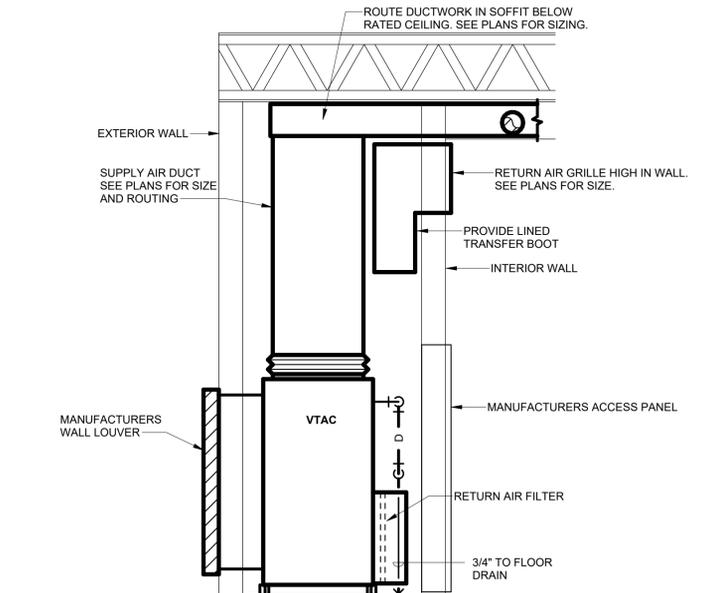

3 VTAC COIL DETAIL 3RD FLOOR
 NO SCALE