


# THE TEMPLE (SALINA INNOVATION FOUNDATION) ELEVATOR REHABILITATION PROJECT

# SALINA,


**25-3499**

# KANSAS

## REFERENCE LEGEND

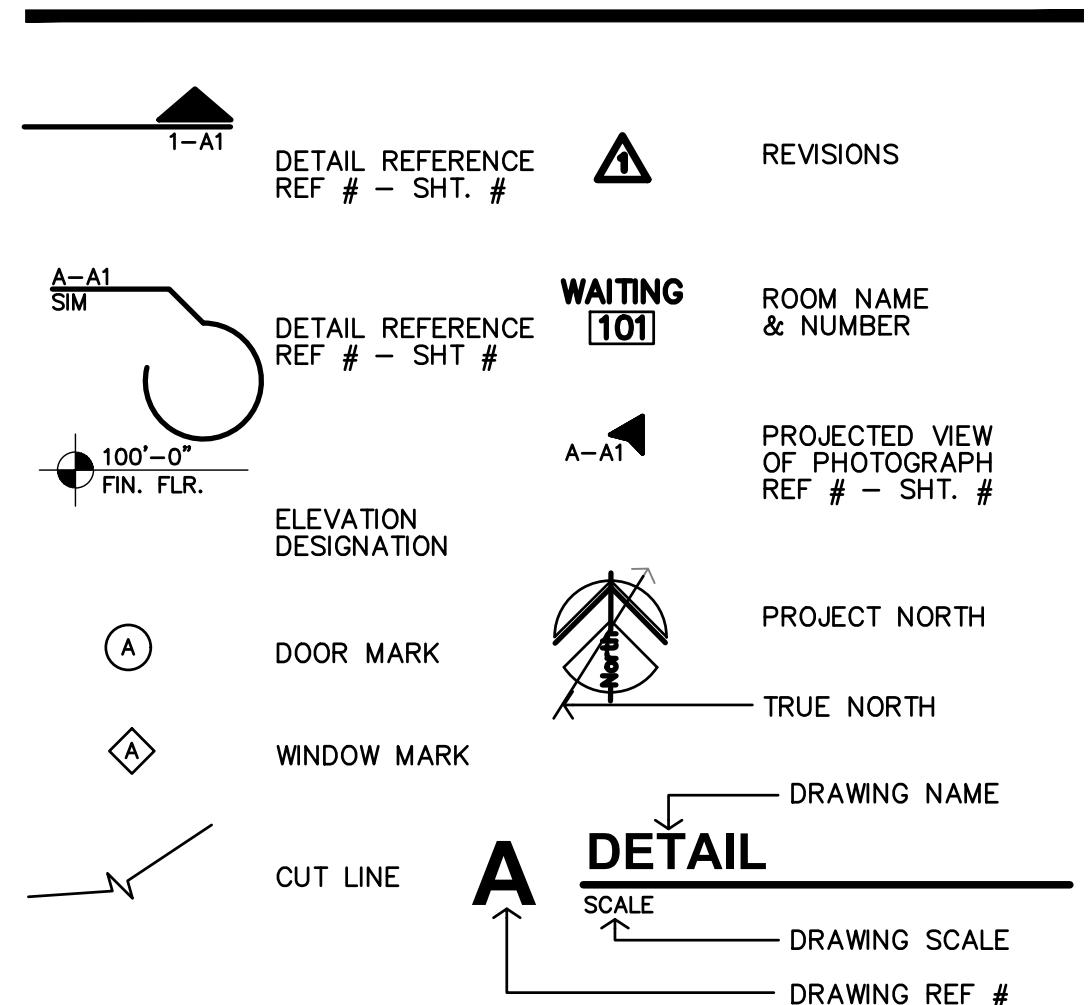

## MATERIAL LEGEND

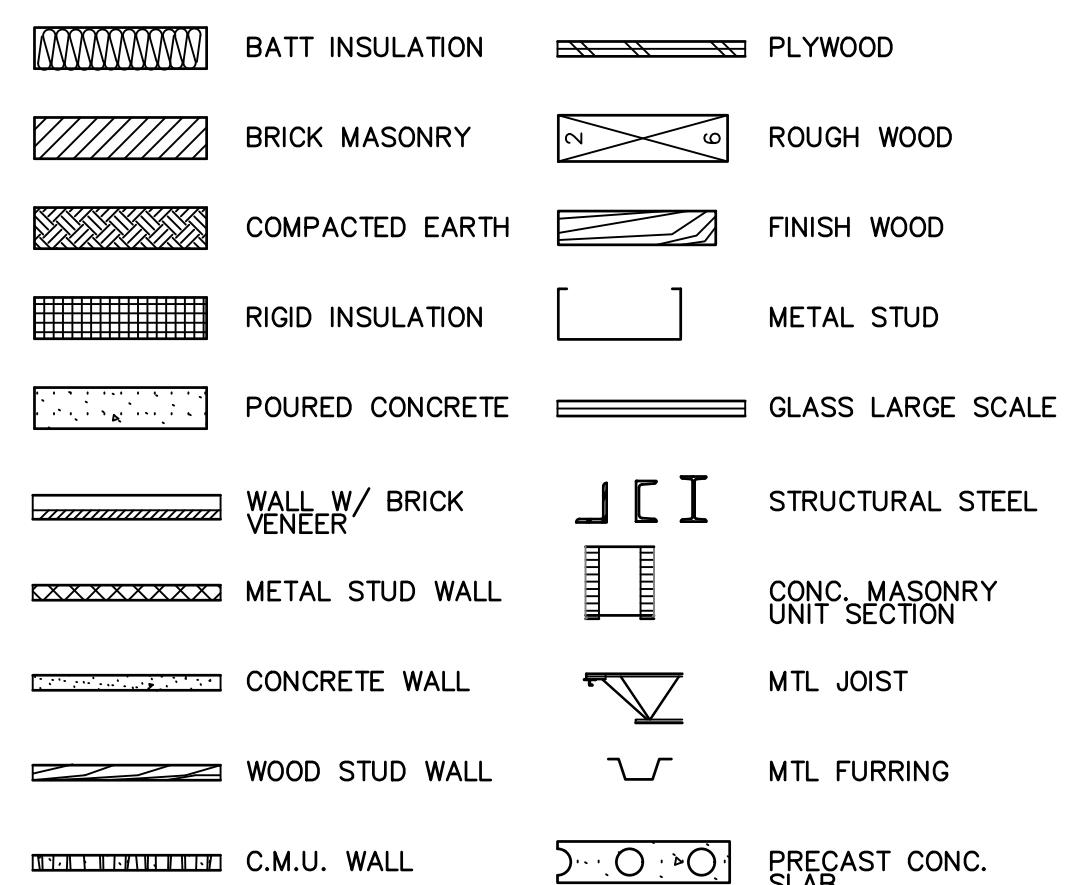

# ABBREVIATIONS

&	AND	Cntr.	Counter	Exp.	Expansion	Hr.	Hour	N.	North	Reinf.	Reinforced	Temp.	Tempered
∠	Angle	Col.	Column	Ext.	Exterior	Hgt.	Height	N.I.C.	Not In Contract	Req'd	Required	T.&G.	Tongue & Groove
@	At	Conc.	Conc.	C.T.	Ceramic Tile	I.D.	Inside Diameter	No. or #	Number	Resil.	Resilient	Thk.	Thick
€	Centerline	CMU	Concrete Masonry Unit	F.D.	Floor Drain	Insul.	Insulation	Nom.	Nominal	Rm.	Room	T.O.M.	Top Of Masonry
Ø	Diameter or Round	Ctr.	Center	Fdn.	Foundation	Int.	Interior	N.T.S.	Not To Scale	R.O.	Rough Opening	T.O.S.	Top Of Steel
#	Pound or Number			F.E.	Fire Extinguisher			O/	On or Over	S.	South	T.P.D.	Toilet Paper Dispenser
Acous.	Acoustical	Dbl.	Double	F.E.C.	F.E. Cabinet	Jan	Janitor	Obs.	Obscure	S.B.	Splash Block	T.V.	Television
Adj.	Adjustable	Det.	Detail	Fin.	Finish	Jt.	Joint	O.C.	On Center	S.C.	Solid Core	T.W.	Tackwall
A.F.F.	Above Finished Floor	D.F.	Drinking Fountain	Fl.	Floor			O.D.	Diameter	Sched.	Schedule	Typ.	Typical
Aggr.	Aggregate	Dia.	Diameter	Flash.	Flashing	Kit.	Kitchen	Off.	Office	S.D.	Soap Dispenser	Trd.	Tread
Al.	Aluminum	Dim.	Dimension	F.	Flow line	Lab.	Laboratory	Opng.	Opening	Sect.	Section		
Approx.	Approximate	Dn.	Down	Ft.	Foot or feet	Lam.	Laminate	Opp.	Opposite	Shr.	Shower	U.O.N.	Unless Otherwise Noted
Arch.	Architect or Architectural	Dr.	Door	Ftg.	Footing	Lav.	Lavatory	P.	Paint	Sht.	Sheet	Ur.	Urinal
Asb.	Asbestos	Ds.	Downspout	Furr.	Furring	Lkr.	Locker	Pi.	Plate	Sim.	Similar		
Asph.	Asphalt	Dwg.	Drawing	Fut.	Future	Lt.	Light	P.Lam.	Plastic Laminate	S.N.D.	Sanitary Napkin Disp.	V.C.T.	Vinyl Composition Tile
A.V.	Audio Visual	Dwr.	Drawer	Ga.	Gauge	Mas.	Masonry	Plas.	Plaster	S.N.R..	Sanitary Napkin Recep.	V.T.	Vinyl Tile
Bd.	Board	(E)	Existing	Galv.	Galvanized	Mech.	Mechanical	Plywd.	Plywood	Spec.	Specification	V.B.	Vapor Barrier
Bitum.	Bituminous	E.	East or Existing	G.B.	Grab Bar	Memb.	Membrane	Pr.	Pair	Sq.	Square	Vert.	Vertical
Bldg.	Building	Ea.	Each	Gl.	Glass	Met.	Metal	Pt.	Point	SSt.	Stainless Steel	Vest.	Vestibule
Blk.	Block	E.J.	Expansion Joint	Gnd.	Ground	Mfr.	Manufacturer	P.T.D.	Paper Towel Dispenser	Std.	Standard	Vyl.	Vinyl
Blk.g.	Blocking	El.	Elevation	Gr.	Grade	Mh.	Manhole	Ptn.	Partition	Stl.	Steel		
Bm.	Beam	Elec.	Electrical	Gyp.	Gypsum	Min.	Minimum	P.T.R.	Paper Towel Receptacle	Stor.	Storage	W.	West
Bot.	Bottom	Elev.	Elevator	H.B.	Hose Bibb	Mir.	Mirror	Q.T.	Quarry Tile	Strl.	Structural	w/	With
BO	BY OWNER	Eq.	Equal	H.C.	Hollow Core	Misc.	Miscellaneous	S.V.	Sheet Vinyl	Susp.	Suspended	w/o	Without
Brg.	Bearing	Equip.	Equipment	Hdwd.	Hardwood	M.O.	Masonry Opening	Sym.	Symmetrical	W.C.	Wall Covering		
Brk.	Brick	E.W.	Each Way	Hdwr.	Hardware	Mtd.	Mounted	R.	Riser	Wd.	Wood	Wp.	Waterproof
Cab.	Cabinet	E.W.C.	Elec. Water Cooler	H.M.	Hollow Metal	Misc.	Miscellaneous	Rad.	Radius	Wdw.	Window	Wsct.	Wainscot
Clg.	Ceiling	Exist.	Existing	Horiz.	Horizontal	M.O.	Masonry Opening	R.D.	Roof Drain	T.Bd.	Tack Board	Wt.	Weight
		Expo.	Exposed					Ref.	Reference				

# **SHEET INDEX**

GENERAL

---

**COVER & SHEET INDEX**

---

## ARCHITECTURAL

---

- A1.0 ARCHITECTURAL NOTES AND SPECIFICATIONS
- A1.1 ARCHITECTURAL NOTES AND SPECIFICATIONS (CONT.)
- A2.0 PLAN LEGENDS
- A2.1 FLOOR PLANS
- A2.2 PENTHOUSE FLOOR PLANS
- A2.3 PHOTOS

STRUCTURAL

## STRUCTURE

### S1.0 STRUCTURAL DETAILS AND PLANS

## MECHANICAL/ELECTRICAL

---

- E0.1 ELECTRICAL SPECIFICATIONS
- E1.1 ELECTRICAL PLANS
- E6.1 ELECTRICAL DIAGRAMS AND DETAILS
- E6.2 PANEL SCHEDULES
- P1.1 PARTIAL PLUMBING PLAN AND DETAILS

# JGR

730 N. Ninth St. 1881 Main Street, Suite 301  
Salina, KS 67401 Kansas City, MO 64108  
785.827.0386 [iar@iararchitects.com](mailto:iar@iararchitects.com)

## CONSULTANTS

Mechanical & Electrical Engineer ;



LST Consulting Engineers, PA

**EST Consulting Engineers,**  
4809 Vue Du Lac Place, Suite 301  
Manhattan, KS 66503  
785.587.8042; FAX 785.587.8039  
[mail@ESTengineers.com](mailto:mail@ESTengineers.com)

## Structural Engineer ;




# CONSULTANTS

# Engineering Consultants

# BUILDING PERMIT SET (8-5-2025)



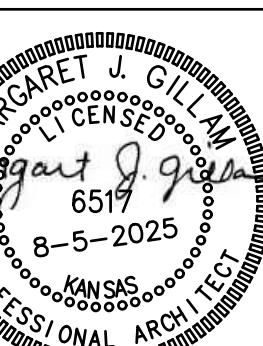

REVISION:

8-14-2025

DATE: 8-5-2025  
JOB: 25-3499

SHEET NO.:

A1.1

## COLD-FORMED METAL FRAMING

### PART 1 - GENERAL

#### 1.1 SUMMARY

- A. This Section includes the following:
  - 1. Interior non-load-bearing wall framing
  - 2. Ceiling joist framing.

#### 1.2 PERFORMANCE REQUIREMENTS

- B. Structural Performance: Provide cold-formed metal framing capable of withstanding design loads within limits and under conditions indicated.
- 3. Design framing system to maintain clearances at openings, to allow for construction tolerances, and to accommodate live load deflection of primary building structure as follows:
  - a. Use standard non-load-bearing wall framing of 1 inch.
- C. Cold-Formed Steel Framing: General: Design according to AISI's "Standard for Cold-Formed Steel Framing - General Provisions".
- 4. Headers: Design according to AISI's "Standard for Cold-Formed Steel Framing - Header Design".
- 5. Design exterior non-load-bearing wall framing to accommodate horizontal deflection without regard for contribution of sheathing materials.

#### 1.3 QUALITY ASSURANCE

- A. Welding: Qualify procedures and personnel according to AWS D1.1/D1.1M, "Structural Welding Code - Steel," and AWS D1.3, "Structural Welding Code - Sheet Steel."
- B. Fire-Test-Response Characteristics: Where indicated, provide cold-formed metal framing identical to that of assemblies tested for fire resistance per ASTM E 119 by a testing and inspecting agency acceptable to authorities having jurisdiction.
- C. AISI Specifications and Standards: Comply with AISI's "North American Specification for the Design of Cold-Formed Steel Structural Members" and its "Standard for Cold-Formed Steel Framing - General Provisions."
- 1.4 DELIVERY, STORAGE, AND HANDLING
- A. Protect cold-formed metal framing from corrosion, deformation, and other damage during delivery, storage, and handling.
- B. Store cold-formed metal framing, protect with a waterproof covering, and ventilate to avoid condensation.
- PART 2 - PRODUCTS
- 2.1 MANUFACTURERS
- C. Available Manufacturers: Subject to compliance with requirements, manufacturers offering cold-formed metal framing that may be incorporated into the Work include, but are not limited to, the following:
- D. Manufacturers: Subject to compliance with requirements, provide cold-formed metal framing by one of the following:
  - 1. Allied Studco, AllSteel Products, Inc., California Expanded Metal Products Company, Clark Steel Frame, Custom Stud, Inc., Flexo, Inc., Building Products, Inc., Goss Metal Products, Inc., Custom Stud, Inc., Date/Incor., Design Shapes in Steel, District Metal Framing, a Worthington Industries Company, Formetal Co. Inc. (The), Innovative Steel Systems, MarinoWare, a division of Ware Industries, Quill Run Building Materials, Inc., SCAFCO Corporation, Southeastern Stud & Components, Inc., Steel Construction Systems, Steeler, Inc., Super Stud Building Products, Inc., United Metal Products, Inc.
- 2.2 MATERIALS
- E. Steel Sheet: ASTM A 1003/A 1003M, Structural Grade, Type H, metallic coated, of grade and coating weight as follows:
  - 6. Grade: 50 KSI.
  - 7. Coating: G60.
- F. Steel Sheet for Vertical Deflection Clips: ASTM A 653/A 653M, structural steel, zinc coated, of grade and coating as follows:
  - 25. Grade: 50 (340), Class 1 or 2.
  - 29. Coating: G60.
- 2.3 INTERIOR NON-LOAD-BEARING WALL FRAMING
- G. Steel Studs: Manufacturer's standard C-shaped steel studs, of web depths indicated, punched, with stiffened flanges, and as follows:
  - 30. Grade: 50 (340), 20 gauge, 30 mil.
  - 31. Flange Width: 1-5/8 inches (41 mm).
  - 32. Sizes: As indicated on drawings.
- B. Steel Track: Manufacturer's standard U-shaped steel track, of web depths indicated, unpunched, with stiffened flanges, and as follows:
  - 33. Minimum Base-Metal Thickness: Matching steel studs.
  - 34. Flange Width: 1-1/4 inches (32 mm).
- C. Vertical Deflection Clips: Manufacturer's standard bypass clips, capable of accommodating upward and downward vertical displacement of primary structure through positive mechanical attachment to stud web.
- 35. Available Manufacturers: Subject to compliance with requirements, manufacturers offering products that may be incorporated into the Work include, but are not limited to, the following:
- 36. Manufacturers: Subject to compliance with requirements, provide products by one of the following:
  - a. Dietrich Metal Framing: a Worthington Industries Company.
  - b. MarinoWare, a division of Ware Industries.
  - c. SCAFCO Corporation.
  - d. The Steel Network, Inc.
- D. Single Deflection Track: Manufacturer's single, deep-leg, U-shaped steel track; unpunched, with stiffened flanges, of web depth to contain studs while allowing free vertical movement, with flanges designed to support horizontal and lateral loads and transfer them to the primary structure, and as follows:
  - 37. Available Manufacturers: Subject to compliance with requirements, manufacturers offering products that may be incorporated into the Work include, but are not limited to, the following:
    - 38. Minimum Base-Metal Thickness: 0.0428 inch (1.09 mm).
    - 39. Flange Width: 2 1/2".
- 2.4 CEILING JOIST FRAMING
- E. Steel Ceiling Joists: Manufacturer's standard C-shaped steel sections, of web depths indicated, unpunched, with stiffened flanges, and as follows:
  - 40. Minimum Base-Metal Thickness: 0.0329 inch (0.84 mm).
  - 41. Flange Width: 1-5/8 inches (41 mm).
- 2.5 FRAMING ACCESSORIES
- F. Fabricate steel-framing accessories from steel sheet, ASTM A 1003/A 1003M, Structural Grade, Type H, metallic coated, of some grade and coating weight used for framing members.
- G. Provide accessories of manufacturer's standard thickness and configuration, unless otherwise indicated, as follows:
  - 1. Supplementary framing: Bracing, bridging, and solid blocking; Web stiffeners; Anchor clips; End clips; Foundation clips; Gusset plates; Stud kickers, knee braces, and girts; Joist hangers and end closures; Hole reinforcing plates; Backer plates.
- 2.6 ANCHORS, CLIPS, AND FASTENERS
- H. Steel Shapes and Clips: ASTM A 36/A 36M, zinc coated by hot-dip process according to ASTM A 123/A 123M.
- I. Anchor Bolts: ASTM F 1554-36 threaded carbon-steel hex-headed bolts, headless, hooked bolts and carbon-steel nuts; and flat, hardened-steel washers; zinc coated by mechanically deposition according to ASTM B 695, Class 50.
- J. Expansion Anchors: Fabricated from corrosion-resistant materials, with capability to sustain, without failure, a load equal to 5 times design load, as determined by testing per ASTM E 488 conducted by a qualified independent testing agency.
- K. Power-Actuated Anchors: Fastener system of type suitable for application indicated, fabricated from corrosion-resistant materials, with capability to sustain, without failure, a load equal to 10 times design load, as determined by testing per ASTM E 1190 conducted by a qualified independent testing agency.
- L. Mechanical Fasteners: ASTM C 1513, corrosion-resistant-coated, self-drilling, self-tapping steel drill screws.
- M. Head Type: Low-profile head beneath sheathing, manufacturer's standard elsewhere.
- N. Welding Electrodes: Comply with AWS standards.
- 2.7 MISCELLANEOUS MATERIALS
- O. Galvanizing Repair Paint: ASTM A 780.
- P. Cement Grout: Topbond cement, ASTM C 150, Type I; and clean, natural sand, ASTM C 404. Mix at ratio of 1 part cement to 2-1/2 parts sand, by volume, with minimum water required for placement and hydration.
- Q. Nonmetallic, Nonshrink Grout: Premixed, nonmetallic, noncorrosive, nonstaining grout containing selected silica sands, portland cement, and mitigating compressive agents, and plasticizing and water-reducing agents, complying with ASTM C 1107, with fluid consistency and 30-minute working time.
- R. Shims: Load bearing, high-density multimonomer plastic, nonleaching.
- S. Sealing Gaskets: Closed-cell neoprene foam, 1/4 inch (6.4 mm) thick, selected from manufacturer's standard widths to match width of bottom track or rim track members.
- 2.8 FABRICATION
- T. Fabricate cold-formed metal framing and accessories plumb, square, and true to line, and with connections securely fastened, according to referenced AISI's specifications and standards, manufacturer's written instructions, and requirements in this Section.
- U. Fabricate framing assemblies using jigs or templates.
- V. Cut framing members by sawing or shearing; do not torch cut.
- W. Fasten cold-formed metal framing members by welding, screw fastening, clinch fastening, or riveting as standard or as required. Welding of framing members is not permitted:
  - a. Comply with AWS D1.3 requirements and procedures for welding, appearance and quality of welds, and methods used in correcting welding work.
  - b. Locate mechanical fasteners and install according to Shop Drawings, with screw penetrating joined members by not less than three exposed screw threads.
- B. Fasten other materials to cold-formed metal framing by welding, bolting, or screw fastening, according to Shop Drawings.

## METAL FABRICATIONS

### PART 1 GENERAL

#### 1.01 SUMMARY

- A. Section Includes: Rough Hardware, Loose Bearing and Leveling Plates, Loose Steel Lintels, Ladders: Elevator Pit Ladder, Support Angles for Elevator Door Sills, Elevator Sump Pit Cover, Miscellaneous Metal Trim, Steel Framing and Supports for Applications where framing and supports are not specified in this Section.

#### 1.02 QUALITY ASSURANCE

- A. Fabricator Qualifications: Firm experienced in successfully producing metal fabrications similar to that indicated for this Project, with sufficient production capacity to produce required units without causing delay in the Work.
- B. Installation: Arrange for installation of metal fabrications specified in this Section by same firm that fabricated them.
- C. Quality welding processes and welding operators in accordance with the following: AWS D1.1 "Structural Welding Code - Steel", D1.3 "Structural Welding Code - Sheet Steel", D1.2 "Structural Welding Code - Aluminum".
- D. Certify that each welder has satisfactorily passed AWS qualification tests for welding processes involved in the fabrication of metal fabrications.

#### 1.03 PROJECT/SITE CONDITIONS

- A. Field Measurements: Check actual locations of walls and other construction to which metal fabrications must fit, by accurate field measurements before fabrication; show recorded measurements on final shop drawings. Coordinate fabrication schedule with construction progress to avoid delay of Work.

#### 1.04 COORDINATION

- A. Coordinate installation of anchorages for metal fabrications. Furnish setting drawings, templates, and directions for installing anchorages, including sleeves, concrete inserts, anchor bolts, and items with integral anchors, that are to be embedded in concrete or masonry. Deliver such items to Project site in time for installation.

#### PART 2 PRODUCTS

##### 10.2 FERROUS METALS

- A. Metal Classes, General: For metal fabrications exposed to view upon completion of the Work, provide materials selected for their surface finish, smoothness, and freedom from surface blemishes. Do not use materials whose exposed surfaces exhibit pitting, seam marks, roller marks, rolled trade names, roughness, and, for steel sheet, variations in flatness exceeding those permitted by reference standards for stretcher-leveled sheet.

##### B. Steel Plates, Shapes, and Bars: ASTM A 36

- C. Steel Plates, Shapes, and Bars: ASTM A 36
- 1. Black finish, unless otherwise indicated.
- 2. Galvanized finish for exterior installations, unless shown to receive special coatings.

##### D. Carbon Iron Castings: ASTM A 48, Class 30

- E. Malleable Iron Castings: ASTM A 47, Grade 32510
- F. Brackets, Flanges and Anchors: Cast or formed metal of the same type material and finish as supported rails, unless otherwise indicated.
- G. Carbon Iron: Castings: ASTM A 47, Grade 32510
- H. Welding Rods: Select in accordance with AWS Specifications for the metal alloy to be welded.

#### 2.02 FASTENERS

- A. General: Provide zinc-coated fasteners for exterior use or where built into exterior walls. Select fasteners for the type, grade, and class required for each application and complying with applicable standards.

##### 1. Bolts and Nuts: Regular hexagon head bolts, ASTM A-307, Grade A with hex nuts ASTM A 563; Grade 50 KSI, unless otherwise indicated.

##### 2. Anchor Bolts: ASTM F 1554, Grade 30

##### 3. Lock Bolts: Square head type, ASME B18.21

##### 4. Machine Screws: Cuphead head, carbon steel, ASME B18.6.3

##### 5. Wood Screws: Flat head, carbon steel, ASME B18.6.1

##### 6. Phillips Head Screws: Flat head, carbon steel, ASME B18.2.1

##### 7. Lock Washers: Helical spring type, carbon steel, ASME B18.21

- 8. Expansion Anchors: Anchor bolt and sleeve assembly of material indicated below with capability to sustain, without failure, a load equal to six times the load imposed when installed in unit masonry and equal to four times the load imposed when installed in concrete, as determined by testing per ASTM E 488 conducted by a qualified independent testing agency.
- 9. Space joist Anchors: Install cold-formed metal framing level, plumb, and true to line with a maximum allowable tolerance variation of 1/8 inch in 10 feet (1:960) and as follows:
  - a. Space individual framing members no more than plus or minus 1/8 inch (3 mm) from plan location. Cumulative error shall not exceed minimum fastening requirements of sheathing or other finish materials.

#### 3.4 EXTERIOR NON-LOAD-BEARING WALL INSTALLATION

##### K. Install continuous tracks to match studs. Align tracks accurately and securely anchor to supporting structure as indicated.

##### L. Fasten both flanges of studs to bottom track, unless otherwise indicated. Space studs as follows:

##### M. Set stud plumb, except as needed for diagonal bracing or required for nonplumb walls or warped surfaces and similar requirements.

##### N. Isolate non-load-bearing steel framing from building structure to prevent transfer of vertical loads while providing lateral support.

##### O. Install single-leg deflection tracks and anchor to building structure.

##### P. Install double-leg deflection tracks and anchor outer track to building structure.

##### Q. Connect vertical deflection clips to infill studs and anchor to building structure.

##### R. Install horizontal bridging in wall studs, spaced in rows indicated on Shop Drawings but not more than 48 inches (1200 mm) apart. Fasten at each stud intersection.

##### S. Top Bridging for Single Deflection Track: Install row of horizontal bridging within 12 inches (305 mm) of single deflection track. Install a combination of flat, flat, and steel sheet strips of width and thickness equal to or greater than the width of the track solid blocking of width and thickness matching studs. For flat sheet strips, solid blocking of width and thickness matching studs.

##### T. Solid blocking: Install solid blocking to stud webs or flanges.

##### U. Bridging: Cold-rolled steel channel, welded or mechanically fastened to webs of punched studs.

##### V. Bridging: Combination of flat, flat, steel sheet strips of width and thickness indicated and solid blocking of width and thickness to match studs. Fasten flat strips to stud flanges and secure solid blocking to web of punched studs.

##### W. Bridging: Proprietary bridging bars installed according to manufacturer's written instructions.

##### X. Install miscellaneous framing and connections, including stud kickers, web stiffeners, clip angles, continuous angles, anchors, fasteners, and stud girts, to provide a complete and stable wall-framing system.

##### Y. JOIST INSTALLATION

##### Z. Install perimeter joist track sized to match joists. Align and securely anchor or fasten track to supporting structure of corners, ends, and spacings indicated on Shop Drawings.

##### A. Install joists bearing on supporting floor, level, straight, and plumb; adjust to final position, brace, and reinforce. Fasten joists to both flanges of joist track.

##### B. Install joists over supporting floor with a minimum end bearing of 1-1/2 inches (38 mm).

##### C. Reinforce ends and bearing points of joists with web stiffeners, end clips, joist hangers, steel clip angles, or steel stud sections as indicated on Shop Drawings.

##### D. Space joists not more than 2 inches (51 mm) from abutting walls, and as follows:

##### E. Joist Spacing: As indicated.

##### F. Frame openings with built-up joist headers consisting of joist and joist track, nesting joists, or another combination of connected joists, if indicated.

##### G. Multi-joist reinforcement at interior supports with single, short length of joist section located directly over interior support, with tapped joists of equal length to joist reinforcement, or as indicated on Shop Drawings.

##### H. Install bridging at intervals indicated on Shop Drawings. Fasten bridging at each joist intersection as follows:

##### I. Bridging: Joist track solid blocking of width and thickness indicated, secured to joist webs.

##### J. Bridging: Combination of flat, flat, steel sheet strips of width and thickness indicated and joist-track solid blocking of width and thickness indicated. Fasten flat strips to bottom flange of joists and secure solid blocking to joist webs.

##### K. Secure joists to load-bearing interior walls to prevent lateral movement of bottom flange.

##### L. Install miscellaneous joist framing and connections, including web stiffeners, closure pieces, clip angles, continuous angles, hold-down angles, anchors, and fasteners, to provide a complete and stable joist-framing assembly.

##### M. FIELD QUALITY CONTROL

##### I. Testing: Owner will engage a qualified independent testing and inspecting agency to perform field tests and inspections and prepare test reports.

##### J. Field and shop welds will be subject to testing and inspecting.

##### K. Testing agency will report test results promptly and in writing to Contractor and Architect.

##### L. Remove and replace work where test results indicate that it does not comply with specified requirements.

##### M. Additional testing and inspecting, at Contractor's expense, will be performed to determine compliance of replaced or additional work with specified requirements.

##### N. Galvanizing Repairs: Prepare and repair damaged galvanized coatings on fabricated and installed cold-formed metal framing with galvanized repair paint according to ASTM A 780 and manufacturer's written instructions.

##### O. Provide cold-formed metal framing and connections, in a manner acceptable to manufacturer and installer, that ensure that cold-formed metal framing is without damage or deterioration at time of Substantial Completion.




REVISION:  
8-14-2025

DATE: 8-5-2025  
JOB: 25-3499  
SHEET NO.:

COPYRIGHTED ©

A2.0

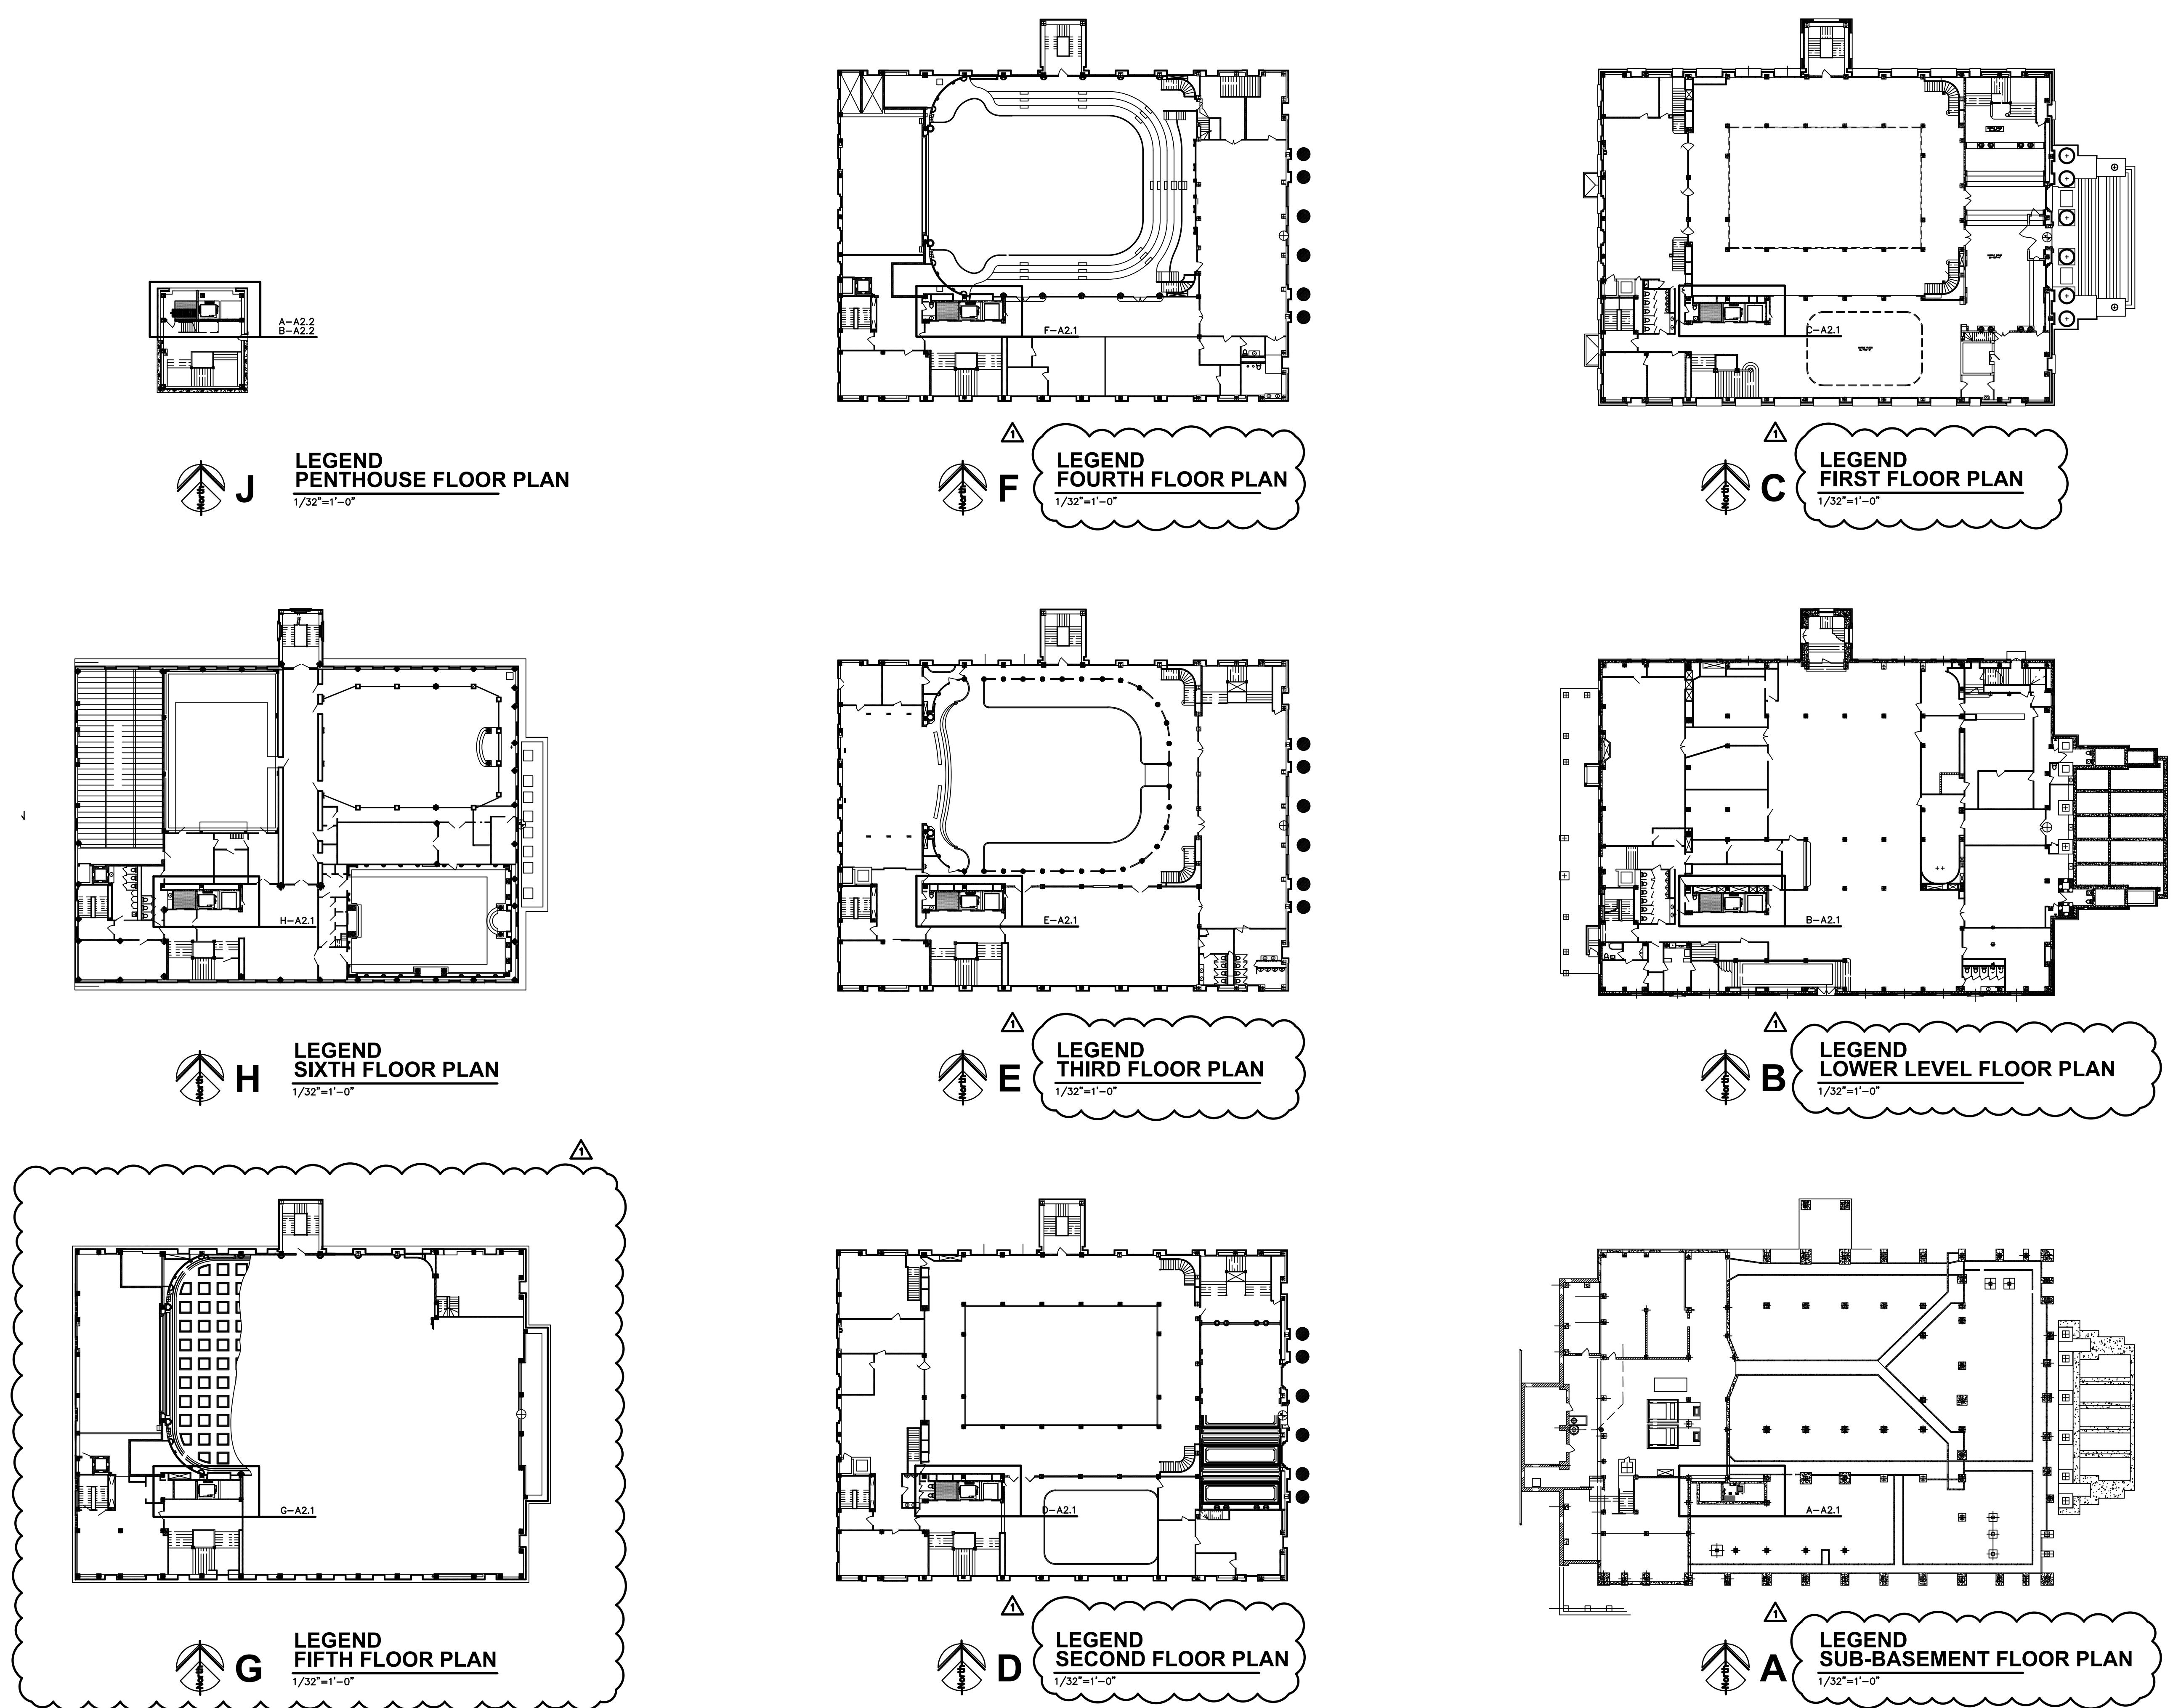



REVISION: 8-14-2025

DATE: 8-5-2025  
JOB: 25-3499  
SHEET NO.:

COPYRIGHTED ©

A2.1

## GENERAL CONSTRUCTION NOTES



1. CONTRACTOR SHALL OBTAIN ALL NECESSARY PERMITS BEFORE WORK BEGINS
2. CONTRACTOR(S) SHALL CONDUCT A SITE WALKTHROUGH AND CONFIRM EXISTING CONDITIONS AND FIELD VERIFY DIMENSIONS
3. INSTALL MATERIALS AND/OR FINISHES AS INDICATED, IMPLIED OR AS REQUIRED FOR COMPLETE & FINISHED INSTALLATION.
4. ALL WORK SHALL BE IN CONFORMANCE W/ APPLICABLE BUILDING CODES & ORDINANCES.
5. ALL NEW CONSTRUCTION SHALL BE IN CONFORMANCE TO ADA REQUIREMENTS. REFERENCE ADA FOR
6. IF THERE IS A DISCREPANCY BETWEEN DRAWINGS AND FIELD CONDITIONS NOTIFY ARCHITECT PRIOR TO PROCEEDING WITH WORK SO THAT ANY ISSUES MAY BE CLARIFIED.
7. CONTRACTOR TO VERIFY THAT ALL CONSTRUCTION MATERIALS WILL MEET US EPA CRITERIA PARTICULARLY MATERIALS THAT WILL BE OBTAINED FROM INTERNATIONAL SOURCES. ALSO VERIFY THAT THE CONSTRUCTION MATERIALS MEET THE REQUIREMENTS OF THE DUST AND DUST CONTROL PLAN.
8. CONTRACTOR SHALL PROTECT ALL ADJACENT AREAS NOT IN THE SCOPE OF WORK FROM DUST AND DAMAGE. CONTRACTOR SHALL ALSO PROTECT STRUCTURAL ELEMENTS AND UTILITIES TO REMAIN.
9. CONTRACTOR SHALL REMOVE DEBRIS REGULARLY TO MAINTAIN A SAFE AND CLEAN JOB SITE.
10. CONTRACTOR SHALL FOLLOW ALL STRUCTURAL, ARCHITECTURAL AND MEP DETAILS, DO NOT MODIFY
11. CONTRACTOR SHALL COORDINATE LAYOUT AND ROUTING OF ANY EXISTING AND NEW MEP ELEMENTS.
12. ALL PENETRATIONS THROUGH FIRE-RATED ASSEMBLIES MUST BE SEALED AND COMPLIANT.
13. FOR PROJECT CLOSE OUT IT IS CONTRACTOR'S RESPONSIBILITY TO COORDINATE ALL REQUIRED INSPECTIONS ARE PASSED (BUILDING, MECHANICAL, PLUMBING, ETC.).
14. CONTRACTOR SHALL ALLOW OWNER TO PERFORM A PUNCH LIST AND INSPECTION WALKTHROUGH AND ADDRESS ALL PUNCH ITEMS IN A TIMELY AND PROFESSIONAL MANNER.
15. CONTRACTOR TO PROVIDE WARRANTIES, MANUALS AND AS BUILT DOCUMENTATION WHERE APPLICABLE TO THE OWNER.
16. CONTRACTOR WILL BE RESPONSIBLE FOR CONTACTING THE STATE FIRE MARSHAL AND MAKE SURE THE ELEVATOR IS PROPERLY REGISTERED AND MEETS ALL STATE ELEVATOR CODES.

## HISTORIC PRESERVATION NOTES


1. IT IS THE OWNERS RESPONSIBILITY TO COORDINATE ALL WORK AND OBTAIN ANY APPROVALS AS REQUIRED BY THE KANSAS STATE HISTORIC PRESERVATION OFFICE.
2. CONTRACTOR SHALL COORDINATE WITH OWNER AND THE KANSAS STATE HISTORIC PRESERVATION OFFICE ON ANY ADDITIONAL WORK OR REQUIREMENTS FOR HISTORIC PRESERVATION.
3. OWNER SHALL NOT DAMAGE ANY EXISTING MARBLE OR CHARACTER-DEFINING FEATURES & MOLDING. CONTRACTOR TO PROTECT DURING CONSTRUCTION WHERE PENETRATIONS NEED TO BE MADE AT THE ADJACENT ELEVATOR SHAFT WALLS FOR NEW SIGNALS. HOLES SHALL BE KEPT HAS MINIMAL AS POSSIBLE AND ANY EXPOSED CONDUITS SHALL BE KEPT AT A MINIMUM.
4. ANY EXISTING BRICK/STONE TO BE REMOVED SHOULD BE SALVAGED FOR REUSE.
5. ELECTRICAL CONDUIT SHALL RUN ABOVE CEILINGS AND WITHIN WALLS. ANY EXPOSED CONDUIT SHALL BE PAINTED TO MATCH ADJACENT SURFACES.

ASSOCIATED PRESERVATION BRIEFS INCLUDE  
(<https://www.nps.gov/orgs/1739/preservation-briefs.htm>):  
• 17. ARCHITECTURAL CHARACTER - IDENTIFYING THE VISUAL ASPECTS OF HISTORIC BUILDINGS AS AN AID TO PRESERVING THEIR CHARACTER  
• 21. REPAIRING HISTORIC FLAT PLASTER - WALLS AND CEILINGS  
• 23. PRESERVING HISTORIC ORNAMENTAL PLASTER


## FIRE WALL SCHEDULE

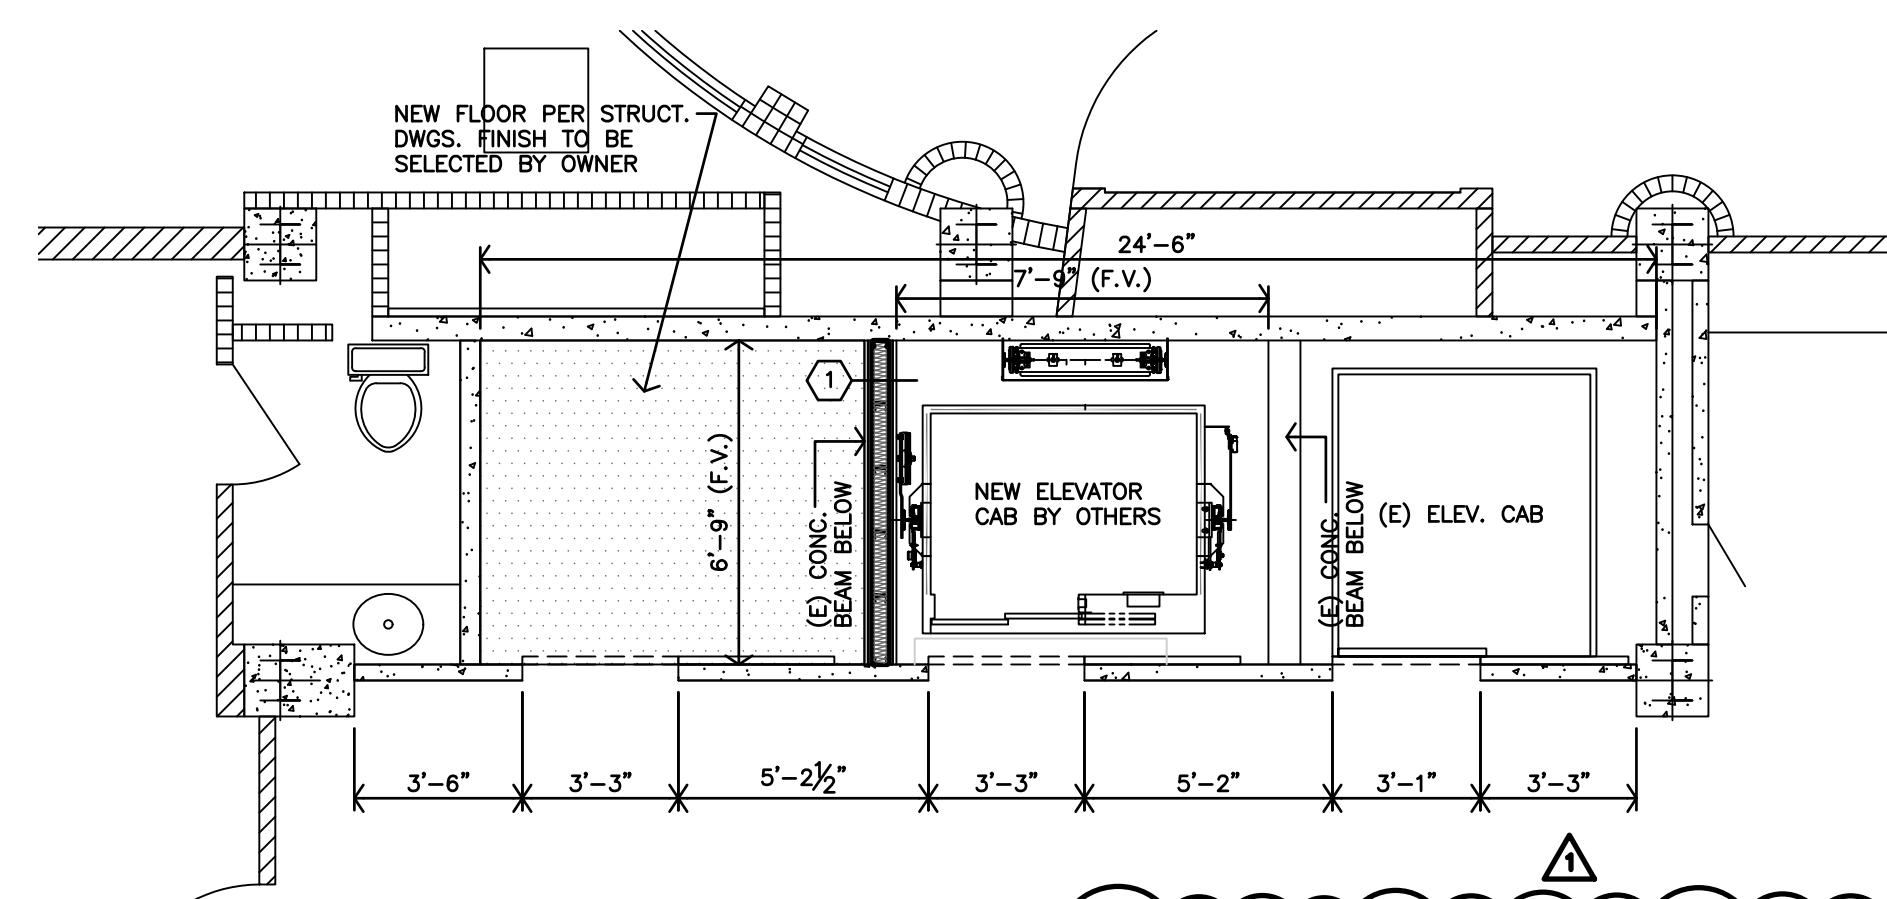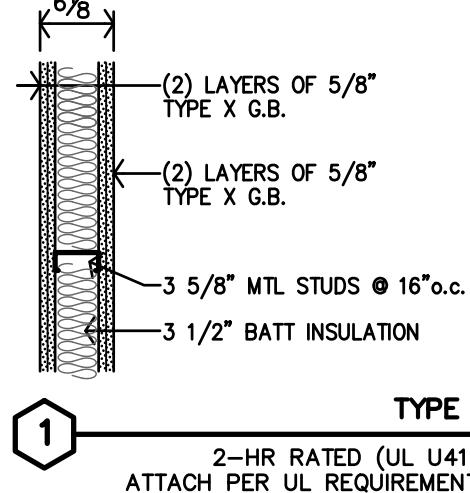


F FOURTH (AUDITORIUM BALCONY)  
FLOOR PLAN  
1/4"=1'-0"

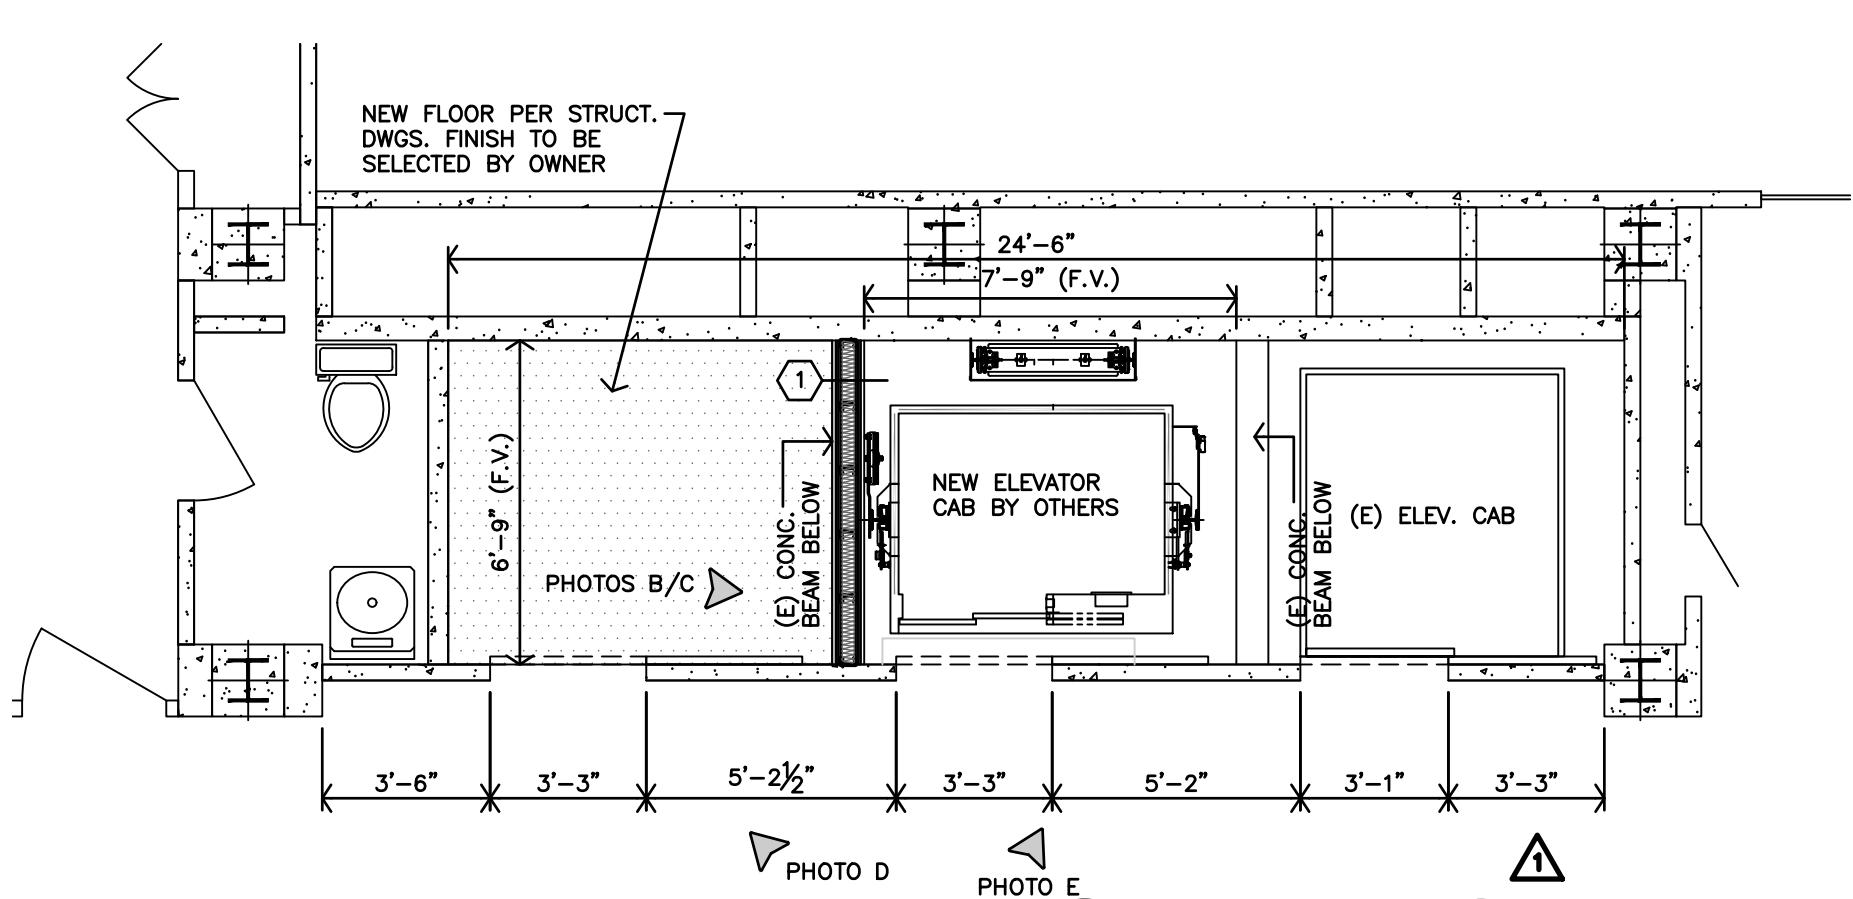


C FIRST (BALLROOM)  
FLOOR PLAN  
1/4"=1'-0"

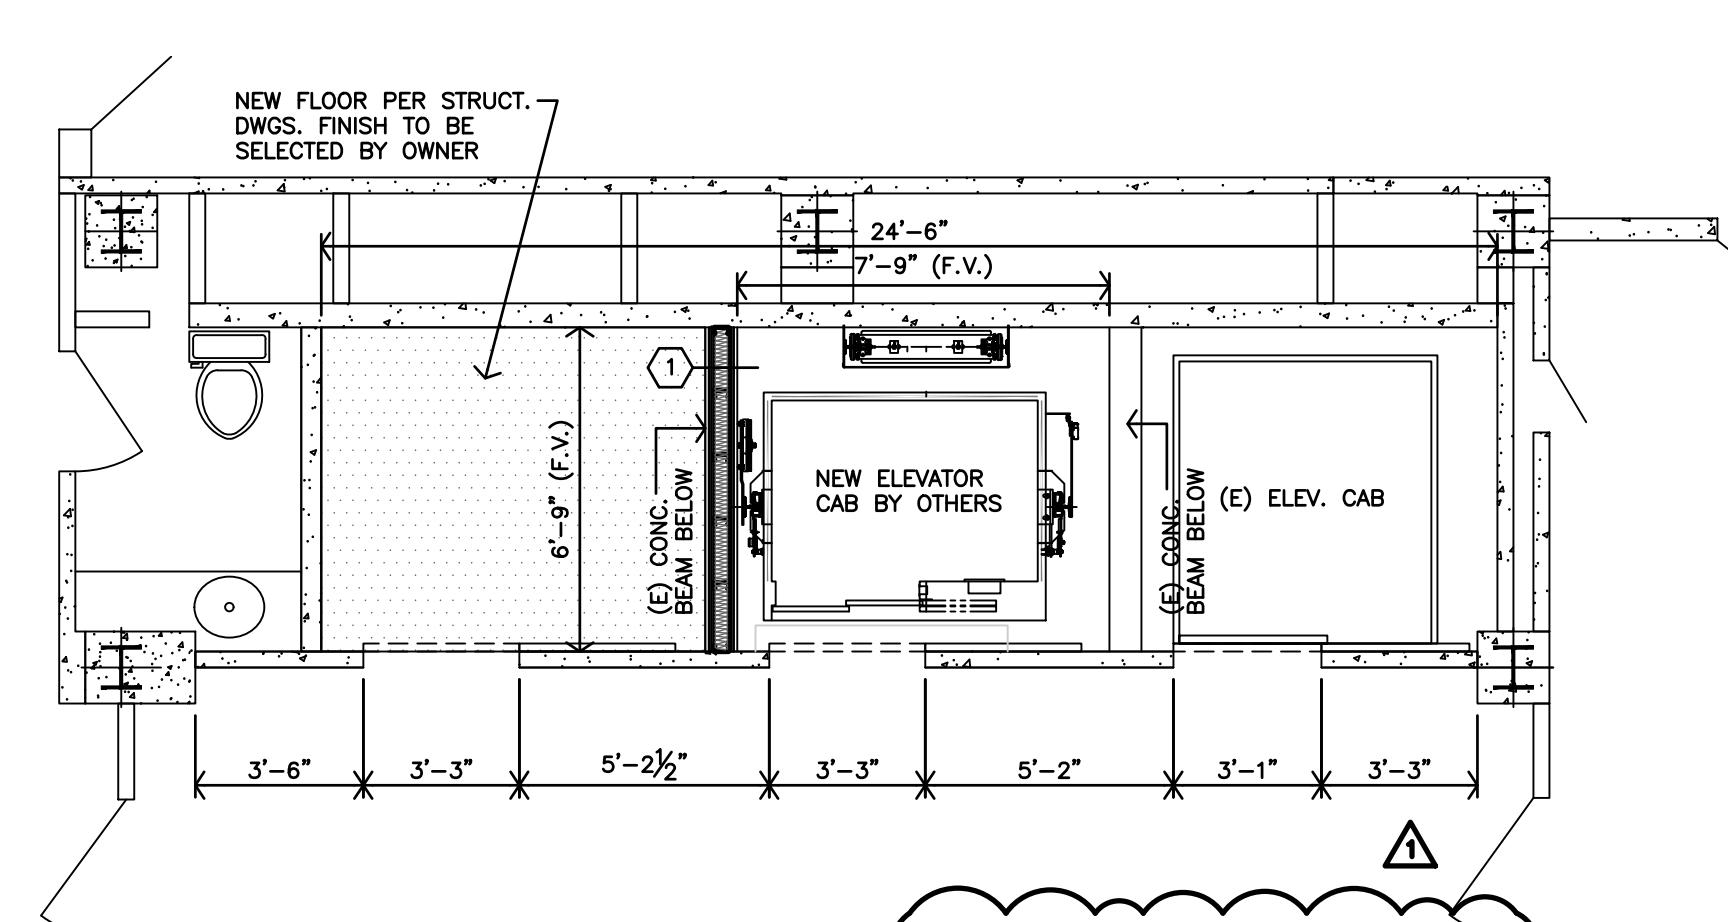


E SIXTH (MASONIC)  
FLOOR PLAN  
1/4"=1'-0"

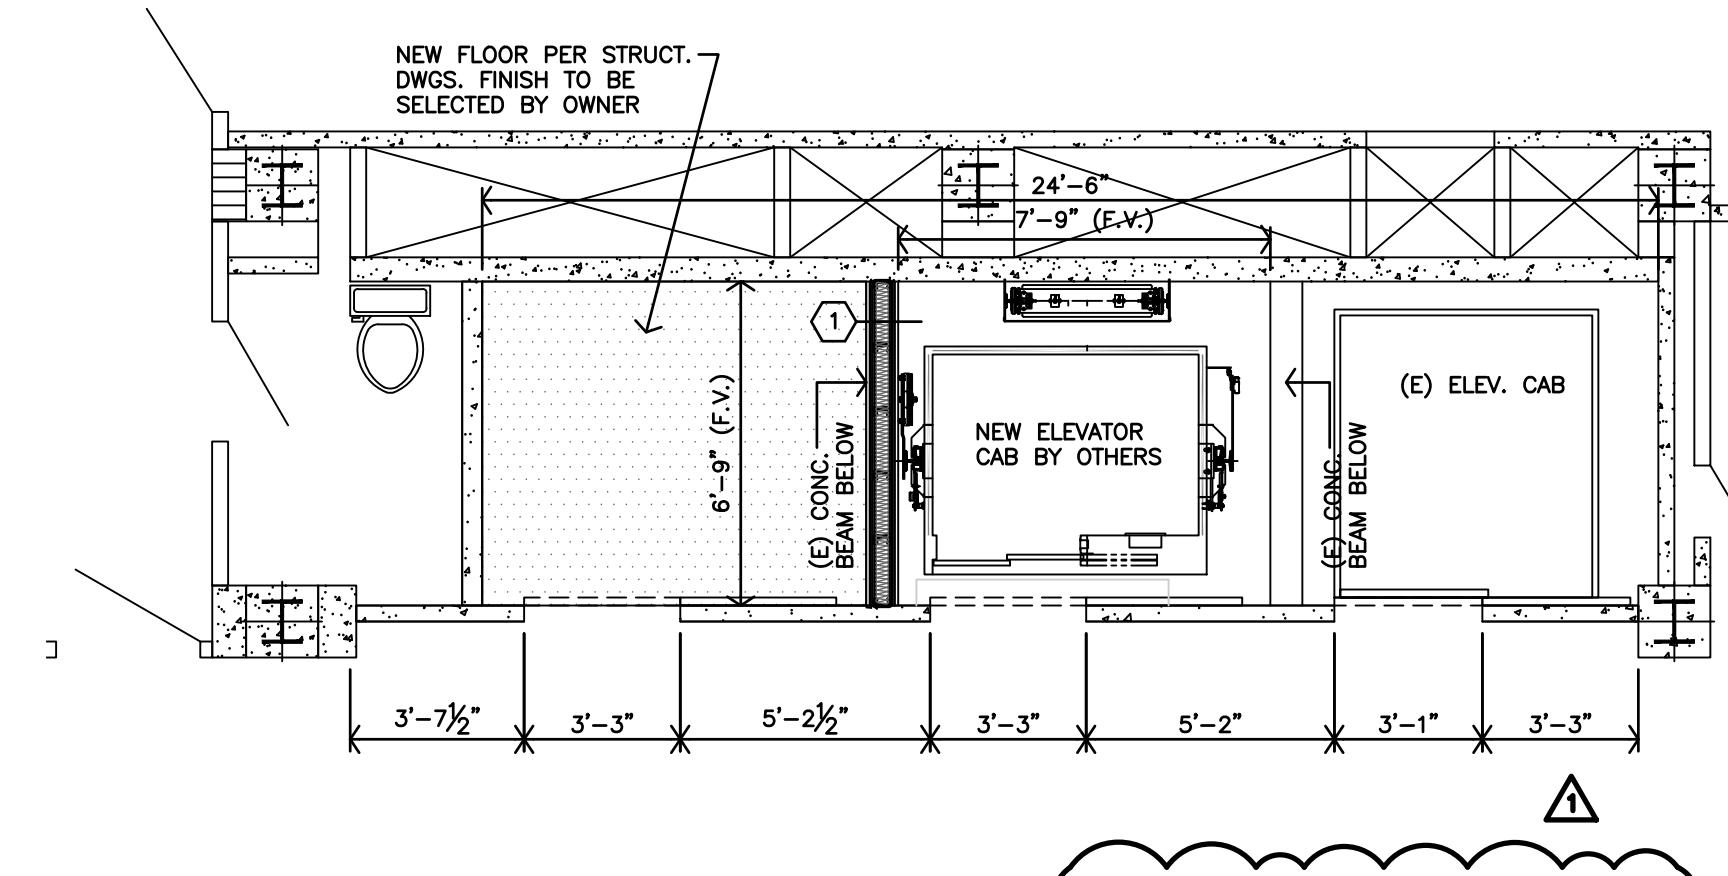


B THIRD (AUDITORIUM)  
FLOOR PLAN  
1/4"=1'-0"

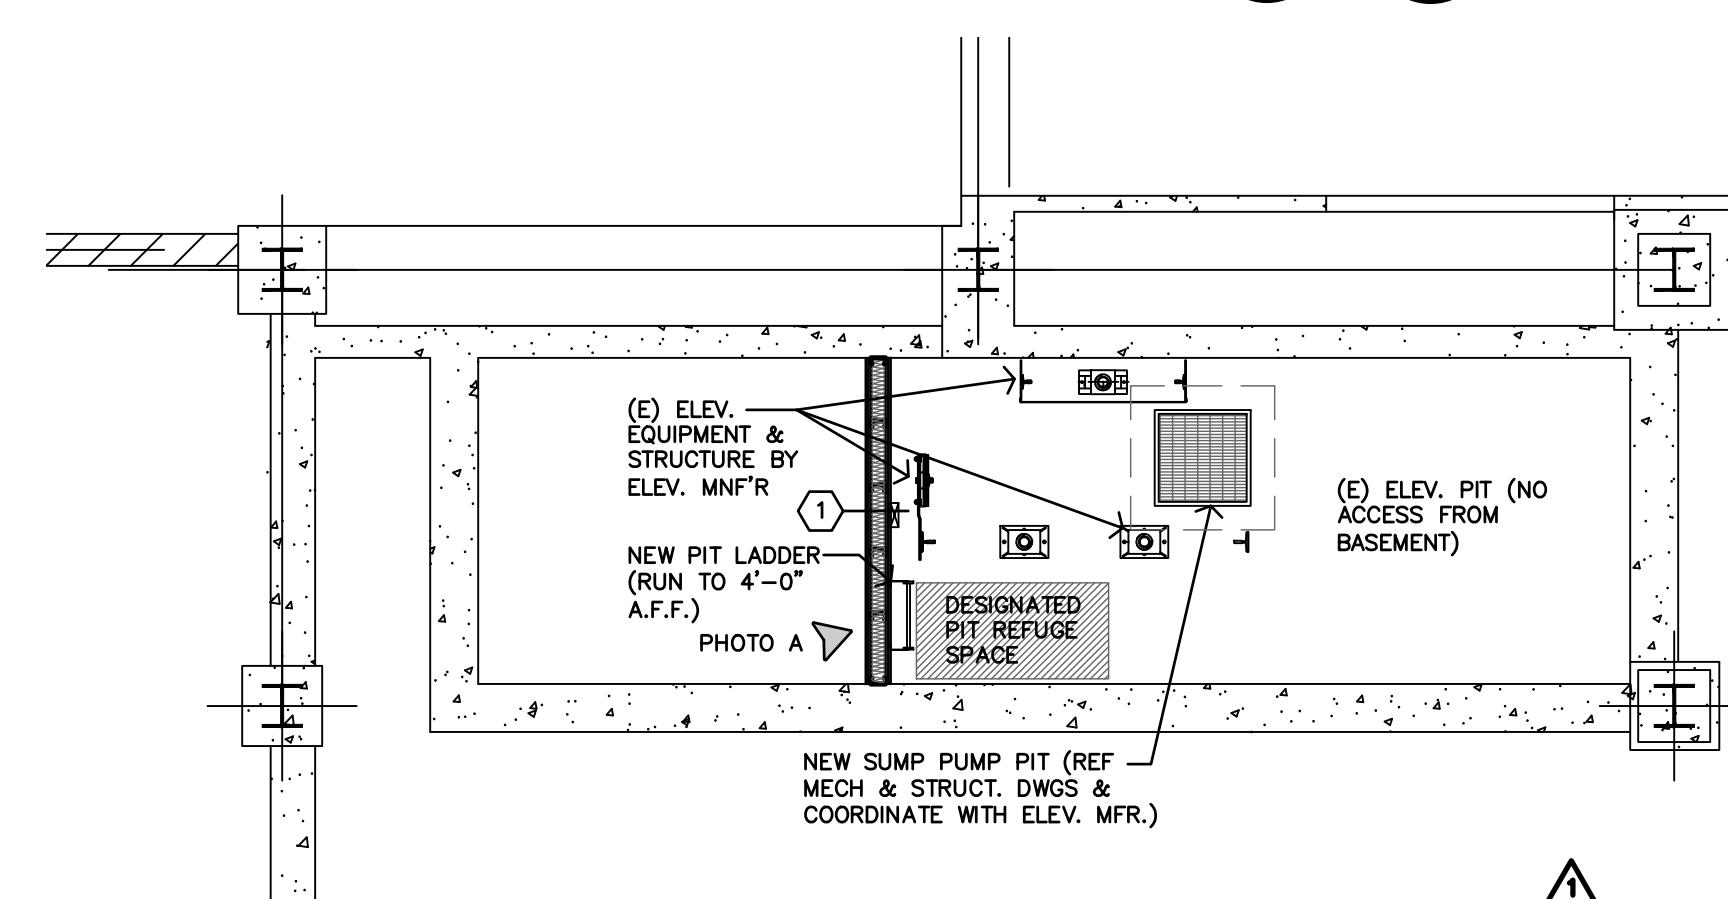

A LOWER LEVEL  
FLOOR PLAN  
1/4"=1'-0"

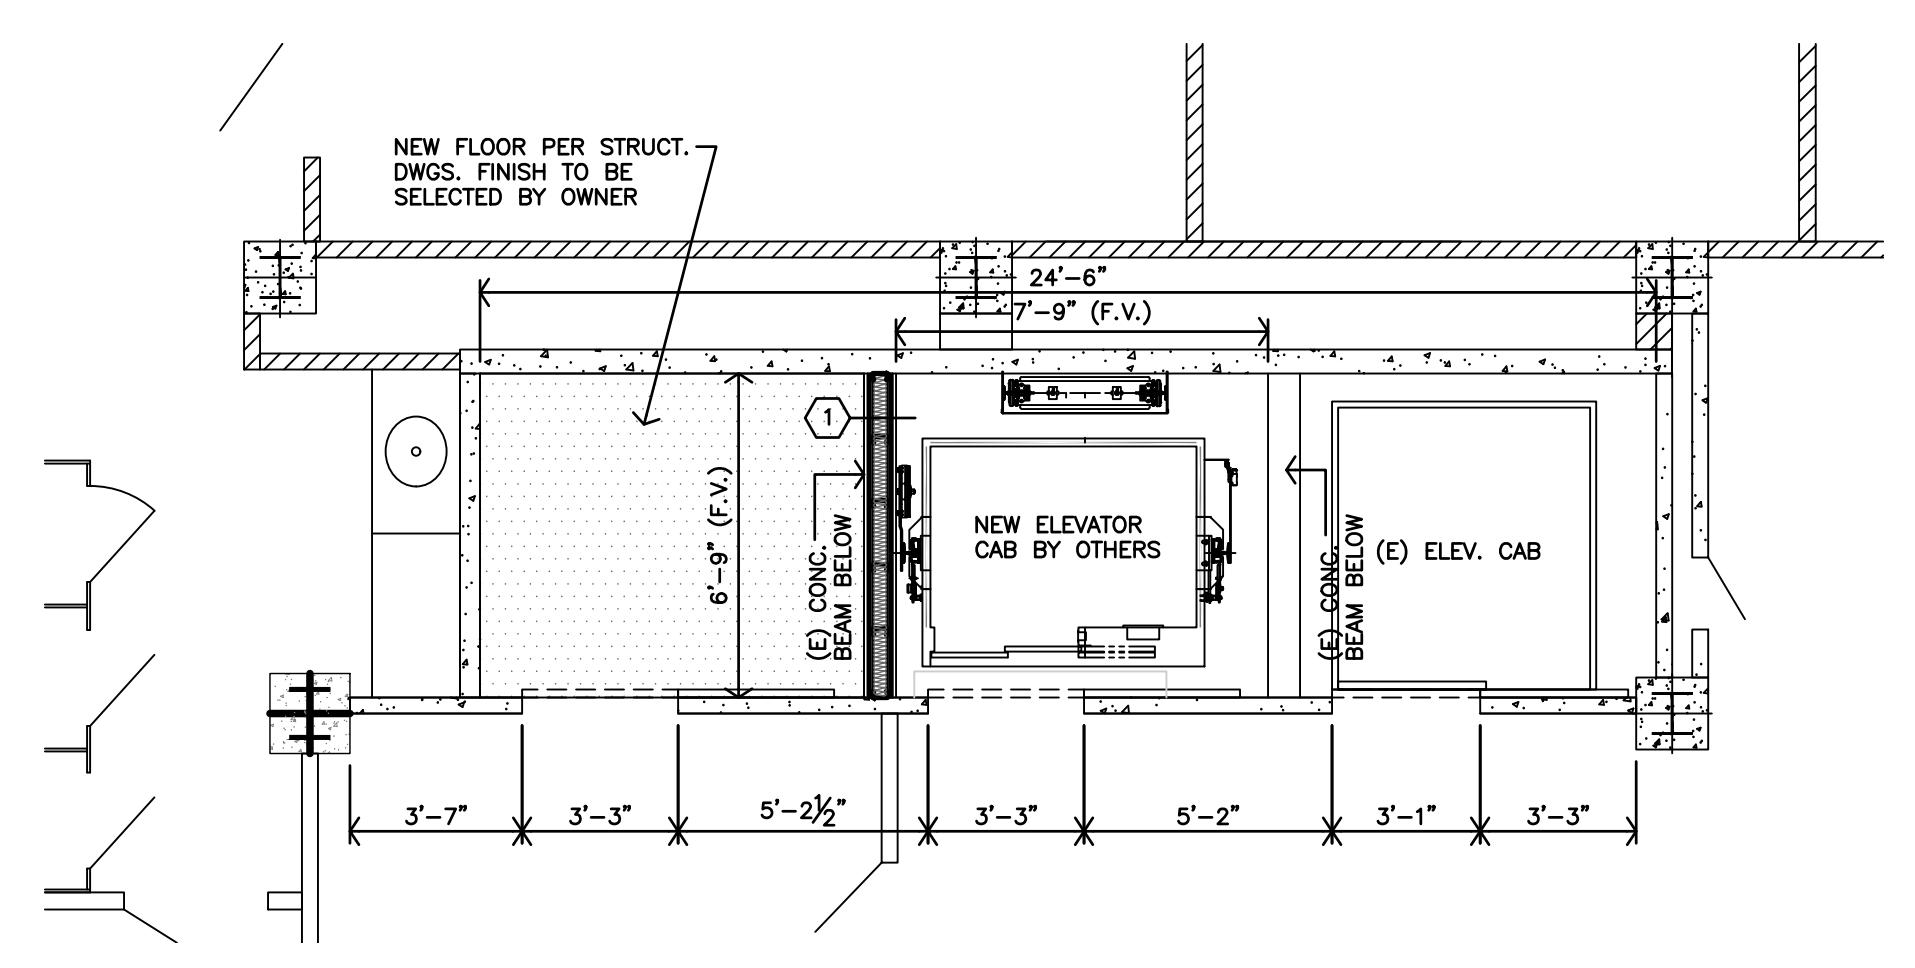

H FIFTH  
FLOOR PLAN  
1/4"=1'-0"

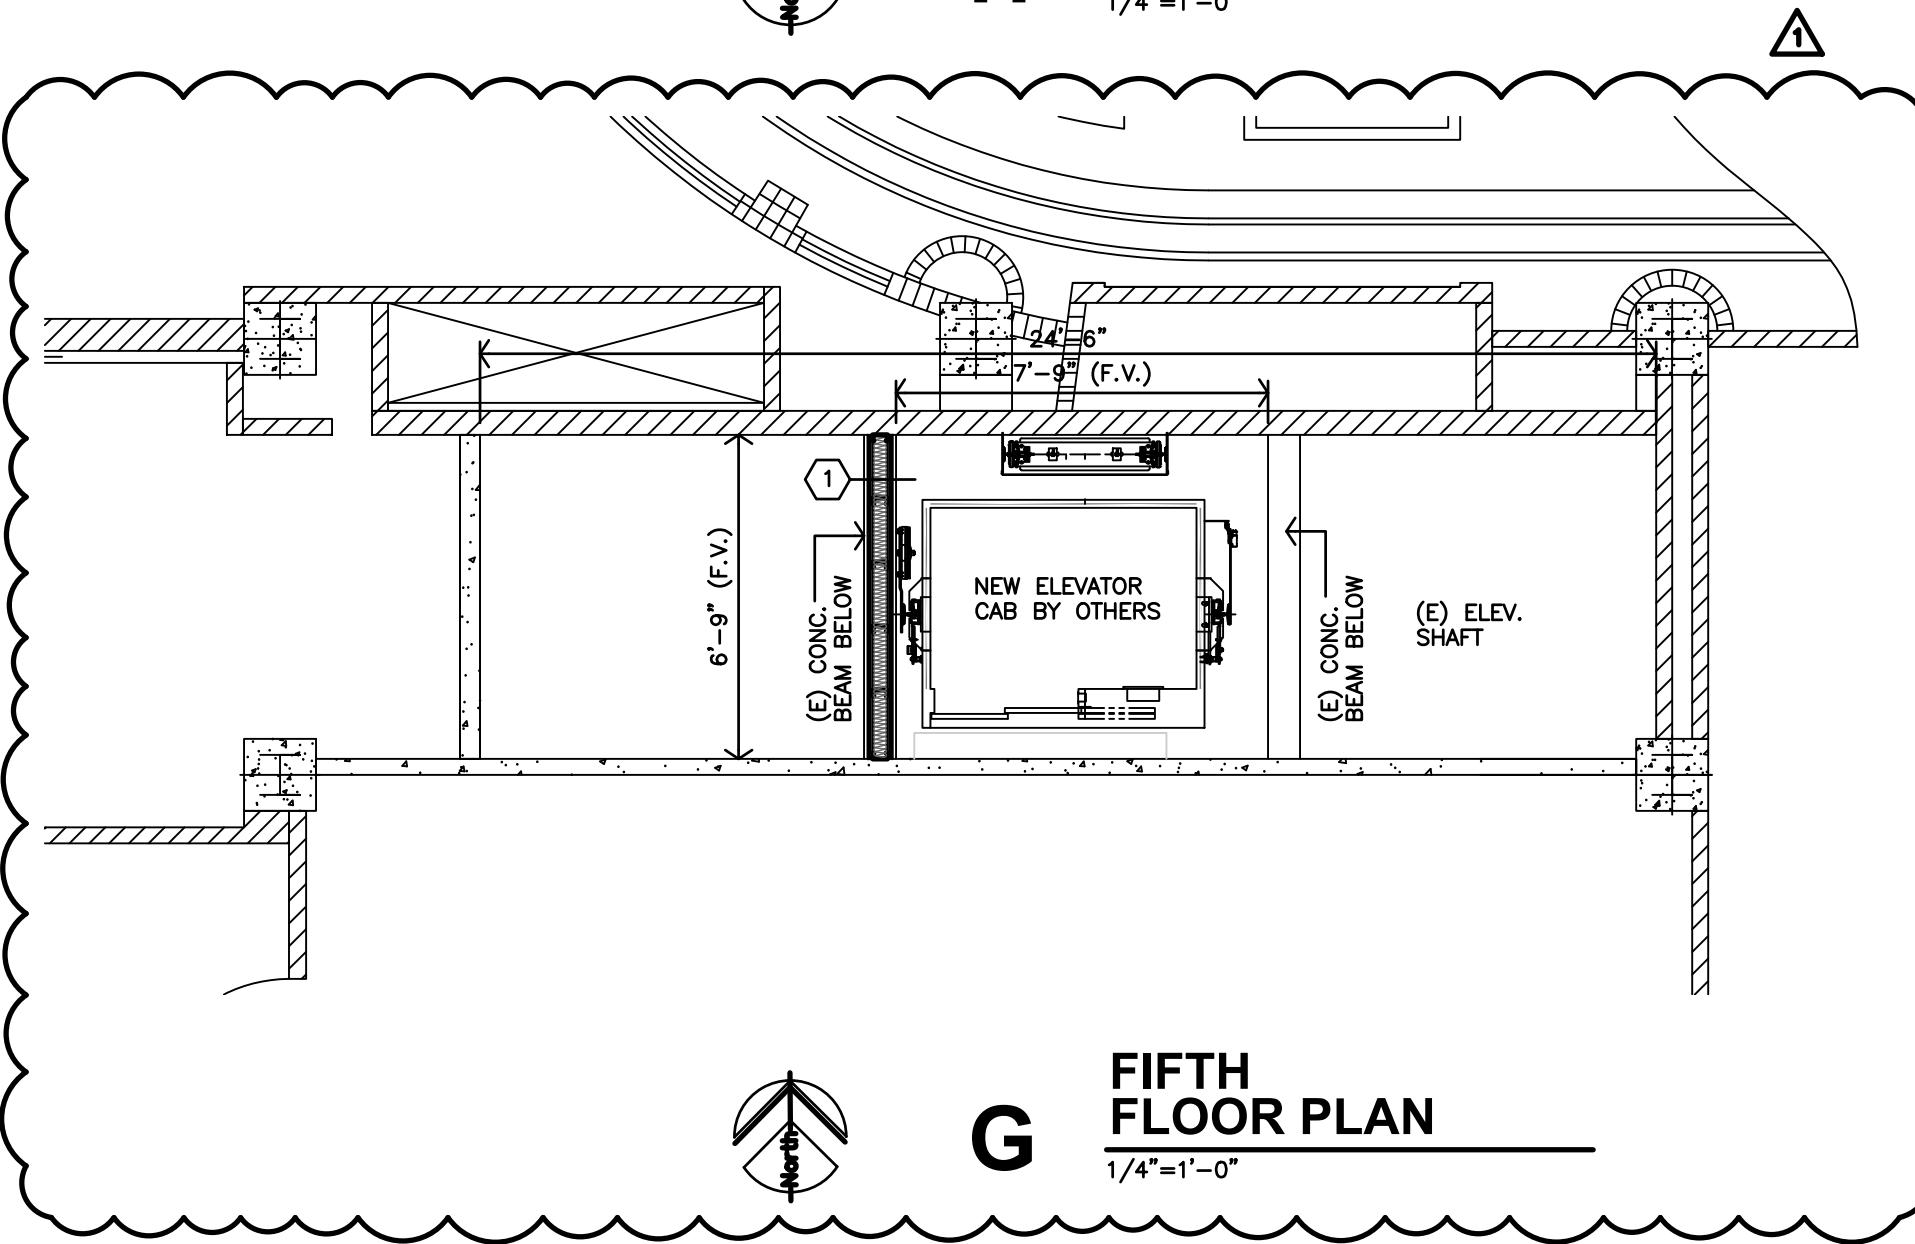


D SECOND (BALLROOM BALCONY)  
FLOOR PLAN  
1/4"=1'-0"



REVISION:

8-14-2025

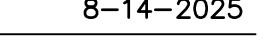

DATE: 8-5-2025  
JOB: 25-3499  
SHEET NO.:

## DEMOLITION NOTES

### GENERAL NOTES


- WHERE EXISTING BLDG. COMPONENTS ARE TO BE REMOVED, PATCH & REPAIR THE SURFACES TO MATCH EXISTING FINISH, UNLESS NEW FINISHES ARE CALLED FOR IN THE WORK SCHEDULE.
- REMOVE EXISTING BLDG. COMPONENTS AS INDICATED, IMPLIED OR AS REQUIRED SCHEMATICALLY SHOWN AS DASHED LINES. FIELD VERIFY ALL LOCATIONS.
- THE ELECTRICAL & MECHANICAL CONTRACTORS SHALL BE RESPONSIBLE FOR ALL CORE DRILLING FOR PIPING & CONDUIT INSTALLATION.
- ALL OTHER CUTTING, PATCHING & FINISHING, U.N.O. SHALL BE THE RESPONSIBILITY OF THE GENERAL CONTRACTOR.
- SHORING OF EXISTING STRUCTURE SHALL BE THE RESPONSIBILITY OF THE GENERAL CONTRACTOR.
- IT SHALL BE THE RESPONSIBILITY OF THE GENERAL CONTRACTOR TO COORDINATE THE DEMOLITION BY DIFFERING TRADES.
- CONTRACTOR COORDINATE SCHEDULE & LOCATION OF ANY OR ALL EXISTING RECEPTACLES, SWITCHES, DEVICES, ETC. PRIOR TO DEMOLITION, RELOCATE OR ABANDON ACCORDINGLY.
- COORDINATE & REFERENCE MECHANICAL & ELECTRICAL DRAWINGS FOR ADDITIONAL DEMOLITION ITEMS AND DETAILS

### GENERAL & BASEMENT


- REMOVE EXISTING WOODEN ACCESS STAIR AND RAIL AT UPPER PENTHOUSE
- REMOVE PORTION OF EXISTING CLAY BLOCK WALL AND PLASTER FINISH. PREP OPENING FOR THE INSTALLATION OF NEW DOOR AND FRAME.

### OSHA NOTE

- MECHANICAL ROOM ACCESS STAIRS SHALL BE CONSTRUCTED PER OSHA STANDARDS IN CHAPTER 1910.25.
- STAIR MAXIMUM RISE SHALL BE 9.5". STAIR TREAD MINIMUM SHALL BE 9.5".
- DOOR SWINGING INTO LANDING SHALL RETAIN A 22" CLEAR TO THE HANDRAIL.

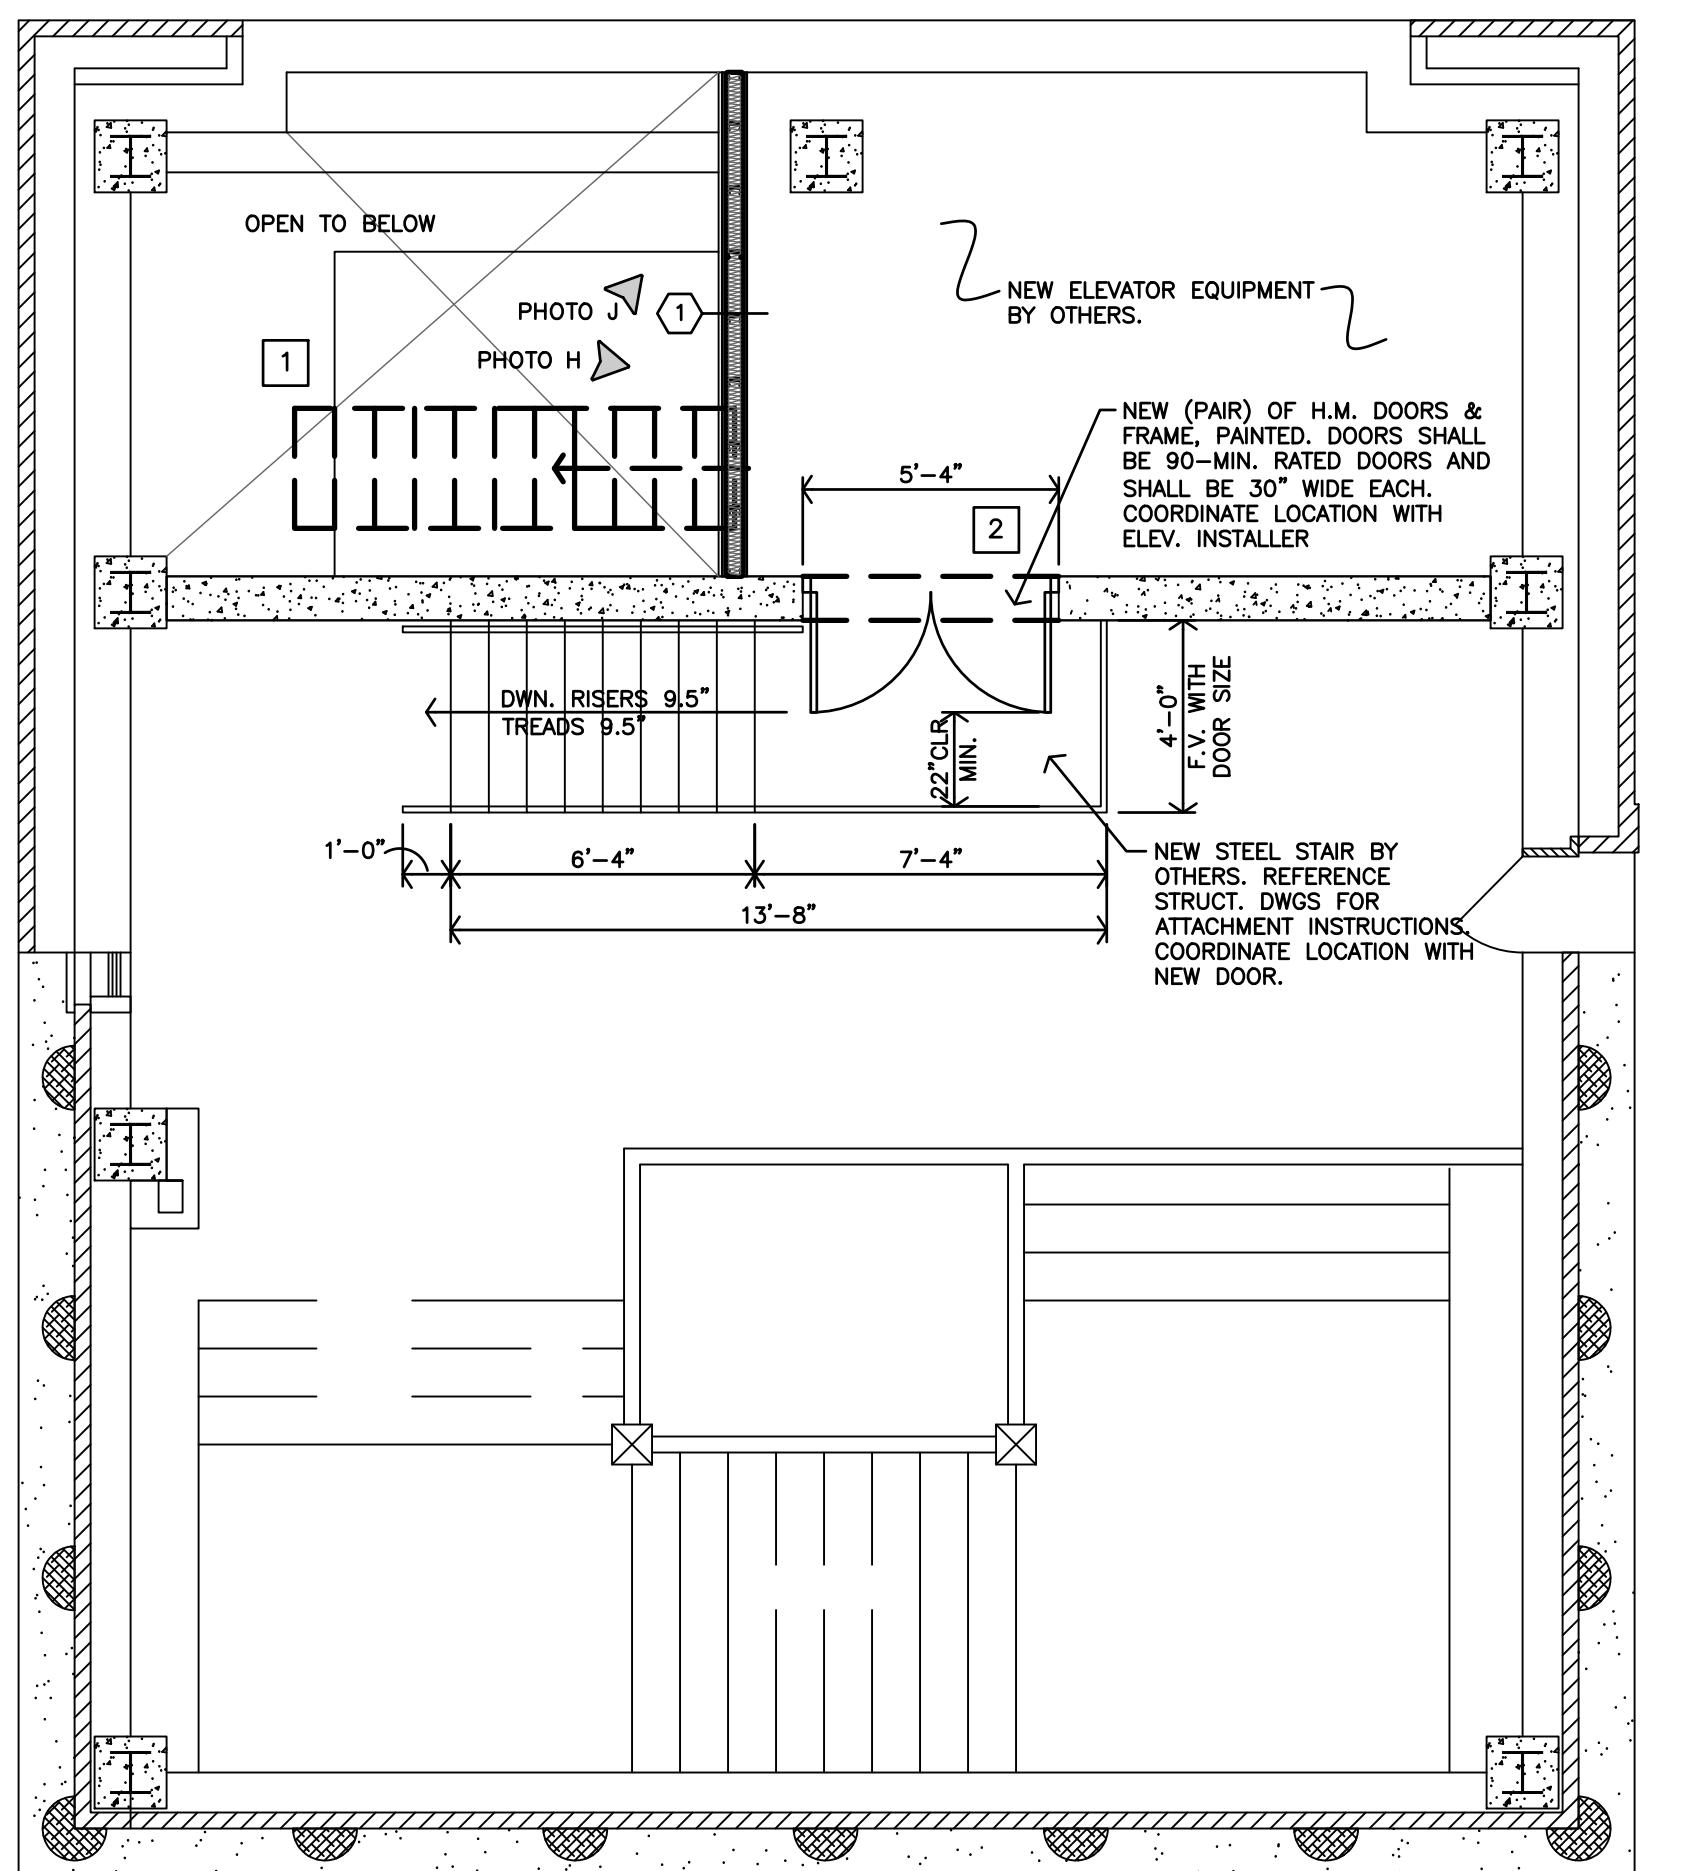

B PENTHOUSE (UPPER)  
FLOOR PLAN  
1/4"=1'-0"

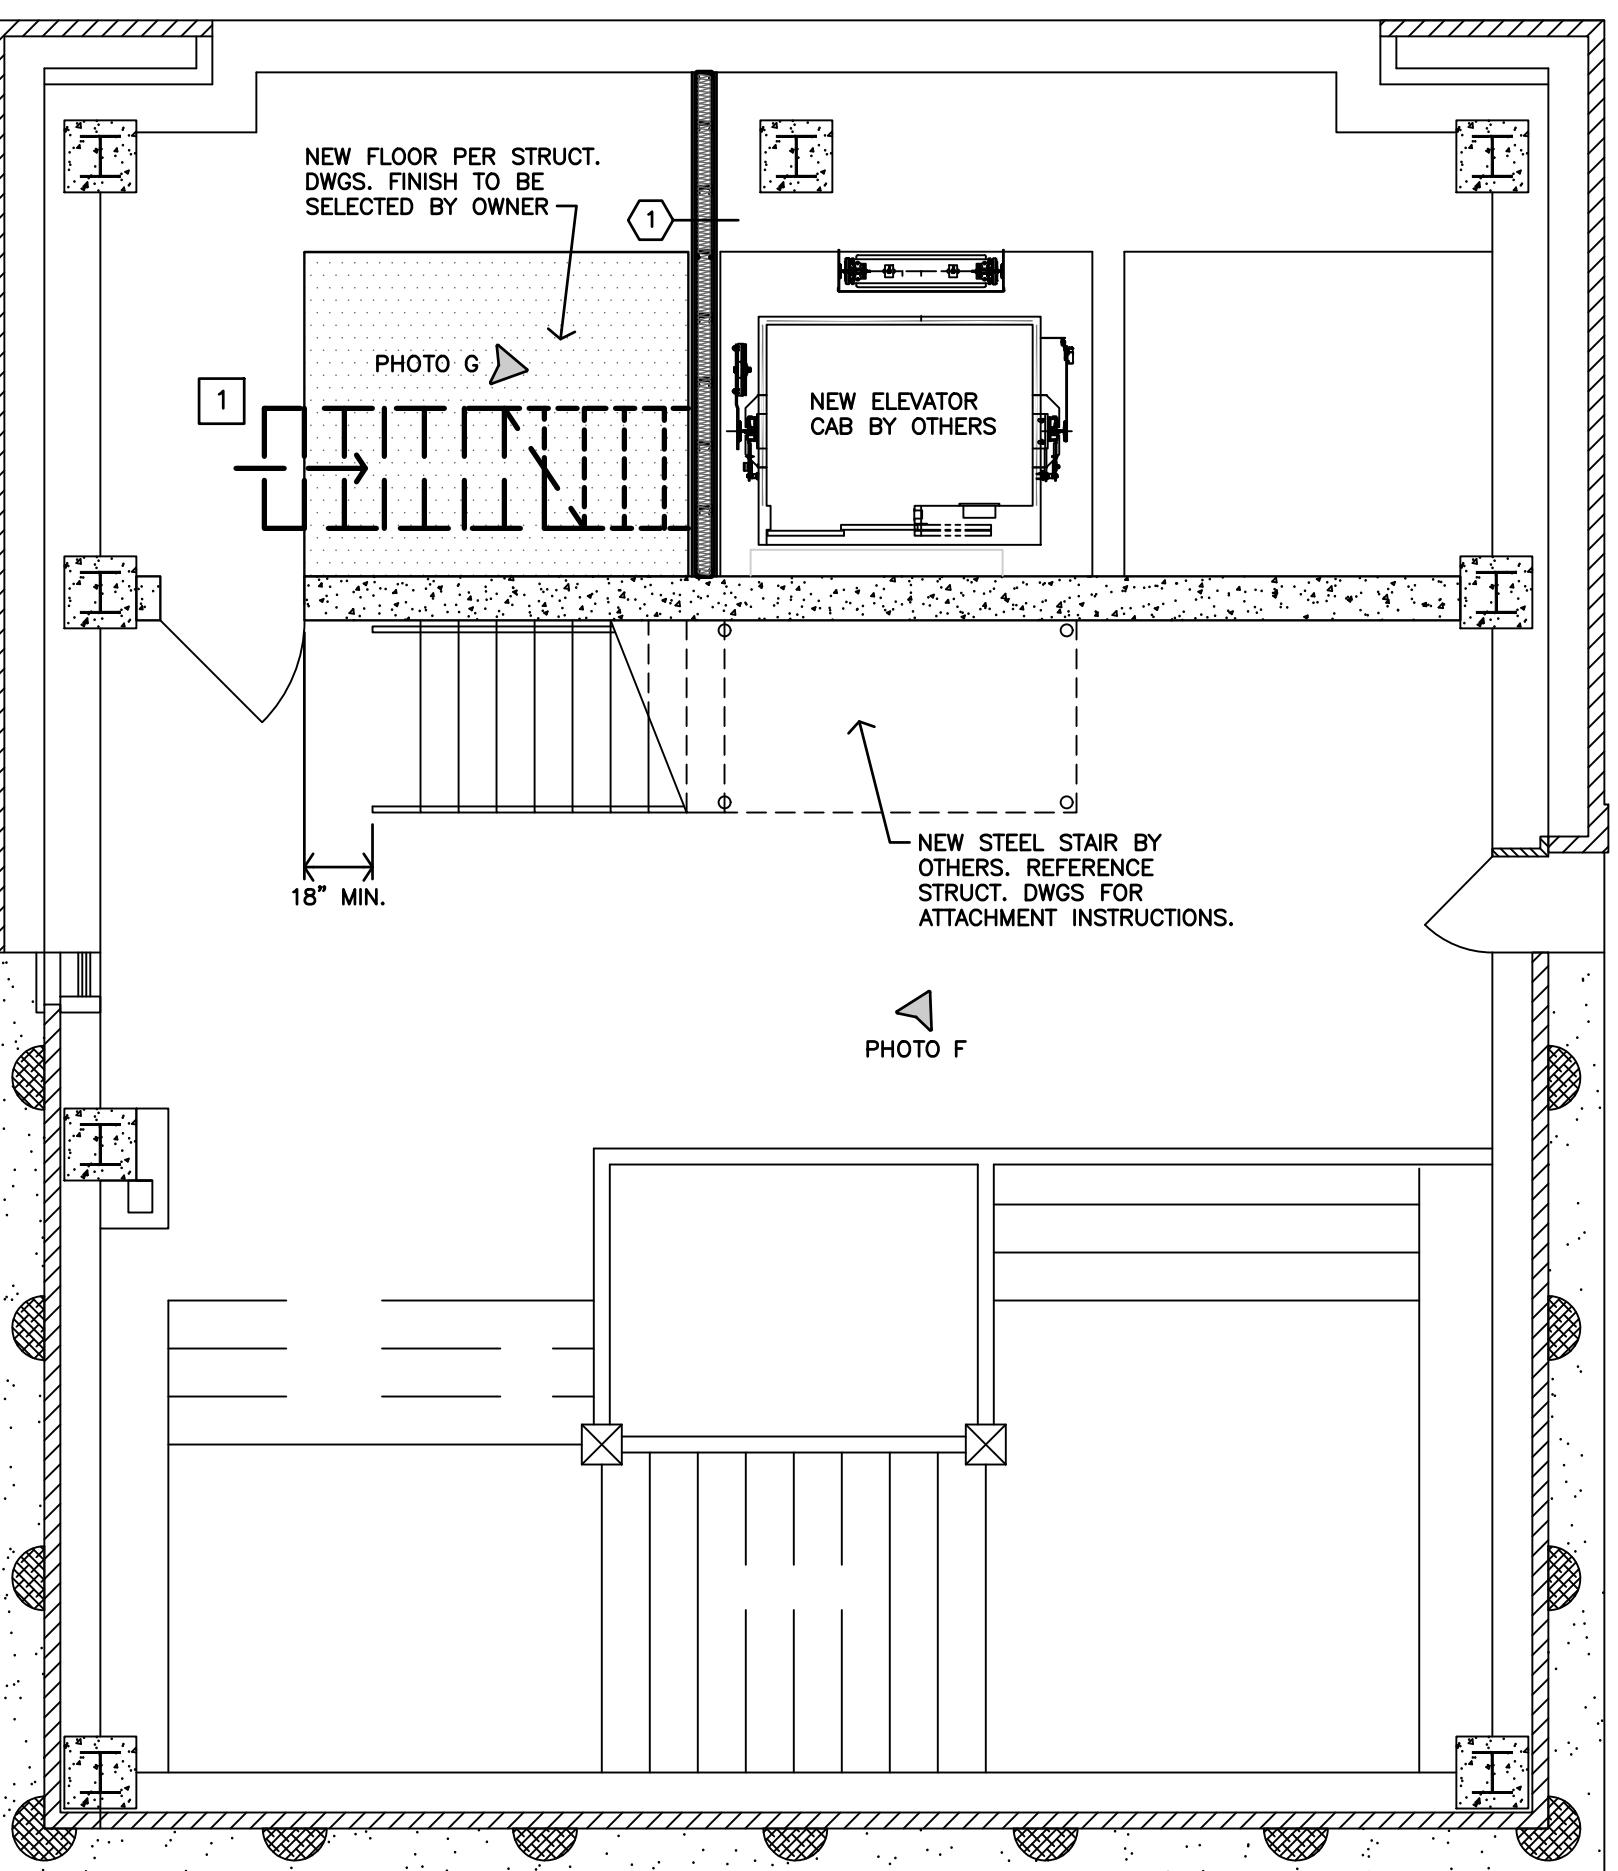

A PENTHOUSE (LOWER)  
FLOOR PLAN  
1/4"=1'-0"



**TEMPLE**  
SALINA INNOVATION FOUNDATION  
ELEVATOR REHABILITATION PROJECT  
SALINA, KANSAS




REVISION:  
8-14-2025


DATE: 8-5-2025  
JOB: 25-3499  
SHEET NO.:




**F** PHOTOGRAPH

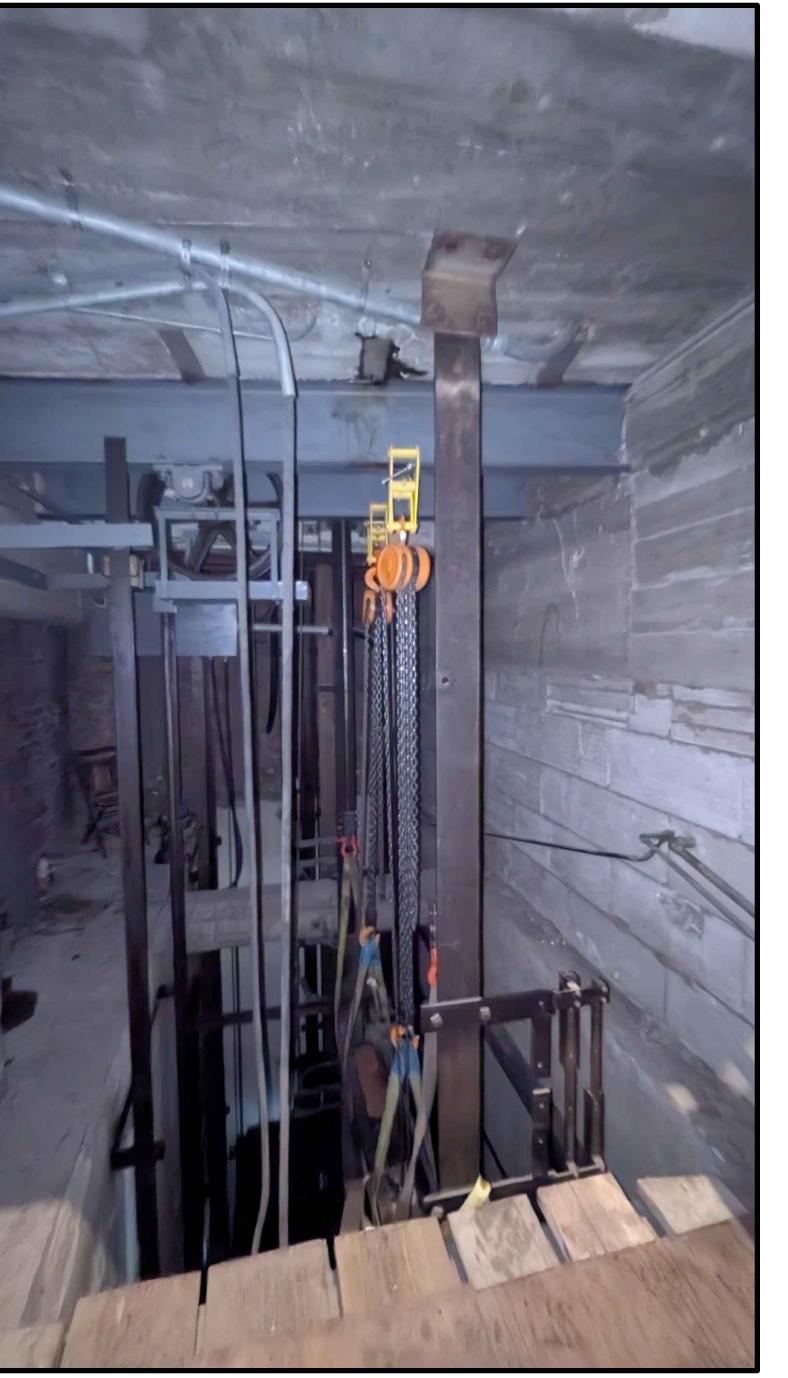


**G** PHOTOGRAPH

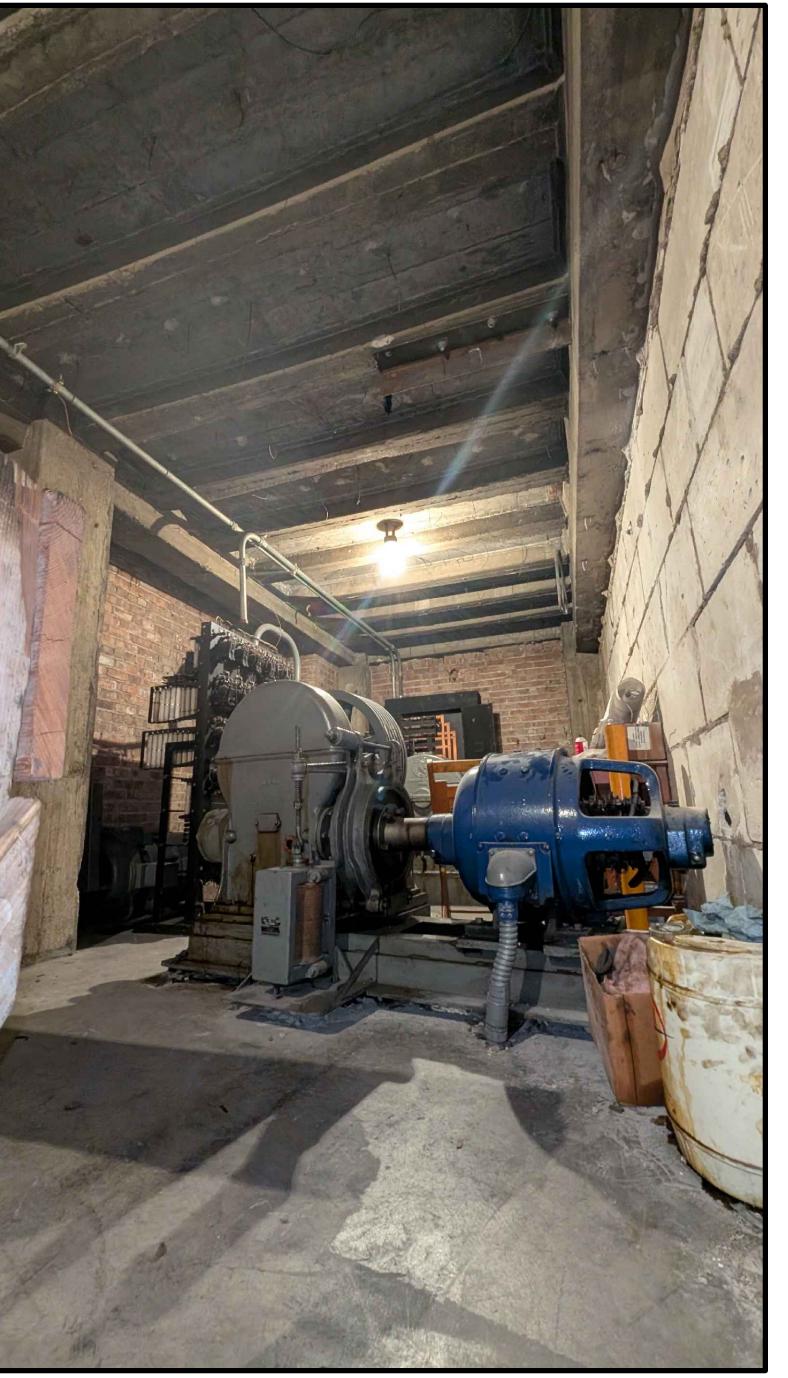

**H** PHOTOGRAPH

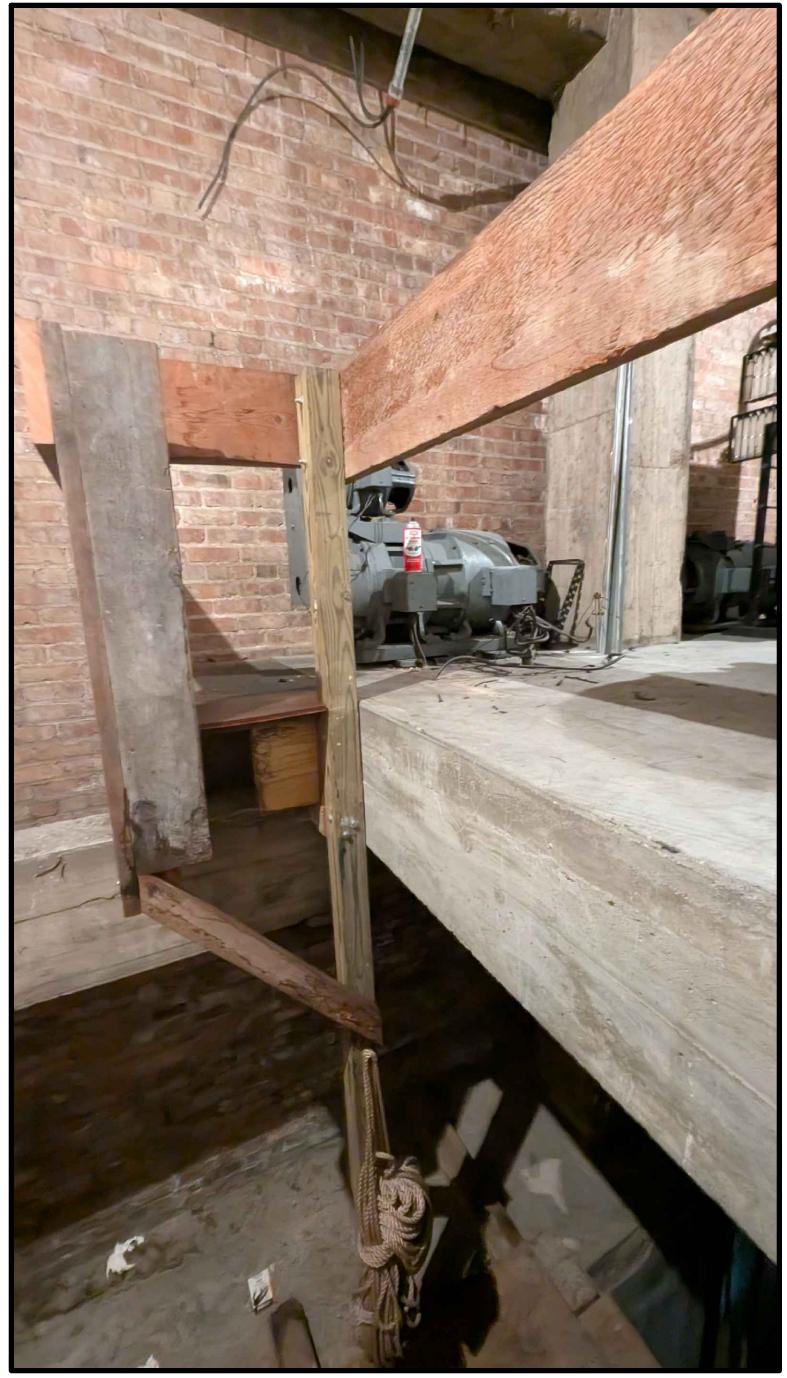


**J** PHOTOGRAPH

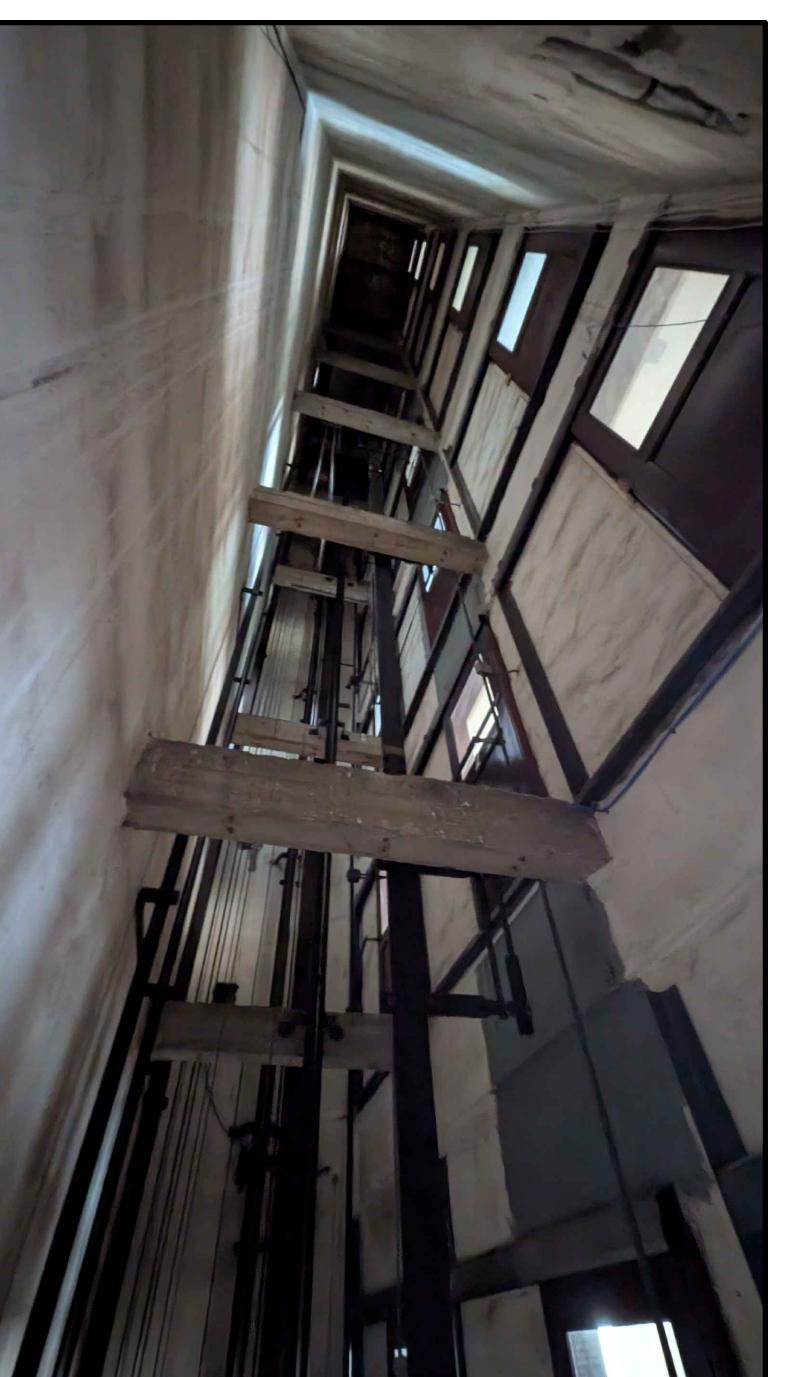

**C** PHOTOGRAPH




**B** PHOTOGRAPH

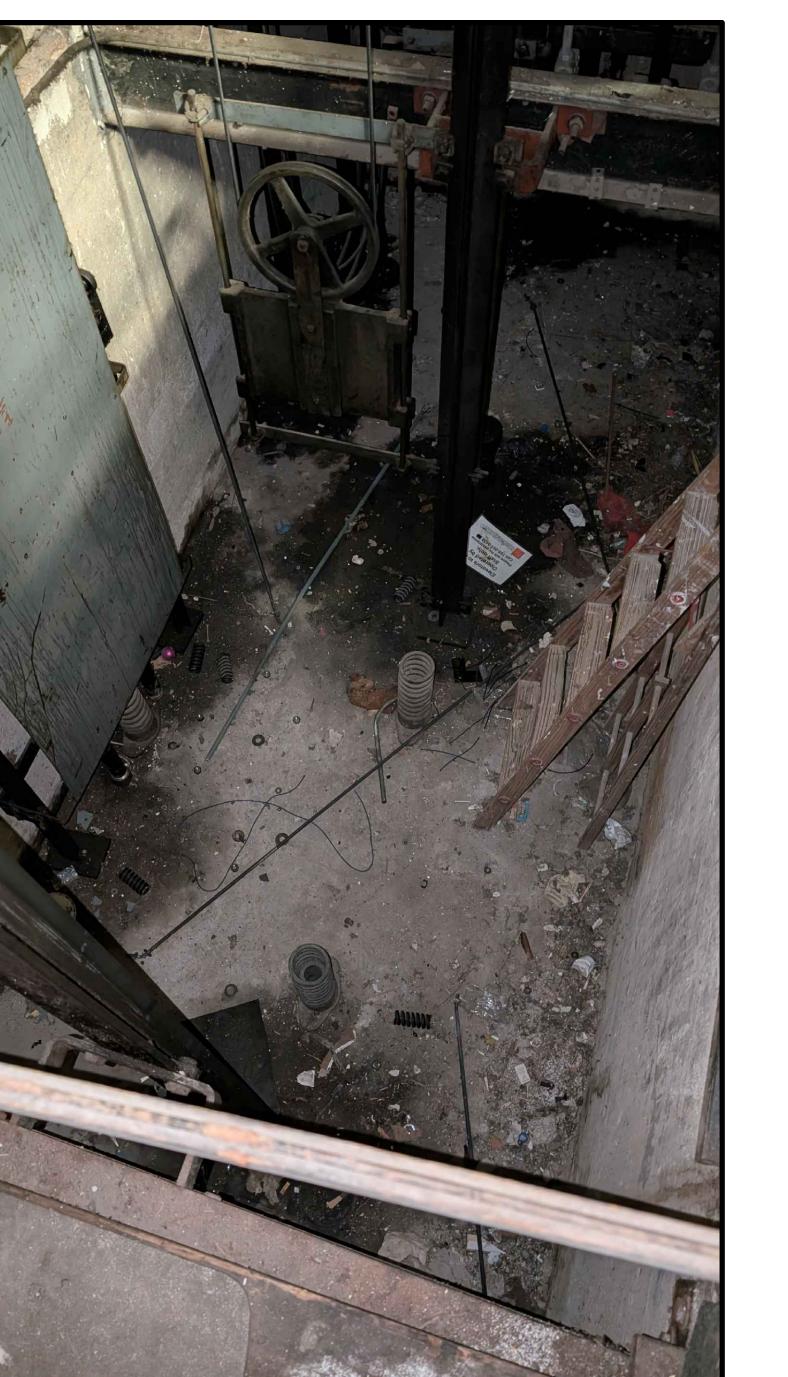

**A** PHOTOGRAPH




**D** PHOTOGRAPH

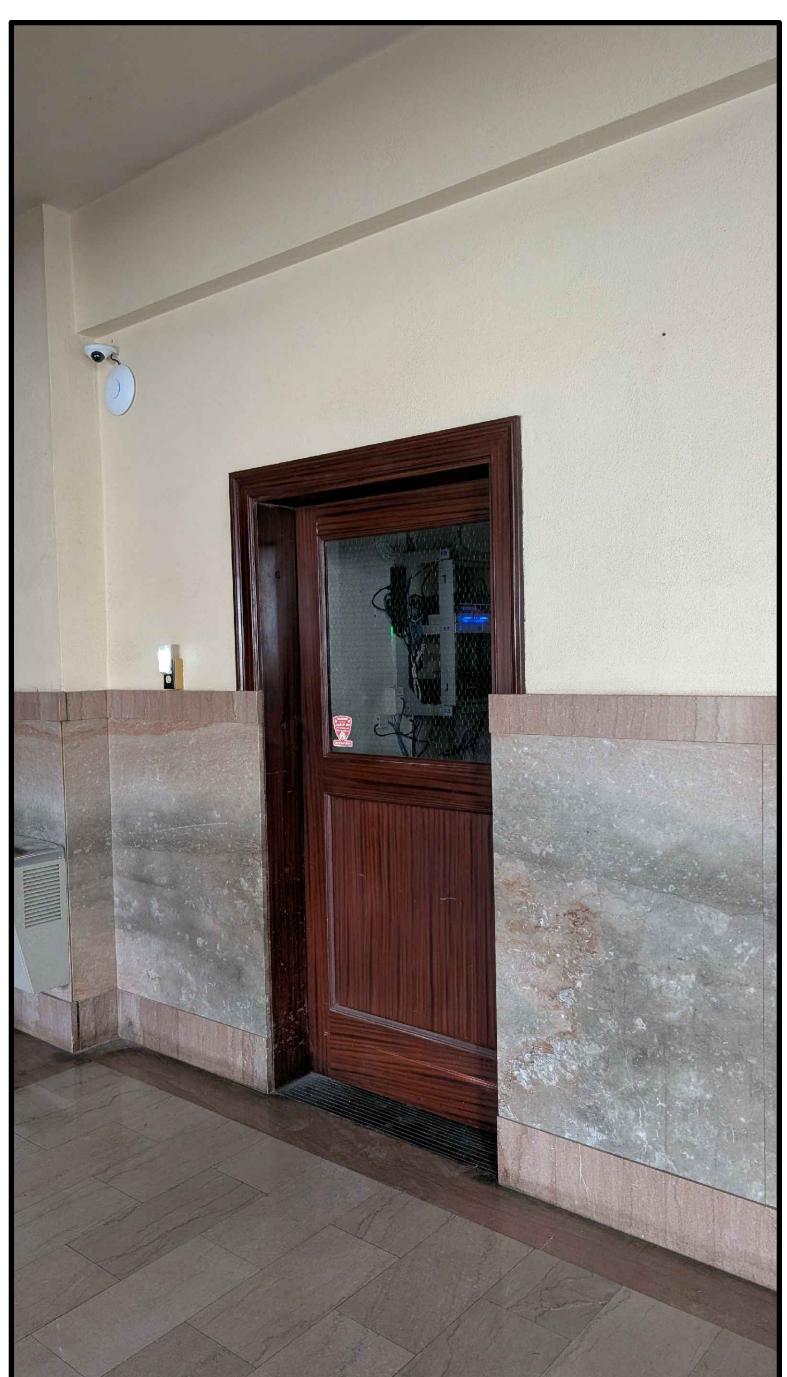

**E** PHOTOGRAPH






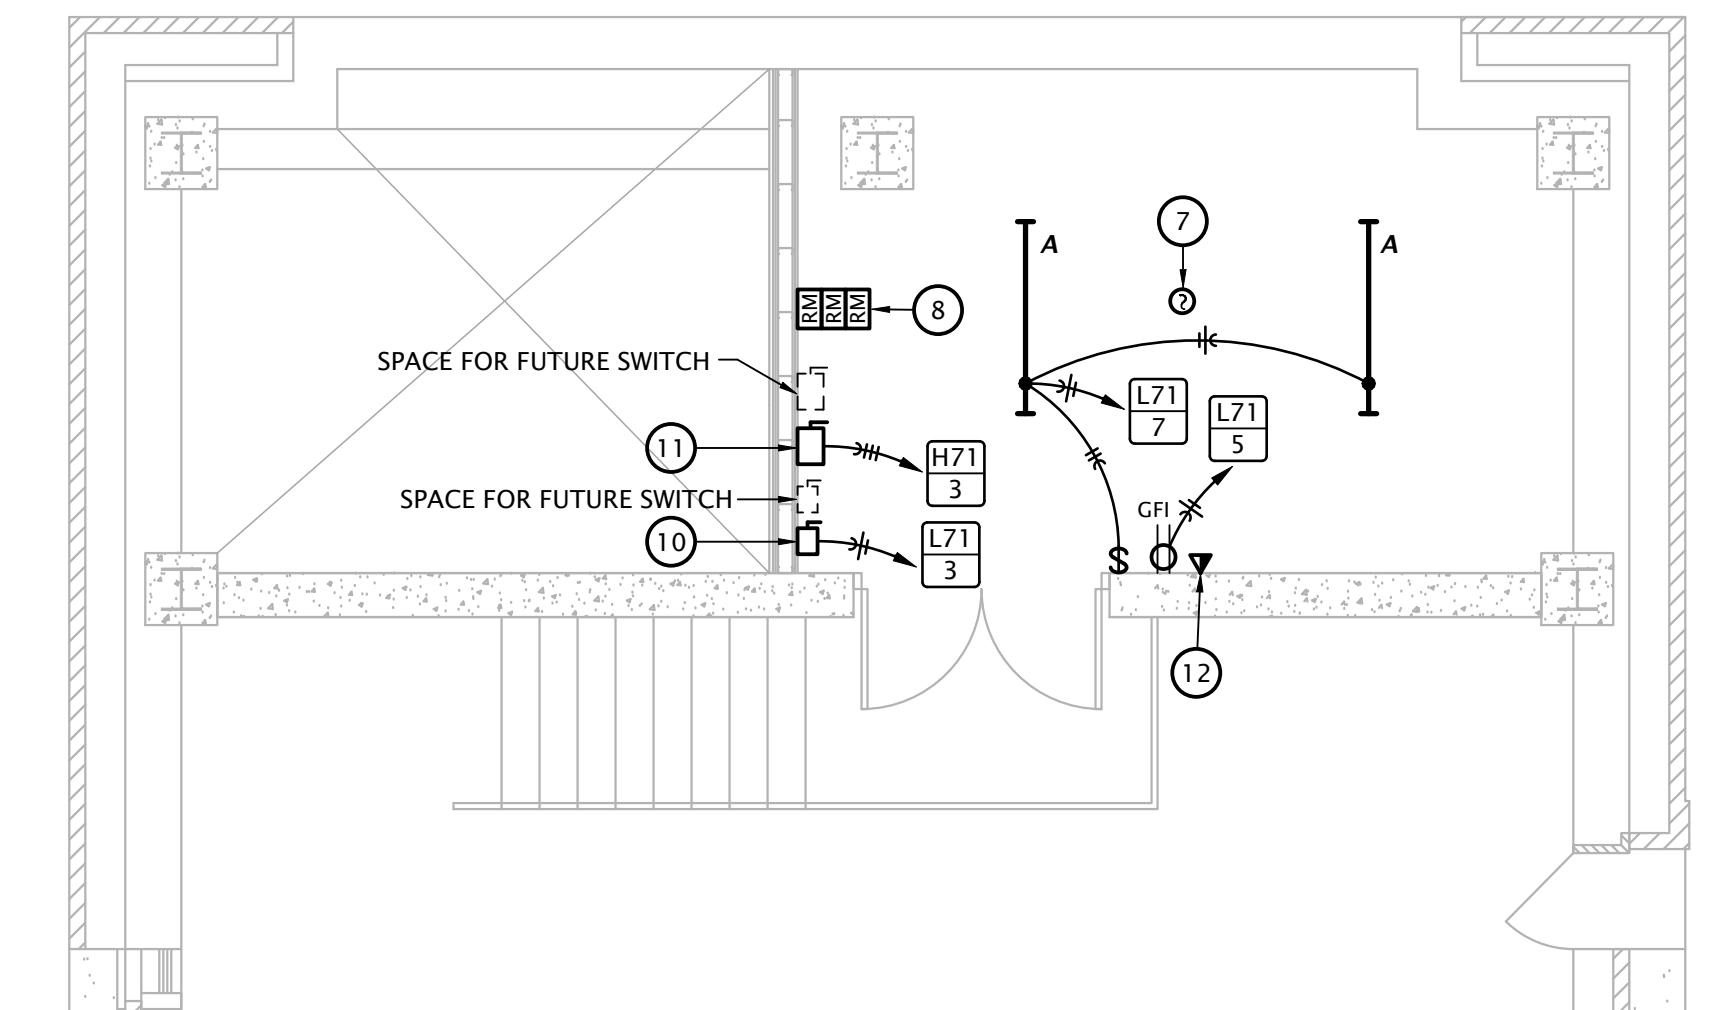


④ PARTIAL PENTHOUSE (UPPER) ELECTRICAL PLAN

1/4" = 1'-0"

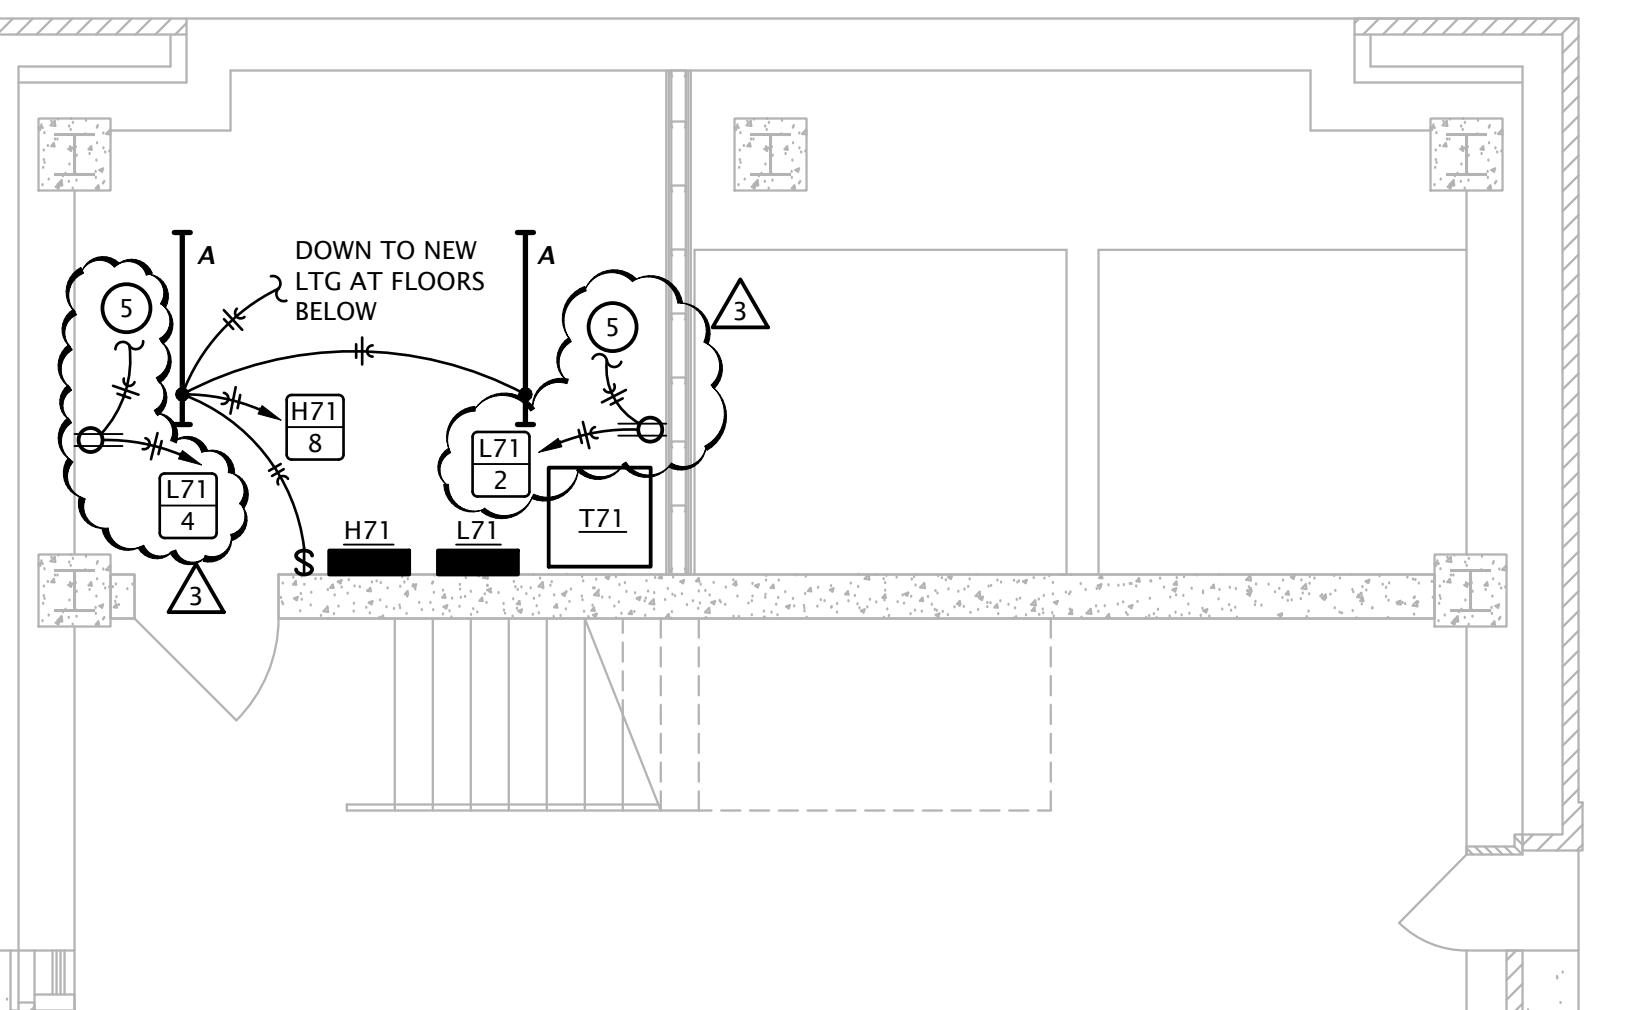

③ PARTIAL PENTHOUSE (LOWER) ELECTRICAL PLAN

1/4" = 1'-0"

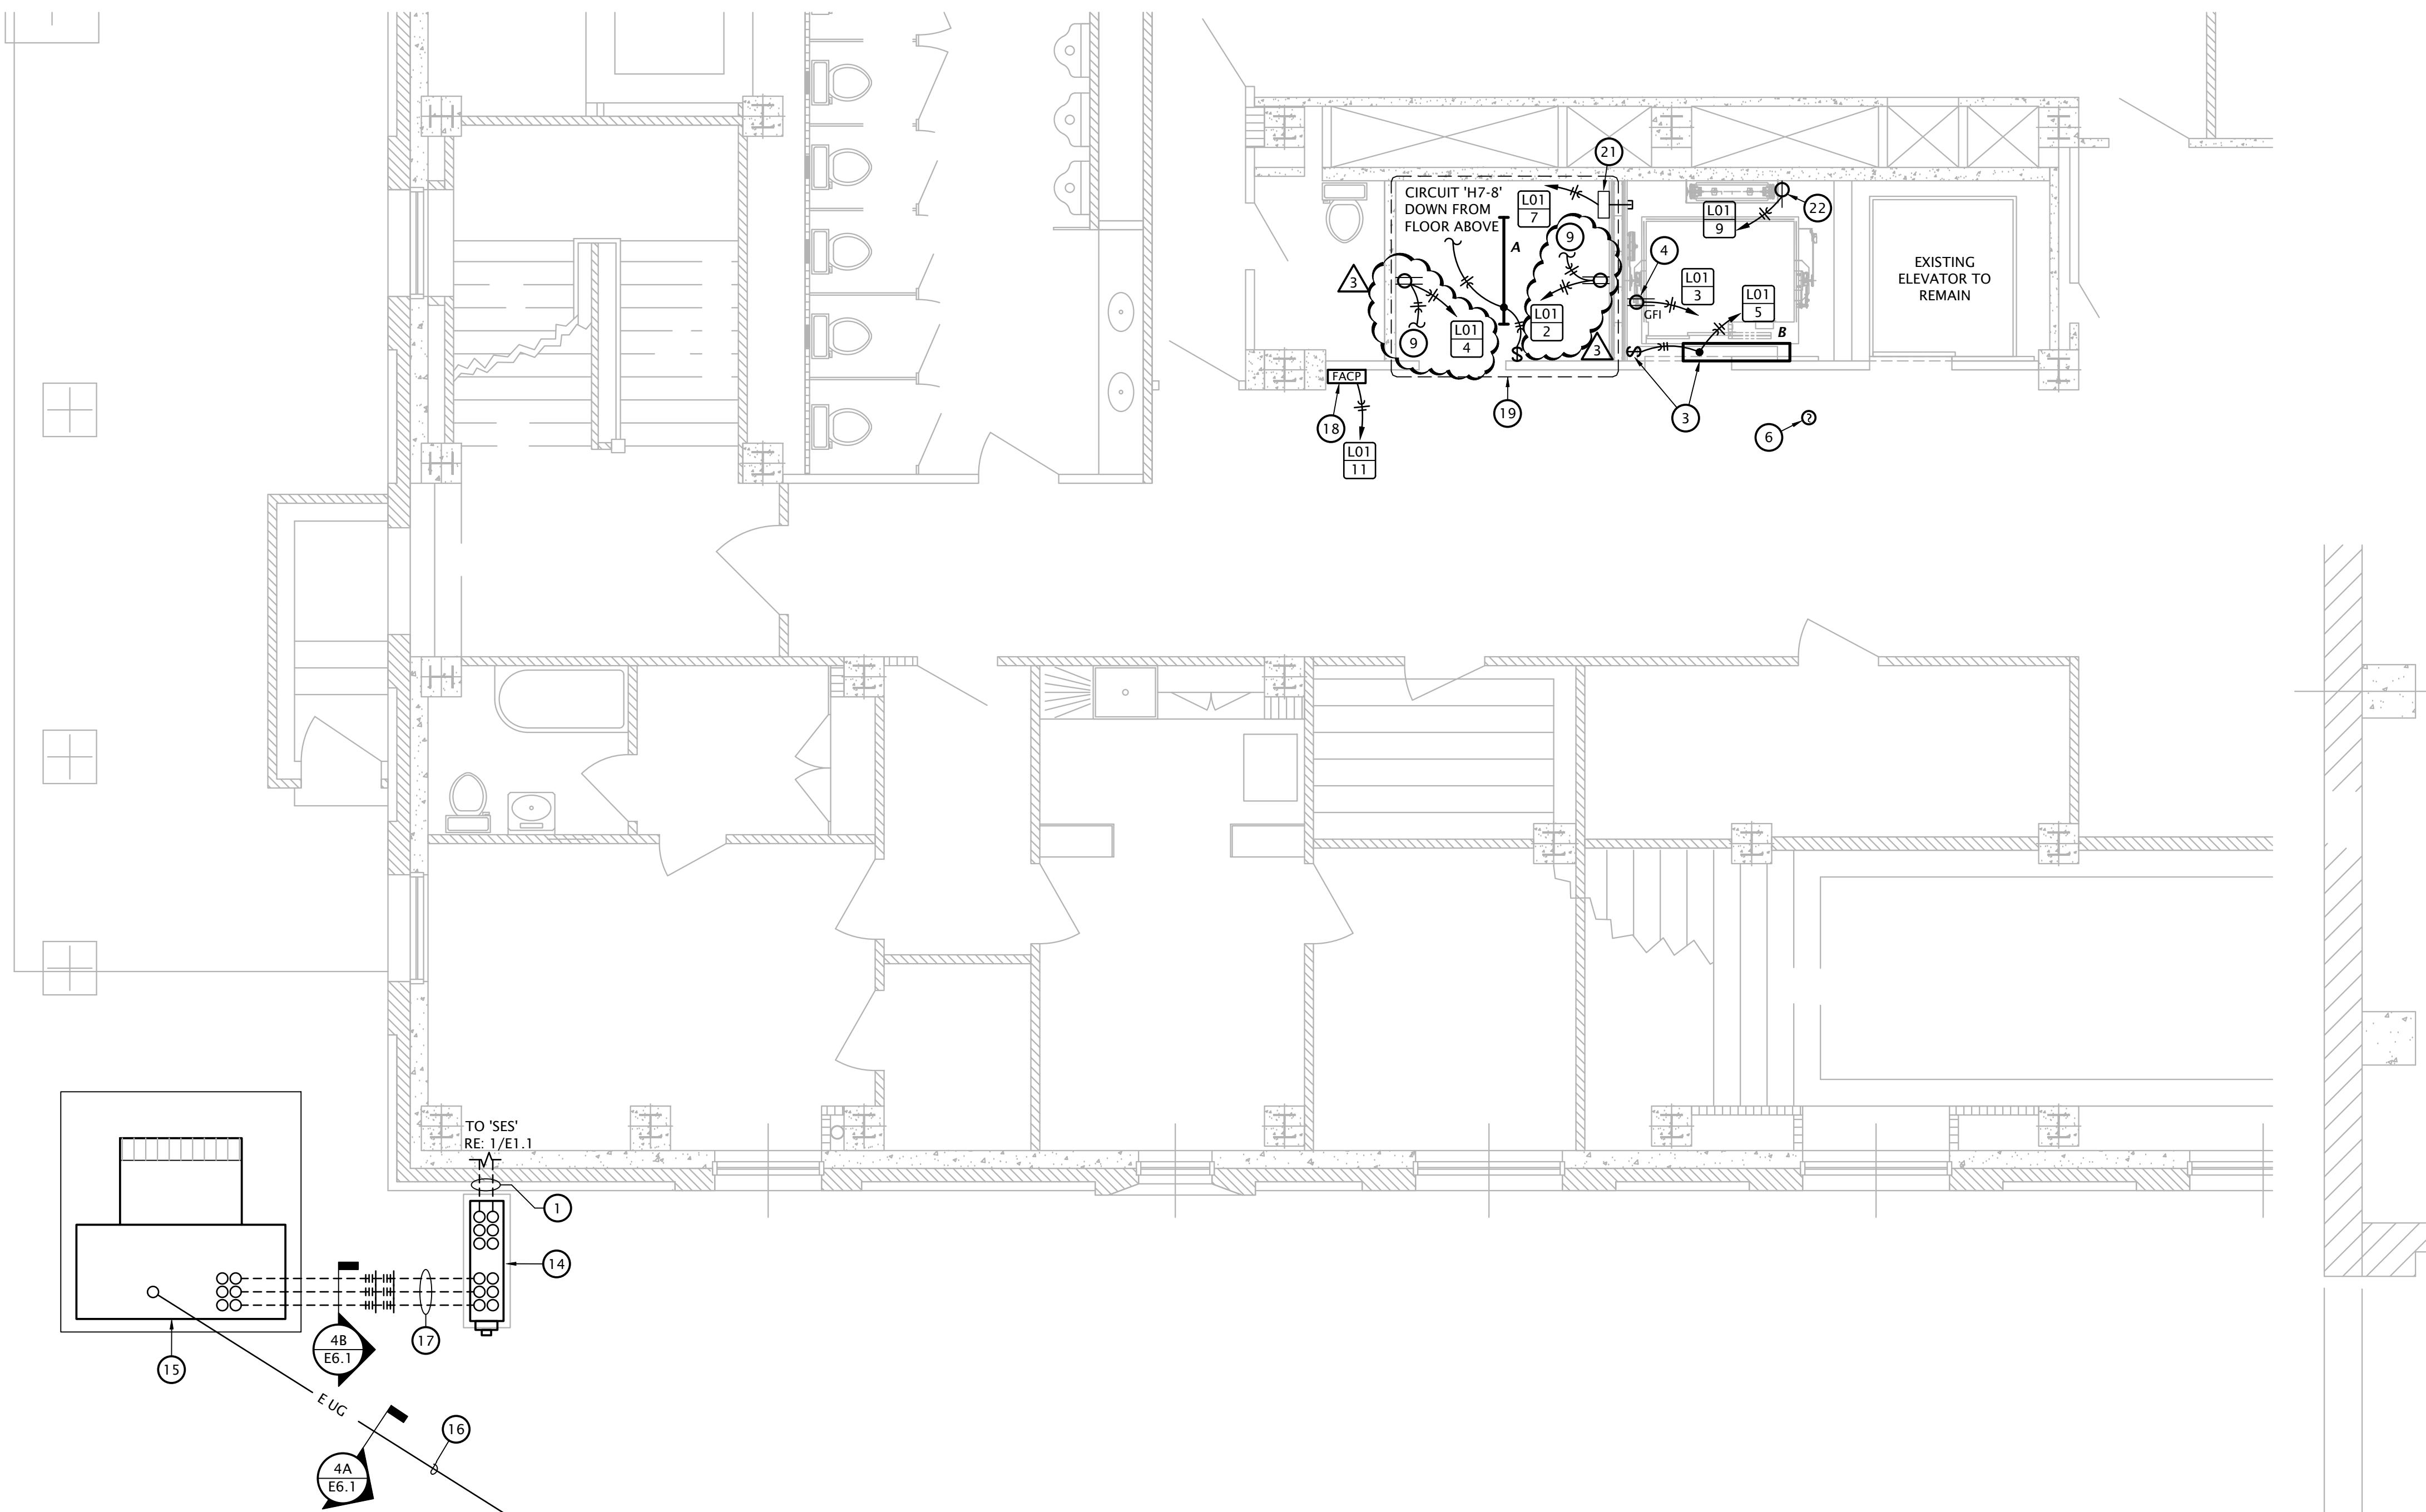

② PARTIAL LOWER LEVEL ELECTRICAL PLAN

1/4" = 1'-0"

① PARTIAL SUB-BASEMENT ELECTRICAL PLAN

1/4" = 1'-0"

④ ELECTRICAL PLAN NOTES BY SYMBOL

1. SERVICE ENTRANCE FEEDER FROM C:T CABINET. SEE ONE-LINE DIAGRAM ON SHEET E6.1. ROUTE OVERHEAD IN BASEMENT AND TERMINATE AT SWITCHBOARD 'SES'. KEEP RUNS AS SHORT AS POSSIBLE.
2. SLEEVE AND SEAL CONDUIT PENETRATIONS THROUGH EXTERIOR WALL WATER TIGHT.
3. INSTALL RECEPTACLE ON WALL OF ELEVATOR PIT. VERIFY EXACT LOCATION WITH ELEVATOR EQUIPMENT INSTALLER.
4. INSTALL LIGHT FIXTURE ON WALL OF ELEVATOR PIT AND CONTROL VIA SWITCH MOUNTED ADJACENT TO PIT LADDER. VERIFY EXACT LOCATION WITH ELEVATOR EQUIPMENT INSTALLER.
5. EXTEND CIRCUIT DOWN TO RECEPTACLE DIRECTLY BELOW ON MID-LEVEL STOP BETWEEN 6TH FLOOR AND PENTHOUSE, LEVEL 6, AND LEVEL 4.
6. ELEVATOR TOWER SMOKE DETECTOR. SEE DETAIL 2:E6.1. TYPICAL FOR LOWER LEVEL, FLOORS 1 THROUGH 4, FLOOR 6, AND MID-LEVEL STOP BETWEEN 6TH FLOOR AND PENTHOUSE (7 TOTAL). SEE DETAIL 2, SHEET E6.1.
7. ELEVATOR MACHINE ROOM SMOKE DETECTOR. SEE DETAIL 2:E6.1.
8. ADDRESSABLE FIRE ALARM RELAYS FOR ELEVATOR PRIMARY AND ALTERNATE LEVEL RECALL AND FIREMANS HAT. SEE DETAIL 2:E6.1.
9. EXTEND CIRCUIT UP TO RECEPTACLE DIRECTLY ABOVE ON LEVEL 1, LEVEL 2 AND LEVEL 3.
10. 30A FUSED DISCONNECT SWITCH WITH SOLID NEUTRAL AND (1) 20A DUAL-ELEMENT, TIME DELAY FUSE IN NEMA 1 ENCLOSURE FOR ELEVATOR CAB LIGHTS & EXHAUST. SWITCH SHALL BE CAPABLE OF BEING LOCKED "OFF". MOUNT AT 6'-0" AFF TO TOP AND LABEL WITH CORRESPONDING ELEVATOR CAR NUMBER AND CIRCUIT NUMBER. COORDINATE EXACT MOUNTING LOCATION AND REQUIREMENTS WITH ELEVATOR EQUIPMENT INSTALLER. PROVIDE FINAL ELECTRICAL CONNECTION TO ELEVATOR CONTROLLER.
11. ELEVATOR DISCONNECT SWITCH: 60A/3P SWITCH COMPLETE WITH 50A DUAL ELEMENT, TIME DELAY FUSES, AND AUXILIARY CONTACTS FOR ELEVATOR RECALL SIGNAL. COORDINATE EXACT MOUNTING LOCATION AND REQUIREMENTS WITH ELEVATOR EQUIPMENT INSTALLER, AND PROVIDE FINAL ELECTRICAL CONNECTION TO ELEVATOR CONTROLLER.
12. PROVIDE 4" SQUARE BOX WITH SINGLE GANG DEVICE RING AND (2) CATEGORY 5E CABLES IN 1" CONDUIT FROM TELECOM OUTLET TO MAIN TELEPHONE TERMINAL BOARD. MOUNT OUTLET AS DIRECTED BY ELEVATOR EQUIPMENT INSTALLER.
13. NOTE DELETED.
14. PAD MOUNTED C:T CABINET. VERIFY EXACT LOCATION WITH EVERGY. SEE 1/E6.1 FOR MORE INFORMATION.
15. POWER COMPANY PAD MOUNTED TRANSFORMER. PROVIDE 9' X 9' CONCRETE PAD PER EVERGY SERVICE STANDARDS DRAWING 10.35. COORDINATE EXACT LOCATION AND REQUIREMENTS WITH EVERGY PRIOR TO COMMENCING WORK.
16. 4" CONDUIT BELOW GRADE FOR POWER COMPANY PROVIDED PRIMARY CABLING. COORDINATE ROUTING AND TERMINATION POINT AT NEW UTILITY POLE WITH EVERGY. SEE ONE-LINE DIAGRAM, SHEET E6.1.
17. NEW SERVICE LATERAL BELOW GRADE FROM PAD MOUNTED UTILITY SERVICE TRANSFORMER TO C:T CABINET. SEE ONE-LINE DIAGRAM ON SHEET E6.1.
18. FIRE ALARM CONTROL PANEL DEDICATED FOR ELEVATOR RECALL AND SHUT-DOWN FUNCTIONS.
19. ELECTRICAL INSTALLATION OF LIGHTS AND RECEPTACLES IS TYPICAL FOR LOWER LEVEL, LEVELS 1 THROUGH 4, LEVEL 6, AND MID-LEVEL STOP BETWEEN 6TH FLOOR AND PENTHOUSE (7 TOTAL).
20. COMMON GROUNDING ELECTRODE CONDUCTOR BUSBAR. SEE DETAIL 3:E6.1.
21. PROVIDE 120V POWER CONNECTION TO ELEVATOR SUMP PUMP ALARM PANEL AND 1" CONDUIT WITH PULL STRING STUBBED INTO ELEVATOR PIT FOR CONTROL CABLING. COORDINATE ALL WORK WITH PLUMBING CONTRACTOR.
22. SIMPLEX RECEPTACLE IN ELEVATOR PIT FOR ELEVATOR SUMP PUMP. COORDINATE EXACT MOUNTING LOCATION WITH PLUMBING CONTRACTOR AND ELEVATOR EQUIPMENT INSTALLER.

**TEMPLE KANSAS**  
**SALINA INNOVATION FOUNDATION ELEVATOR REHABILITATION PROJECT**




REVISION:  
 1 ADDENDUM 1 - 8-14-2025  
 2 ADDENDUM 2 - 9-3-2025  
 3 ASI #2 - 1-28-2026

DATE: 8-5-2025  
 JOB: 25-3499  
 SHEET NO. 1




REVISION:  
 1 ADDENDUM 1 - 8-14-2025  
 2 ADDENDUM 2 - 9-3-2025

DATE: 8-5-2025  
 JOB: 25-3499  
 SHEET NO.:

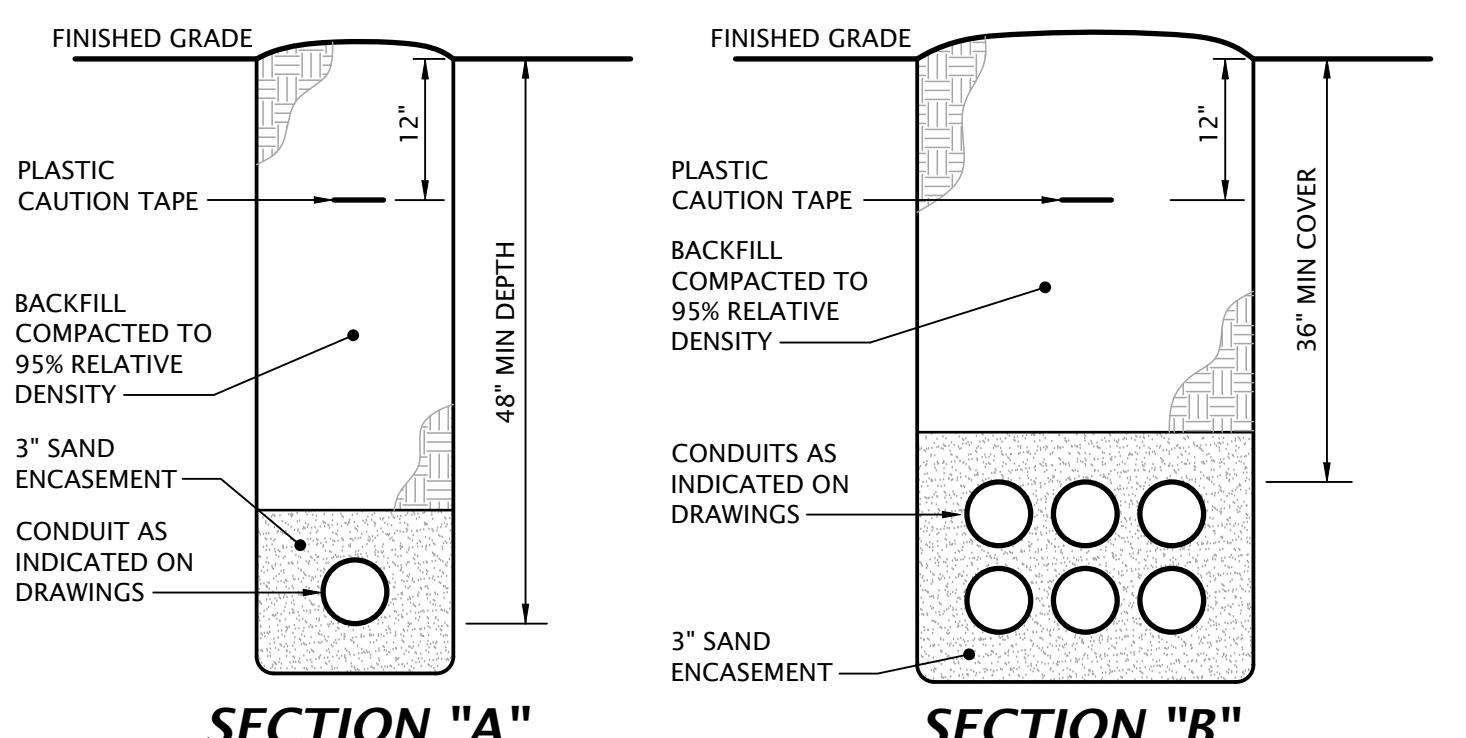

#### CONDUIT TRENCH DETAILS

4 No Scale

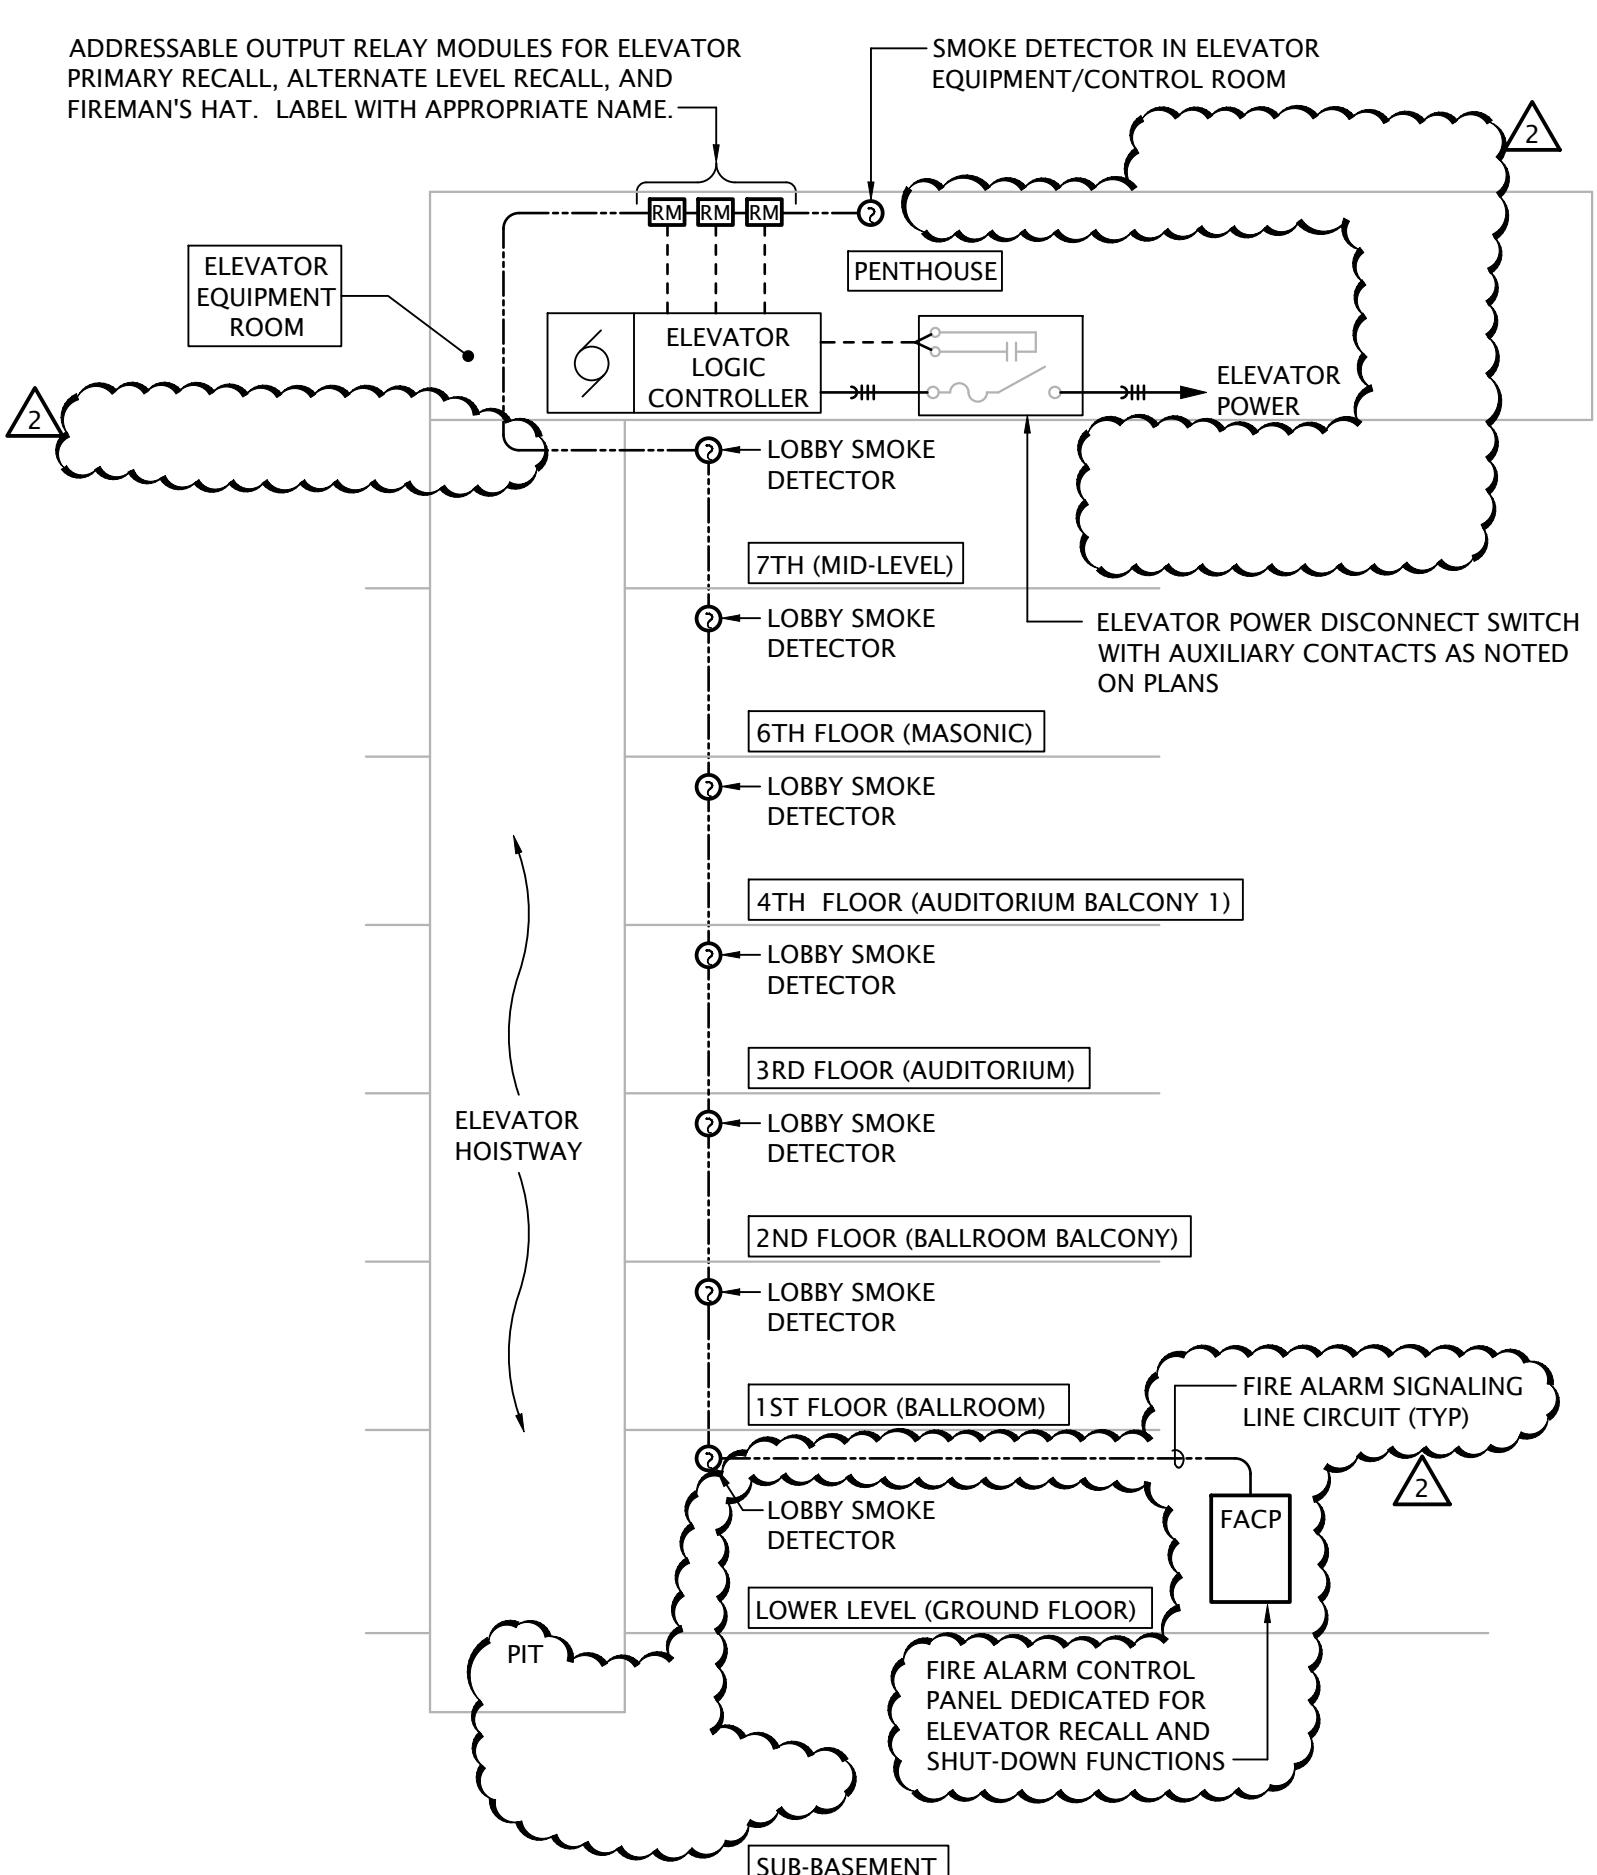


#### ELEVATOR SEQUENCE OF OPERATION: (DURING SMOKE/HEAT ALARM)

1. UPON SENSING SMOKE FROM ONE OR MORE LOBBY OR ELEVATOR EQUIPMENT ROOM, THE DETECTOR SHALL SIGNAL THE FACP, WHICH WILL FORWARD THE SIGNAL TO THE ELEVATOR LOGIC CONTROLLER TO RECALL ELEVATOR CAB TO THE DESIGNATED MAIN FLOOR. IF DESIGNATED FLOOR'S LOBBY SMOKE DETECTOR SENSES SMOKE AT THAT FLOOR, THE ELEVATOR CONTROLLER WILL SEND THE ELEVATOR CAB TO THE NEXT FLOOR CLEAR OF SMOKE. ONCE THE ELEVATOR CAB HAS REACHED THE DESIGNATED FLOOR, THE ELEVATOR CAB DOORS WILL OPEN AND THE CONTROLLER WILL LOCK THE ELEVATOR CAB AT THAT FLOOR, DISABLING THE ELEVATOR CAB CONTROLS, UNLESS A FIREMAN'S KEY IS USED TO OVERRIDE AUTOMATIC CONTROLS.
2. ALL SMOKE DETECTORS (LOBBIES, MACHINE ROOM) SHALL TRANSMIT A SEPARATE AND DISTINCT VISIBLE ANNUNCIATION AT THE FACP.

#### ELEVATOR INTERLOCK WITH FIRE ALARM

2 No Scale

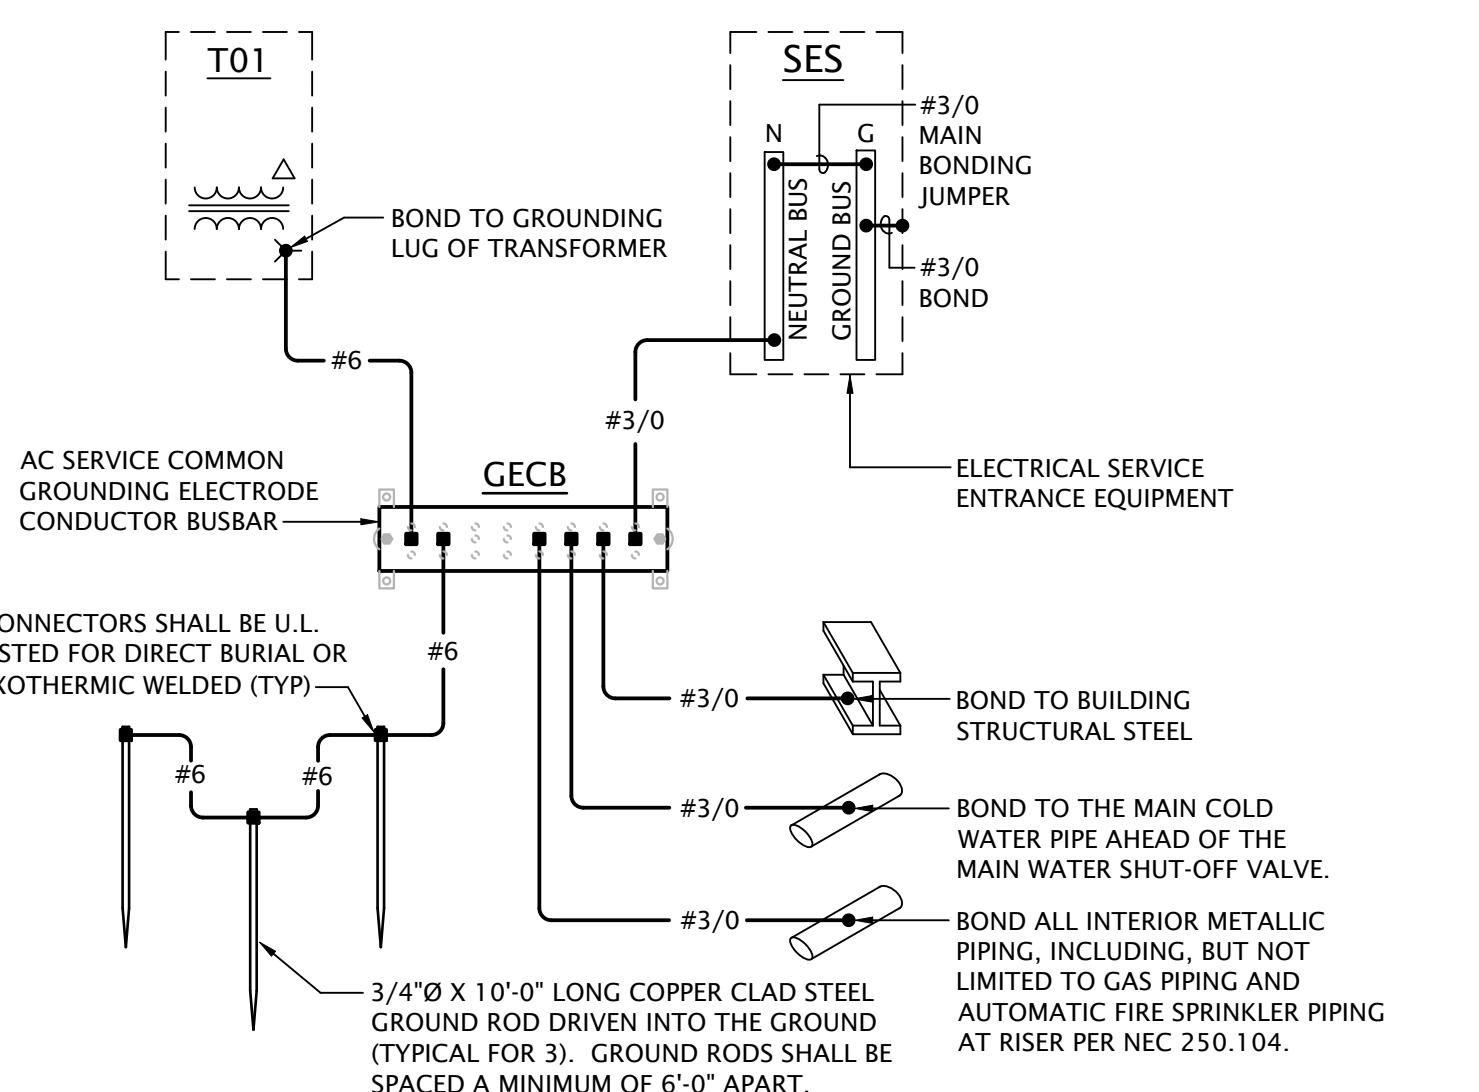


#### NOTES:

1. COMMON GROUNDING ELECTRODE CONDUCTOR BUSBAR SHALL BE 1/4" THICK x 4" WIDE x 18" LONG, TIN PLATED COPPER BUSBAR. PROVIDE COMPLETE WITH INSULATING STAND OFFS, STAINLESS STEEL BRACKETS AND MOUNTING BOLTS. MOUNT ON WALL AT 18" AFF. ERICO #EGBA14418CCT OR EQUAL.
2. ALL CONNECTIONS TO GROUNDING BUSBAR SHALL BE MADE USING COMPRESSION TYPE LUGS (BURNRD 'YAZ' SERIES OR EQUAL). MECHANICAL LUGS ARE NOT ACCEPTABLE.
3. INSTALL ALL GROUNDING ELECTRODE CONDUCTORS IN 3/4" CONDUIT WHERE EXPOSED AND WHERE SUBJECT TO PHYSICAL DAMAGE.
4. CONTRACTOR SHALL MEASURE RESISTANCE TO GROUND AND PROVIDE ADDITIONAL GROUND ROD OR PLATE ELECTRODES AS REQUIRED UNTIL A RESISTANCE TO GROUND OF 25 OHMS OR LESS IS ACHIEVED.

#### AC SERVICE GROUNDING ELECTRODE SYSTEM DETAIL

3 No Scale

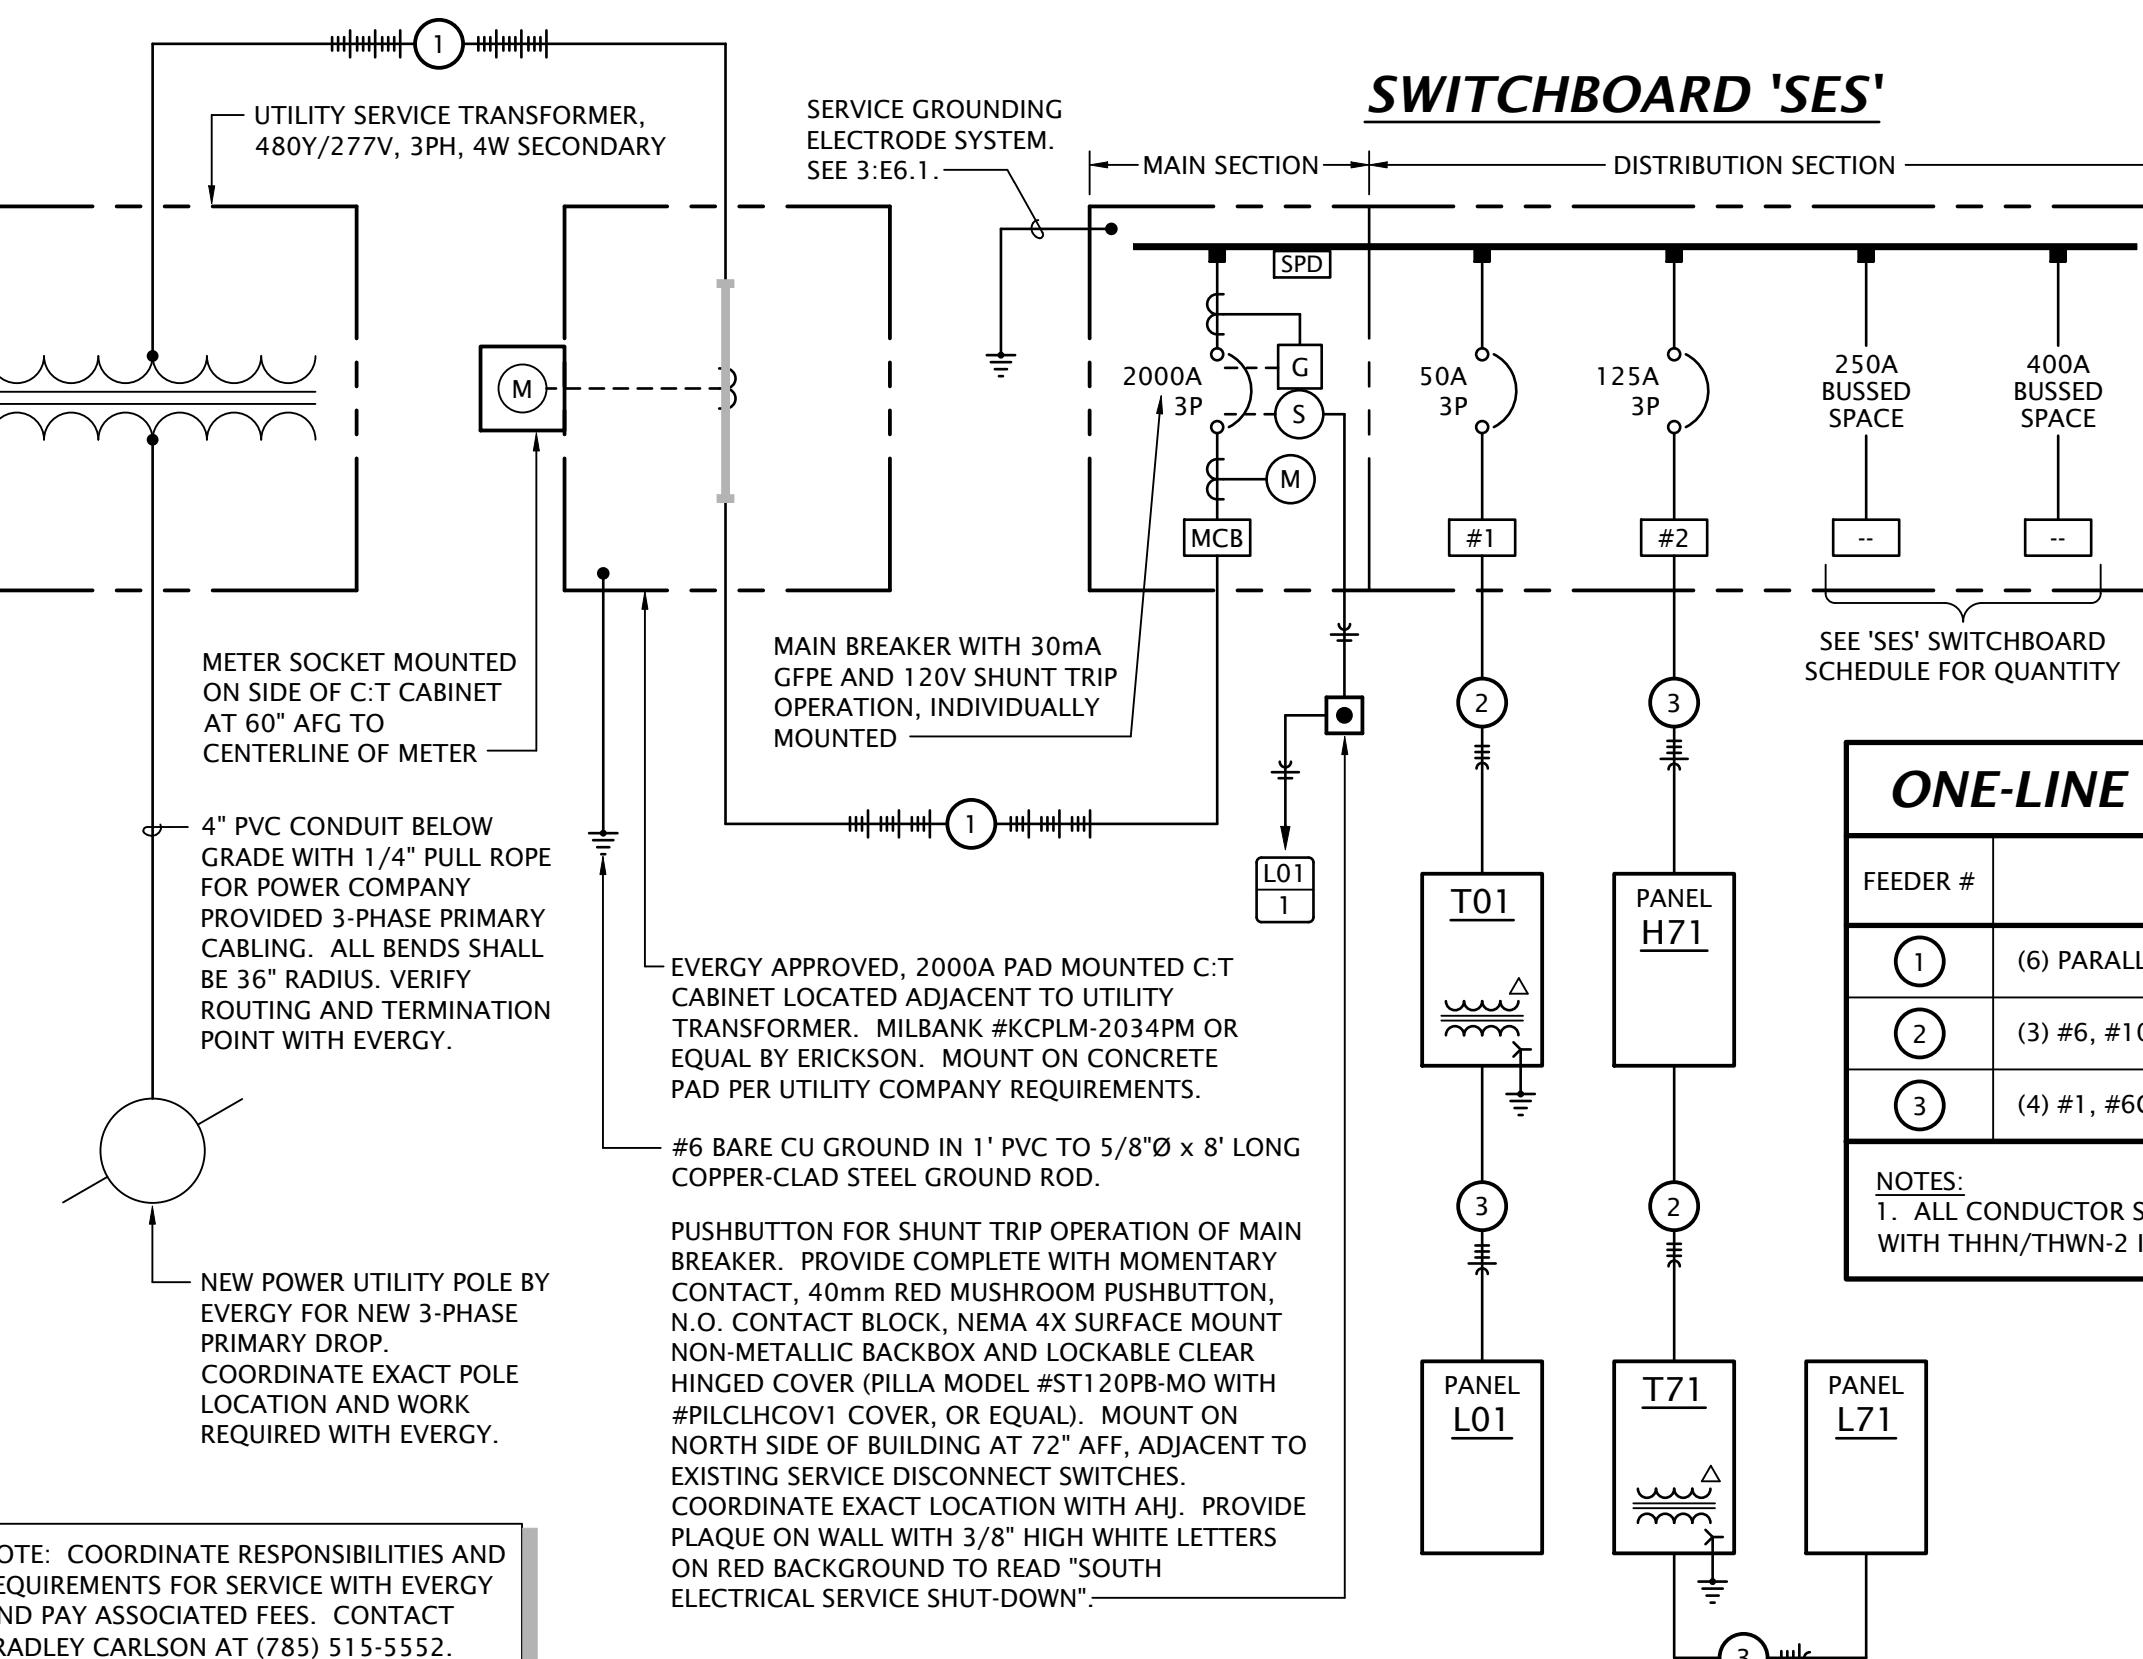

NOTE: COORDINATE RESPONSIBILITIES AND REQUIREMENTS FOR SERVICE WITH ENERGY AND PAY ASSOCIATED FEES. CONTACT BRADLEY CARLSON AT (785) 515-5552.

#### GENERAL ELECTRICAL NOTES

- ELECTRICAL EQUIPMENT AND DEVICES SHALL BE "LISTED" AND "IDENTIFIED" AS REQUIRED FOR A MINIMUM OF 75°C CONDUCTOR TERMINATION.
- BRANCH CIRCUIT SIZES SHOWN ON PANEL SCHEDULES ARE MINIMUM, AND ALLOWANCES SHALL BE MADE TO LIMIT VOLTAGE DROP. ALL 15 AMP AND 20 AMP, 120V CIRCUITS OVER 75' LONG SHALL BE INCREASED BY ONE WIRE SIZE, AND OVER 150' LONG SHALL BE INCREASED BY TWO WIRE SIZES.
- COORDINATE INSTALLATION OF ELECTRICAL WORK ABOVE THE CEILING TO PROVIDE THE GREATEST POSSIBLE CLEARANCE FOR INSTALLATION OF PLUMBING AND MECHANICAL INSTALLATION. CONDUITS SHALL BE ROUTED THROUGH JOIST WEBS WHERE POSSIBLE.
- VERIFY EXACT PLACEMENT OF ALL LUMINAIRES, DEVICES, AND EQUIPMENT SHOWN ON THE ELECTRICAL CONSTRUCTION DOCUMENTS WITH ARCHITECTURAL, MECHANICAL AND PLUMBING DRAWINGS PRIOR TO FINAL PLACEMENT.
- DEFINITION OF TERMS
  - \* SHALL - ACTION THAT IS REQUIRED WITHOUT OPTION OR QUALIFICATION.
  - \* FURNISH - CONTRACTOR SHALL BE RESPONSIBLE FOR OBTAINING.
  - \* INSTALL - CONTRACTOR SHALL BE RESPONSIBLE FOR LABOR AND CONSTRUCTION EQUIPMENT NECESSARY TO SET IN PLACE, CONNECT, CALIBRATE AND TEST EQUIPMENT FURNISHED BY HIM OR OTHERS.
  - \* PROVIDE - CONTRACTOR SHALL FURNISH AND INSTALL

#### GENERAL POWER NOTES

- THE CIRCUITING OF ALL DEVICES HAS BEEN SHOWN ON THE PLANS, AND THE CONTRACTOR SHALL FOLLOW THIS CIRCUITING LAYOUT.
- VERIFY EXACT LOCATIONS OF HVAC AND PLUMBING EQUIPMENT WITH THE GENERAL CONTRACTOR AND ASSOCIATED SUB CONTRACTORS. COORDINATE CONDUIT STUB-UP AND POWER CONNECTIONS PRIOR TO COMMENCING ROUGH-IN WORK. ELECTRICAL DEVICES (DISCONNECTS, RECEPTACLES, ETC.) INSTALLED ON EQUIPMENT SHALL BE MOUNTED ON A NON-REMOVABLE PANEL OF THE EQUIPMENT. FIELD COORDINATE EXACT DEVICE MOUNTING LOCATIONS PRIOR TO INSTALLATION.
- WALL MOUNTED HVAC CONTROL DEVICES (THERMOSTATS, TEMPERATURE SENSORS, HUMIDISTATS, CO, SENSORS, ETC) SHALL BE PROVIDED BY MECHANICAL CONTRACTOR. UNLESS NOTED OTHERWISE, ELECTRICAL CONTRACTOR SHALL PROVIDE SINGLE GANNE WALL BOX AT 46" AFF AND 1/2" CONDUIT STUBBED OUT TO ABOVE ACCESSIBLE CEILING WITH NYLON BUSHINGS AND PULLSTRING IN RACEWAY. REFER TO MECHANICAL DRAWINGS FOR LOCATIONS OF DEVICES.

#### GENERAL LIGHTING NOTES

- THE CIRCUITING OF ALL LUMINAIRES HAS BEEN SHOWN ON THE PLANS, AND THE CONTRACTOR SHALL FOLLOW THIS CIRCUITING LAYOUT.
- CIRCUIT ALL EMERGENCY LIGHTS, NIGHT LIGHTS AND EXIT LIGHTS TO AN UNSWITCHED HOT CONDUCTOR, UPSTREAM OF ALL CONTROLS.

#### ELECTRICAL POWER DISTRIBUTION ONE-LINE DIAGRAM

NO SCALE

FEEDER #	FEEDER DESCRIPTION
1	(6) PARALLEL 4" CONDUITS, EACH WITH (4) #400KCM
2	(3) #6, #10G, 1°C
3	(4) #1, #6G, 1-1/2"

NOTES:  
 1. ALL CONDUCTOR SIZES ARE BASED ON COPPER CONDUCTORS, WITH THHN/THWN-2 INSULATION.

LIGHT FIXTURE SCHEDULE								
MARK	MANUFACTURER	MODEL NUMBER	LAMP DATA	DRIVER	MOUNTING	FINISH	DESCRIPTION	NOTES
A	DAY-BRITE	FFS455L840-UNV-DIM-PAF	42W LED 5500 LUMEN	0-10V DIMMING	SUSPENDED TO 8'-6" AFF	WHITE	4' STRIP LIGHT WITH FROSTED ACRYLIC DIFFUSING LENS, WIDE DISTRIBUTION, ALL PARTS PAINTED AFTER FABRICATION	1
B	DAY-BRITE	DWPE43L840-4-UNV	38W LED 4400 LUMEN	0-10V DIMMING	SURFACE	WHITE	4' INDUSTRIAL VAPORTIGHT, FIBERGLASS BODY, POLYCARBONATE LENS	2
GENERAL:								
• All LED's shall be 4000 K correlated color temperature, minimum 80 CRI.								
• All light fixtures shall be provided with universal drivers capable of operating at 120V or 277V UNO.								
NOTES:								
1. Suspend fixture with aircraft cable to height indicated.								
2. U.L. listed for 'wet location'								


DRY-TYPE TRANSFORMER SCHEDULE								
Tag	KVA Size	Equipment Served	Primary Voltage	Secondary Voltage	Secondary Feeder Size	Grounding Electrode Conductor Size	Remarks	
T01	30	PANEL 'L01'	480V-3Φ,3W	208Y/120V-3Φ,4W	SEE ONE-LINE DIAGRAM	#6	1	
T71	30	PANEL 'L71'	480V-3Φ,3W	208Y/120V-3Φ,4W	SEE ONE-LINE DIAGRAM	#6	1	
GENERAL NOTES:								
• All conductor sizes based on copper								
• Maximum length of secondary conductors shall not exceed 25'-0" per NEC 240.21(C)(6).								
• Bond grounding electrode conductor to nearest available grounding electrode per NEC 250.30(A)(7).								
REMARKS:								
(1) Mount transformer on 3-1/2" high concrete housekeeping pad.								

Designation: H71		Manufacturer: Square D 'NF'						
Location: Penthouse		Bus Amps: 125						
Voltage: 480Y/277V-3Ph-4W		MCB Amps: MLO						
Enclosure: NEMA 1		AIC Rating: 14 kAIC						
Mounting: Surface		Other: Integral Surge Protection						
Circuit #	Load Description	Conductors	C/B Size	C/B Size	Conductors	Load Description	Circuit #	
1	ELEVATOR #1	3#6, #10G, 1°C	50 / 3	50 / 3	SEE ONE-LINE DIAGRAM	TRANSFORMER 'T71' (PANEL 'L71')	2	
3							4	
5							6	
7	SPACE ONLY	---	---	20 / 1	2#12, #12G, 1/2°C	LTC: ELEC & STORAGE RMS	8	
9	SPACE ONLY	---	---	---	---	SPACE ONLY	10	
11	SPACE ONLY	---	---	---	---	SPACE ONLY	12	
13	SPACE ONLY	---	---	---	---	SPACE ONLY	14	
15	SPACE ONLY	---	---	---	---	SPACE ONLY	16	
17	SPACE ONLY	---	---	---	---	SPACE ONLY	18	
19	SPACE ONLY	---	---	---	---	SPACE ONLY	20	
21	SPACE ONLY	---	---	---	---	SPACE ONLY	22	
23	SPACE ONLY	---	---	---	---	SPACE ONLY	24	
25	SPACE ONLY	---	---	---	---	SPACE ONLY	26	
27	SPACE ONLY	---	---	---	---	SPACE ONLY	28	
29	SPACE ONLY	---	---	---	---	SPACE ONLY	30	

Designation: L71		Manufacturer: Square D 'NQ'						
Location: Penthouse		Bus Amps: 100						
Voltage: 208Y/120V-3Ph-4W		MCB Amps: 100/3						
Enclosure: NEMA 1		AIC Rating: 10 kAIC						
Mounting: Surface		Other: Integral Surge Protection						
Circuit #	Load Description	Conductors	C/B Size	C/B Size	Conductors	Load Description	Circuit #	
1	SPARE BREAKER	---	20 / 1	20 / 1	2#12, #12G, 1/2°C	RCPTS: STORAGE ROOM	2	3
3	ELEVATOR CAB LTS/CONTROL	2#12, #12G, 1/2°C	20 / 1	20 / 1	2#12, #12G, 1/2°C	RCPTS: STORAGE ROOM	4	
5	RCPT: ELEVATOR EQPM RM	2#12, #12G, 1/2°C	20 / 1	20 / 1	---	SPARE BREAKER	6	
7	LTC: ELEVATOR EQPM RM	2#12, #12G, 1/2°C	20 / 1	---	---	SPACE ONLY	8	
9	SPACE ONLY	---	---	---	---	SPACE ONLY	10	
11	SPACE ONLY	---	---	---	---	SPACE ONLY	12	
13	SPACE ONLY	---	---	---	---	SPACE ONLY	14	
15	SPACE ONLY	---	---	---	---	SPACE ONLY	16	
17	SPACE ONLY	---	---	---	---	SPACE ONLY	18	
19	SPACE ONLY	---	---	---	---	SPACE ONLY	20	
21	SPACE ONLY	---	---	---	---	SPACE ONLY	22	
23	SPACE ONLY	---	---	---	---	SPACE ONLY	24	
25	SPACE ONLY	---	---	---	---	SPACE ONLY	26	
27	SPACE ONLY	---	---	---	---	SPACE ONLY	28	
29	SPACE ONLY	---	---	---	---	SPACE ONLY	30	

CIRCUIT BREAKER SWITCHBOARD SCHEDULE								
Designation:	Equipment Served	Feeder Size	C/B Size	Remarks				
SES	NEMA 1	Bus Amps: 2000						
	Location: Basement	Mounting: Floor	MCB Amps: 2000/3 w/ GFPE					
	Voltage: 480Y/277V-3Ph-4W	Manufacturer: Square D 'QED'	AIC Rating: 65 kAIC					
Circuit #	Equipment Served	Feeder Size	C/B Size	Notes:				
1	Transformer 'T01' (Panel 'L01')	SEE ONE-LINE DIAGRAM	50/3					
2	Panel 'H71'	SEE ONE-LINE DIAGRAM	125/3					
3	250A Provisional Space	---	250A	See Note 3.				
4	400A Provisional Space	---	400A	See Note 4.				

Designation: L01	

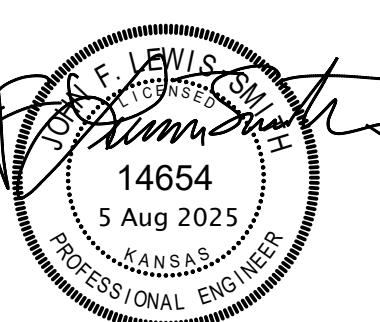

REVISION:  
 8-14-2025

DATE: 8-5-2025  
 JOB: 25-3499  
 SHEET NO.:

**① PLUMBING PLAN NOTES BY SYMBOL**

- ROUTE ELEVATOR SUMP PUMP DISCHARGE THROUGH BASEMENT AS HIGH AS POSSIBLE AND UP ALONG EXTERIOR WALL. FIELD COORDINATE EXACT ROUTING WITH EXISTING CONDITIONS AND ELEVATOR EQUIPMENT SUPPLIER.
- ROUTE PIPING UP THROUGH FLOOR IN CORNER AND PENETRATE EXTERIOR WALL 18" A.F.G. AND TERMINATE WITH ELBOW DOWN ABOVE SPLASH BLOCK. COORDINATE EXACT ROUTING WITH OWNER PRIOR TO ROUGH-IN. SEAL PIPE PENETRATIONS WEATHER TIGHT.
- ALL EXPOSED PIPING IN FINISHED SPACES SHALL BE COPPER. PROVIDE COPPER ESCUTCHEONS AT FLOOR AND WALL PENETRATIONS.
- PROVIDE SUMP PUMP IN PIT BY OTHERS. SEE DETAIL P1.1.
- ELEVATOR SUMP PUMP CONTROL PANEL. FIELD COORDINATE LOCATION AND REQUIREMENTS WITH E.C.

